PARENT PARCEL: 12-00-050-000-032, -033 & 12-00-051-000-070, -071

CHILD PARCEL: 12-00-050-000-034, -035 & 12-00-051-000-076, -077

STARTING POINT: AC CORR PER SURV BY JOSEPH A. BURGOON

22-04588

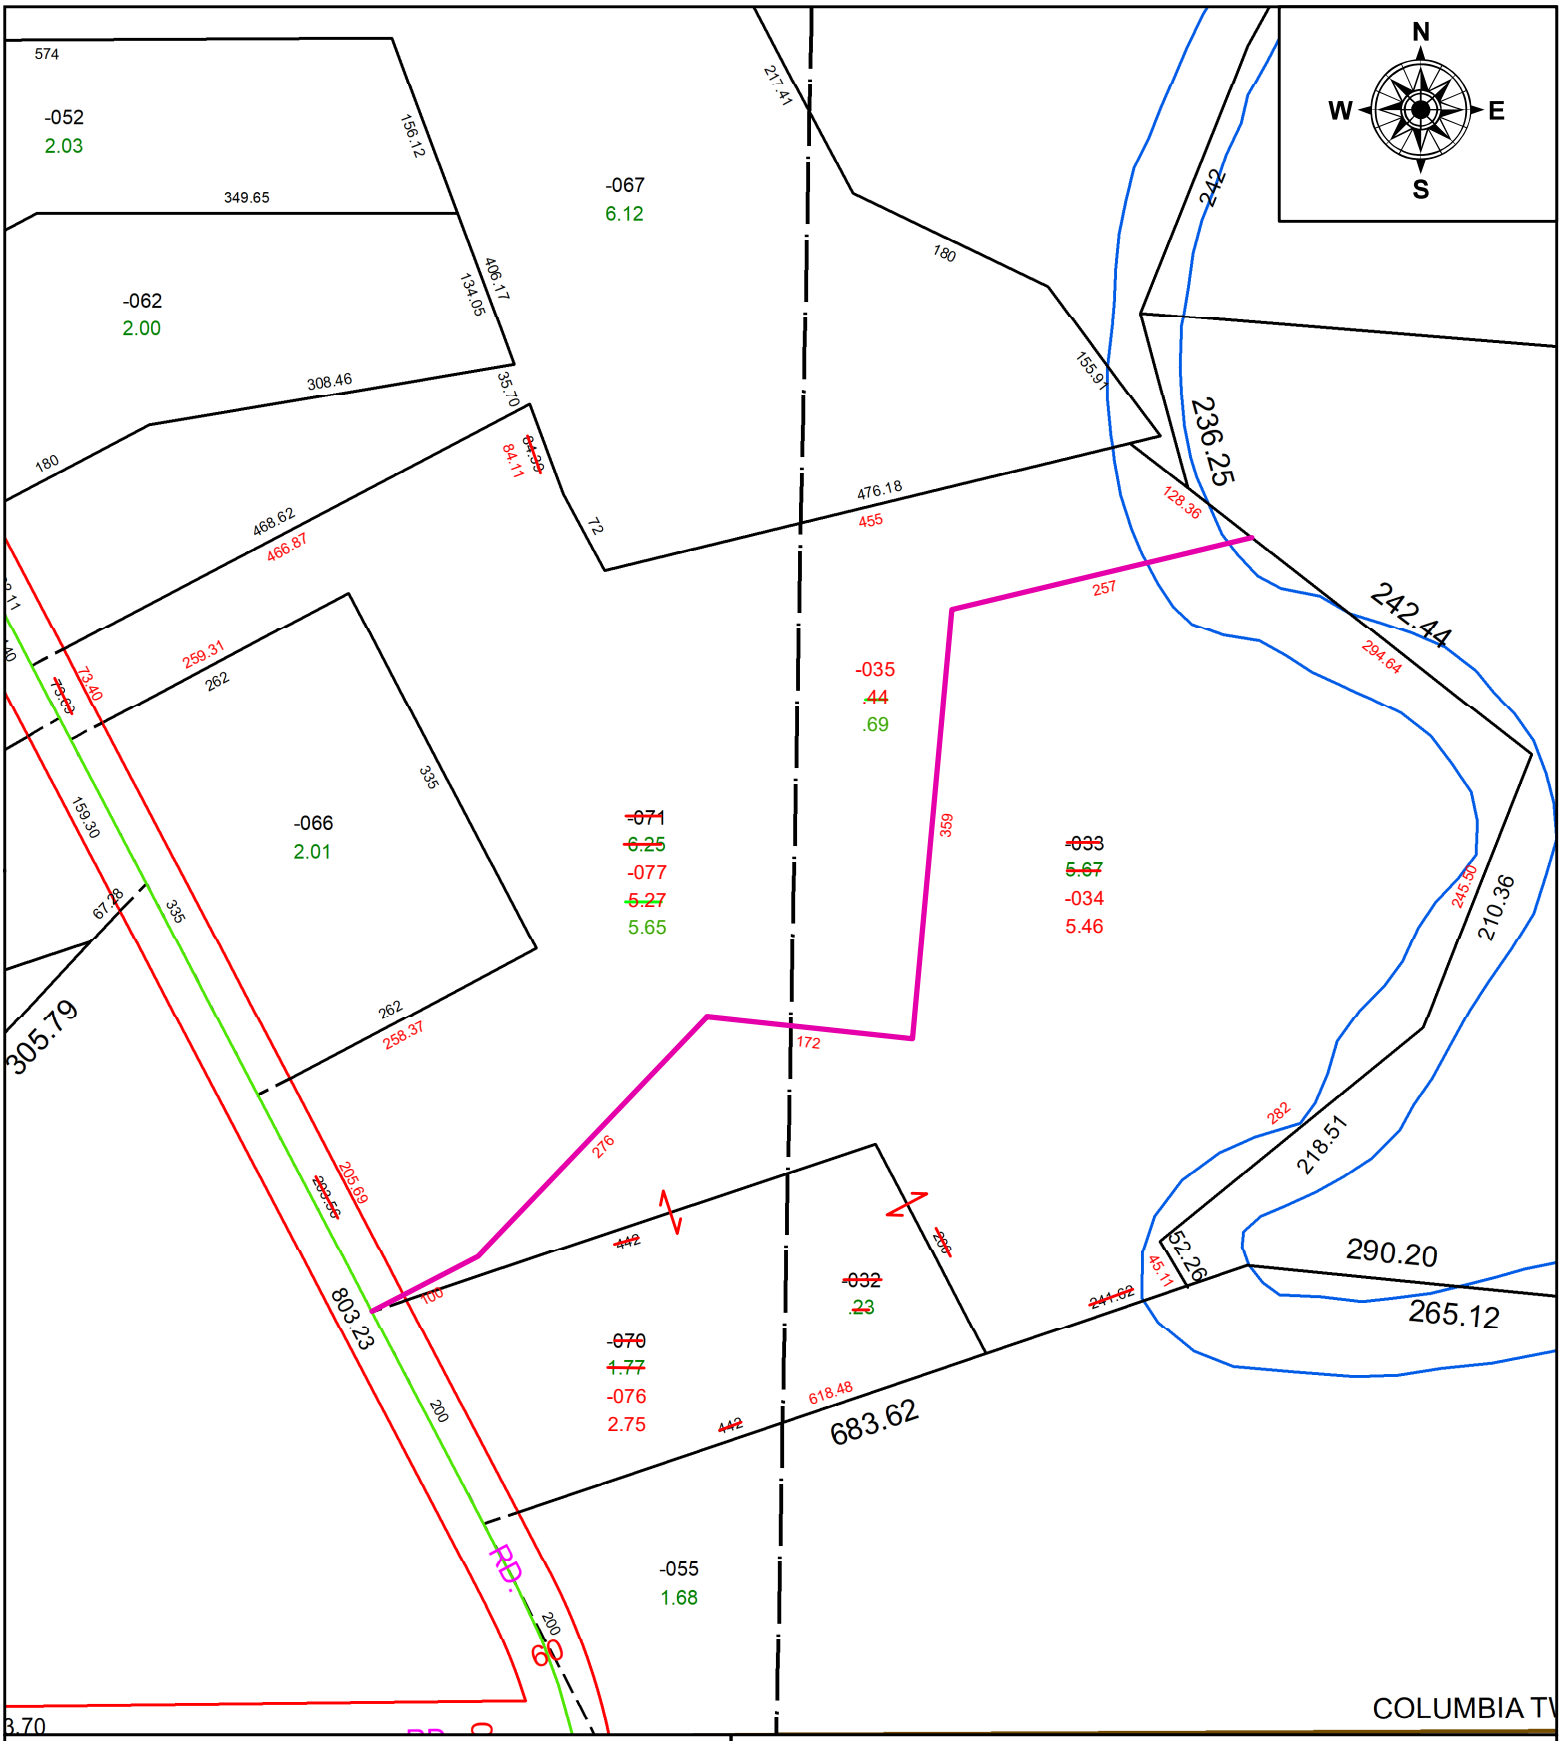

SPLITS/DEEDS PROCESSED

LORAIN COUNTY TAX MAP DEPARTMENT
226 MIDDLE AVE. ELYRIA, OH

SURVEYED BY: JOSEPH A. BURGOON **SURV # 50749**

CLOSURE: 1: 701279

MAP PAGE(S): 12-00-051-B

APPOVED BY: AC **DATE:** December 07, 2022

SCALE: 1 in = 160 ft **PRIOR INSTRUMENT:** 2013- 0452840