PARENT PARCEL: 06-25-014-111-028 & -029

CHILD PARCEL: 06-25-014-111-030 & 06-25-006-109-043

STARTING POINT: FRONT & DEPTH TO AC CORR PER SURV BY THOMAS A. SIMON

22-04598

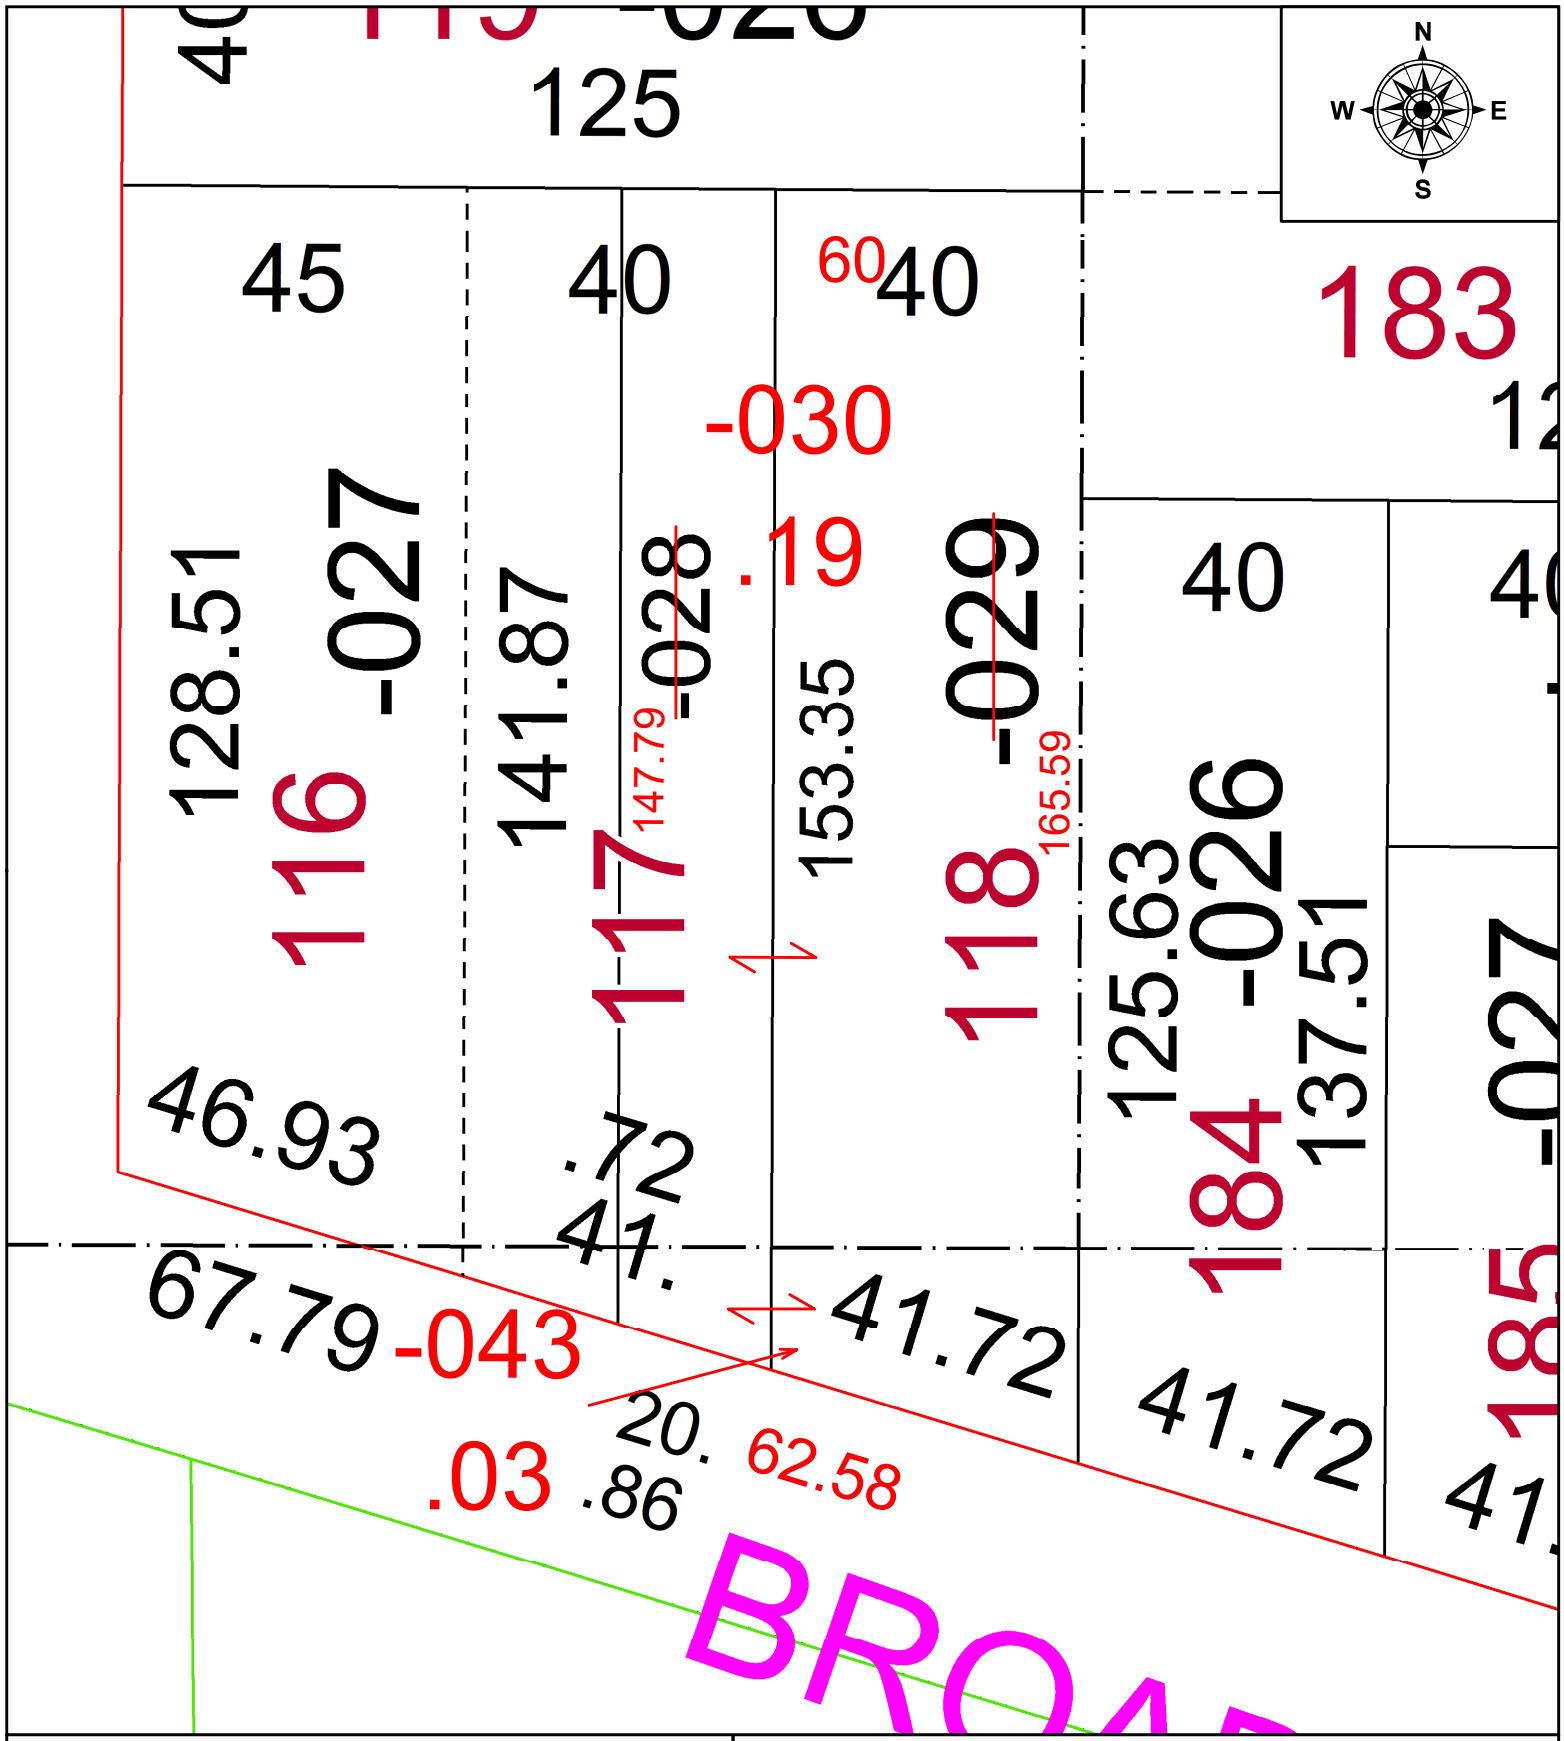

SPLITS/DEEDS PROCESSED

LORAIN COUNTY TAX MAP DEPARTMENT
226 MIDDLE AVE. ELYRIA, OH

SURVEYED BY: THOMAS A. SIMON **SURV # 50760**

CLOSURE: 1: 132342

MAP PAGE(S): 06-123

APPOVED BY: AC **DATE:** December 15, 2022

SCALE: 1 in = 25 ft **PRIOR INSTRUMENT:** 2017- 0642023