PARENT PARCEL: 11-00-009-101-021 & -034
CHILD PARCEL: 11-00-009-101-035, -036, & -037
STARTING POINT: AC CORR PER SURV BY ANDREW G. PLANET

22-04599

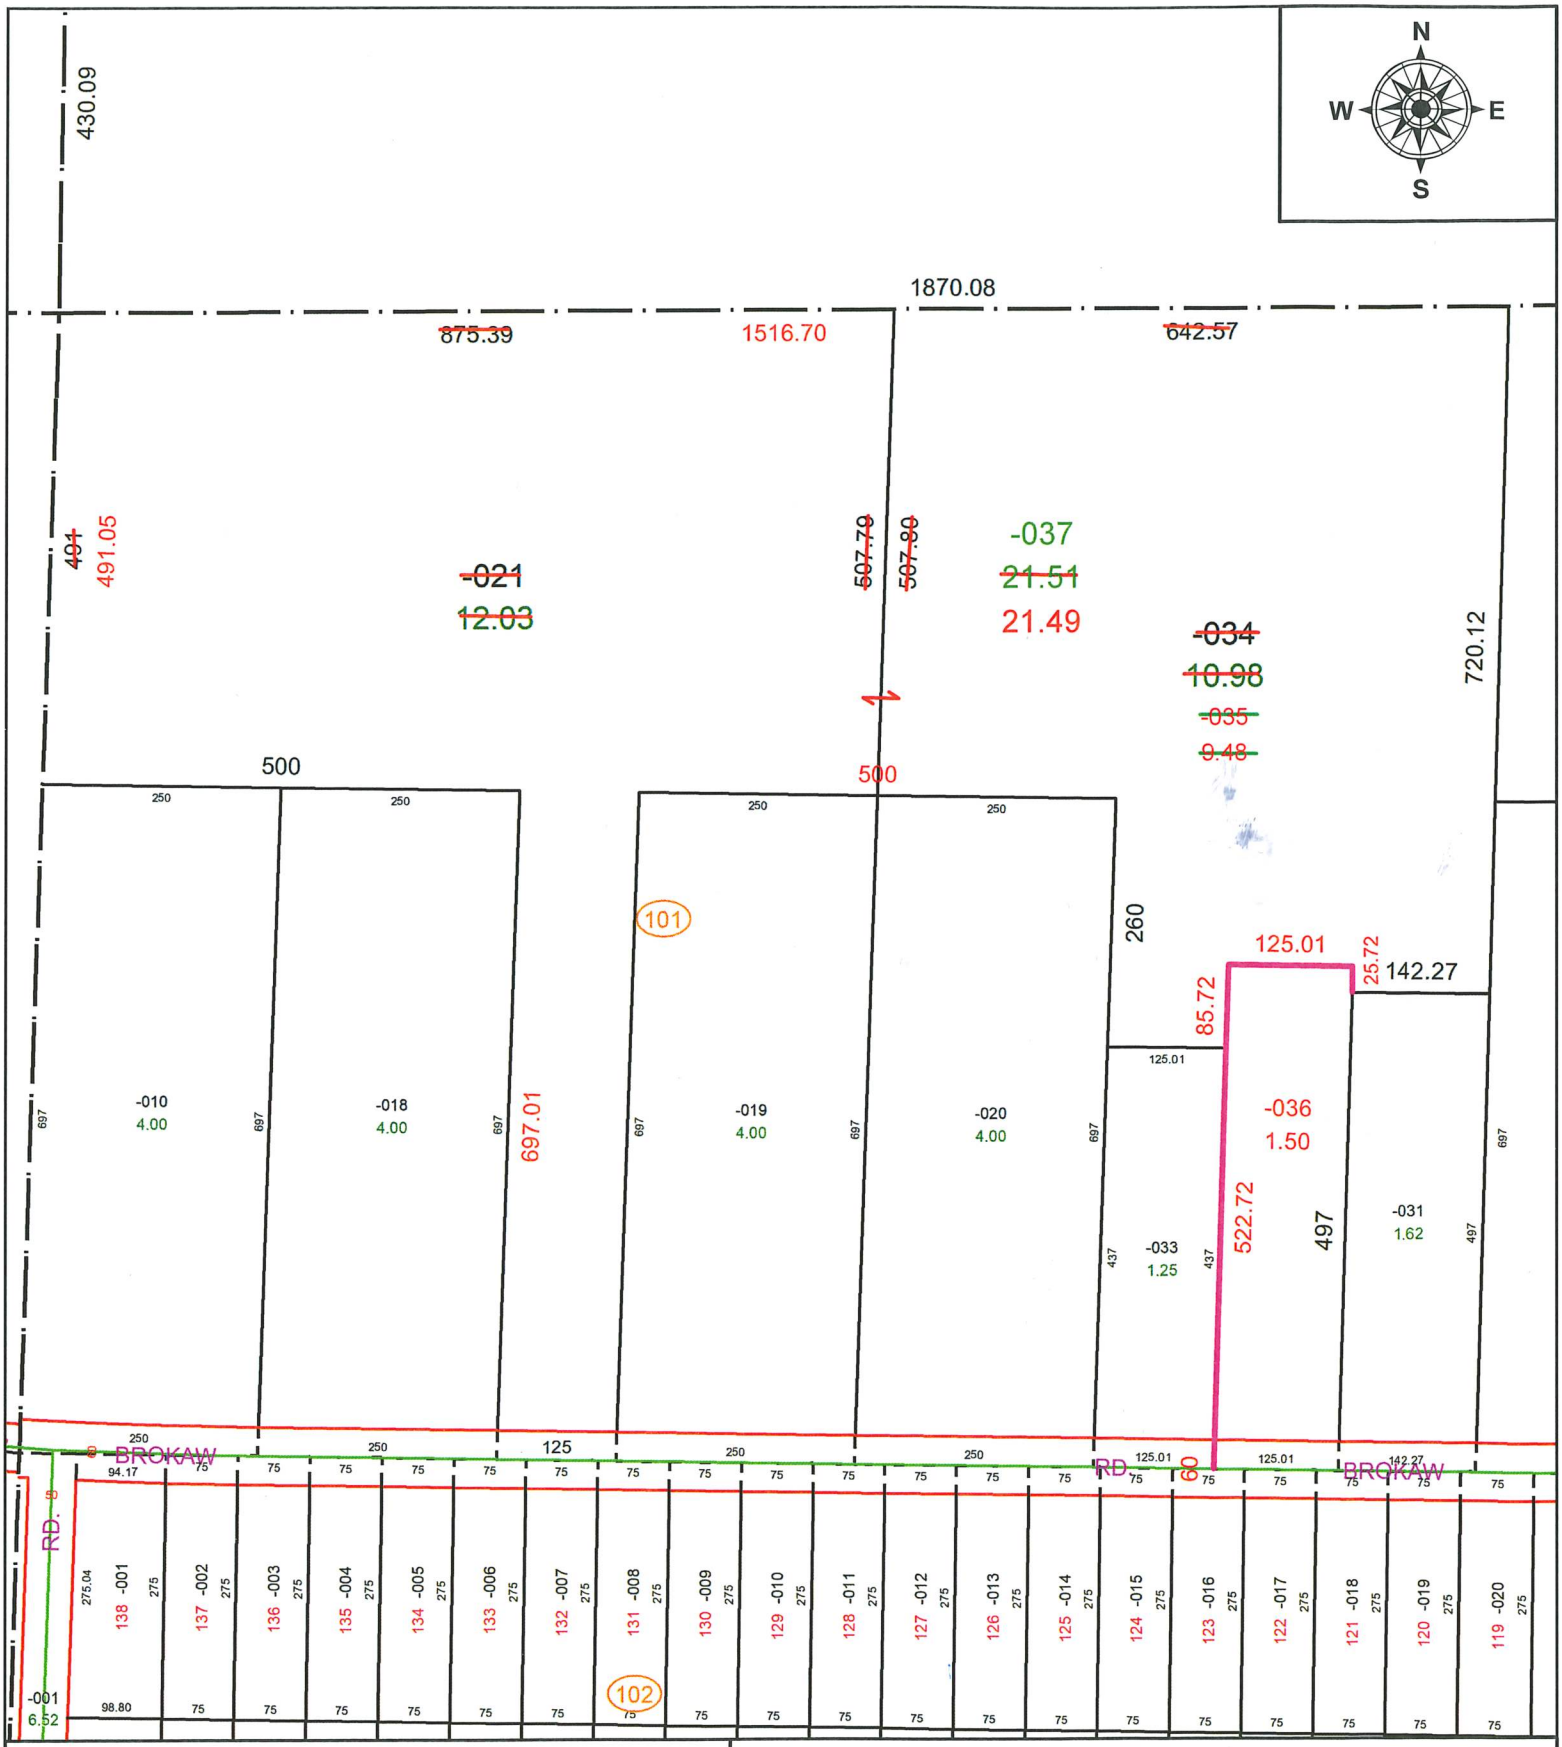

SPLITS/DEEDS PROCESSED

LORAIN COUNTY TAX MAP DEPARTMENT
226 MIDDLE AVE. ELYRIA, OH

SURVEYED BY: ANDREW G, PLANET SURV # 50762
CLOSURE: 1: 2147483648
MAP PAGE(S): 11-00-009-A
APPOVED BY: AC DATE: December 16, 2022
SCALE: 1 in = 200 ft PRIOR INSTRUMENT: 2019- 0714206