PARENT PARCEL: 12-00-022-000-065

CHILD PARCEL: 12-00-022-000-098, -099, & -100 N/A

STARTING POINT: INTERSECTION OF C/LS OF SR 252 & REDFERN RD

23-04605

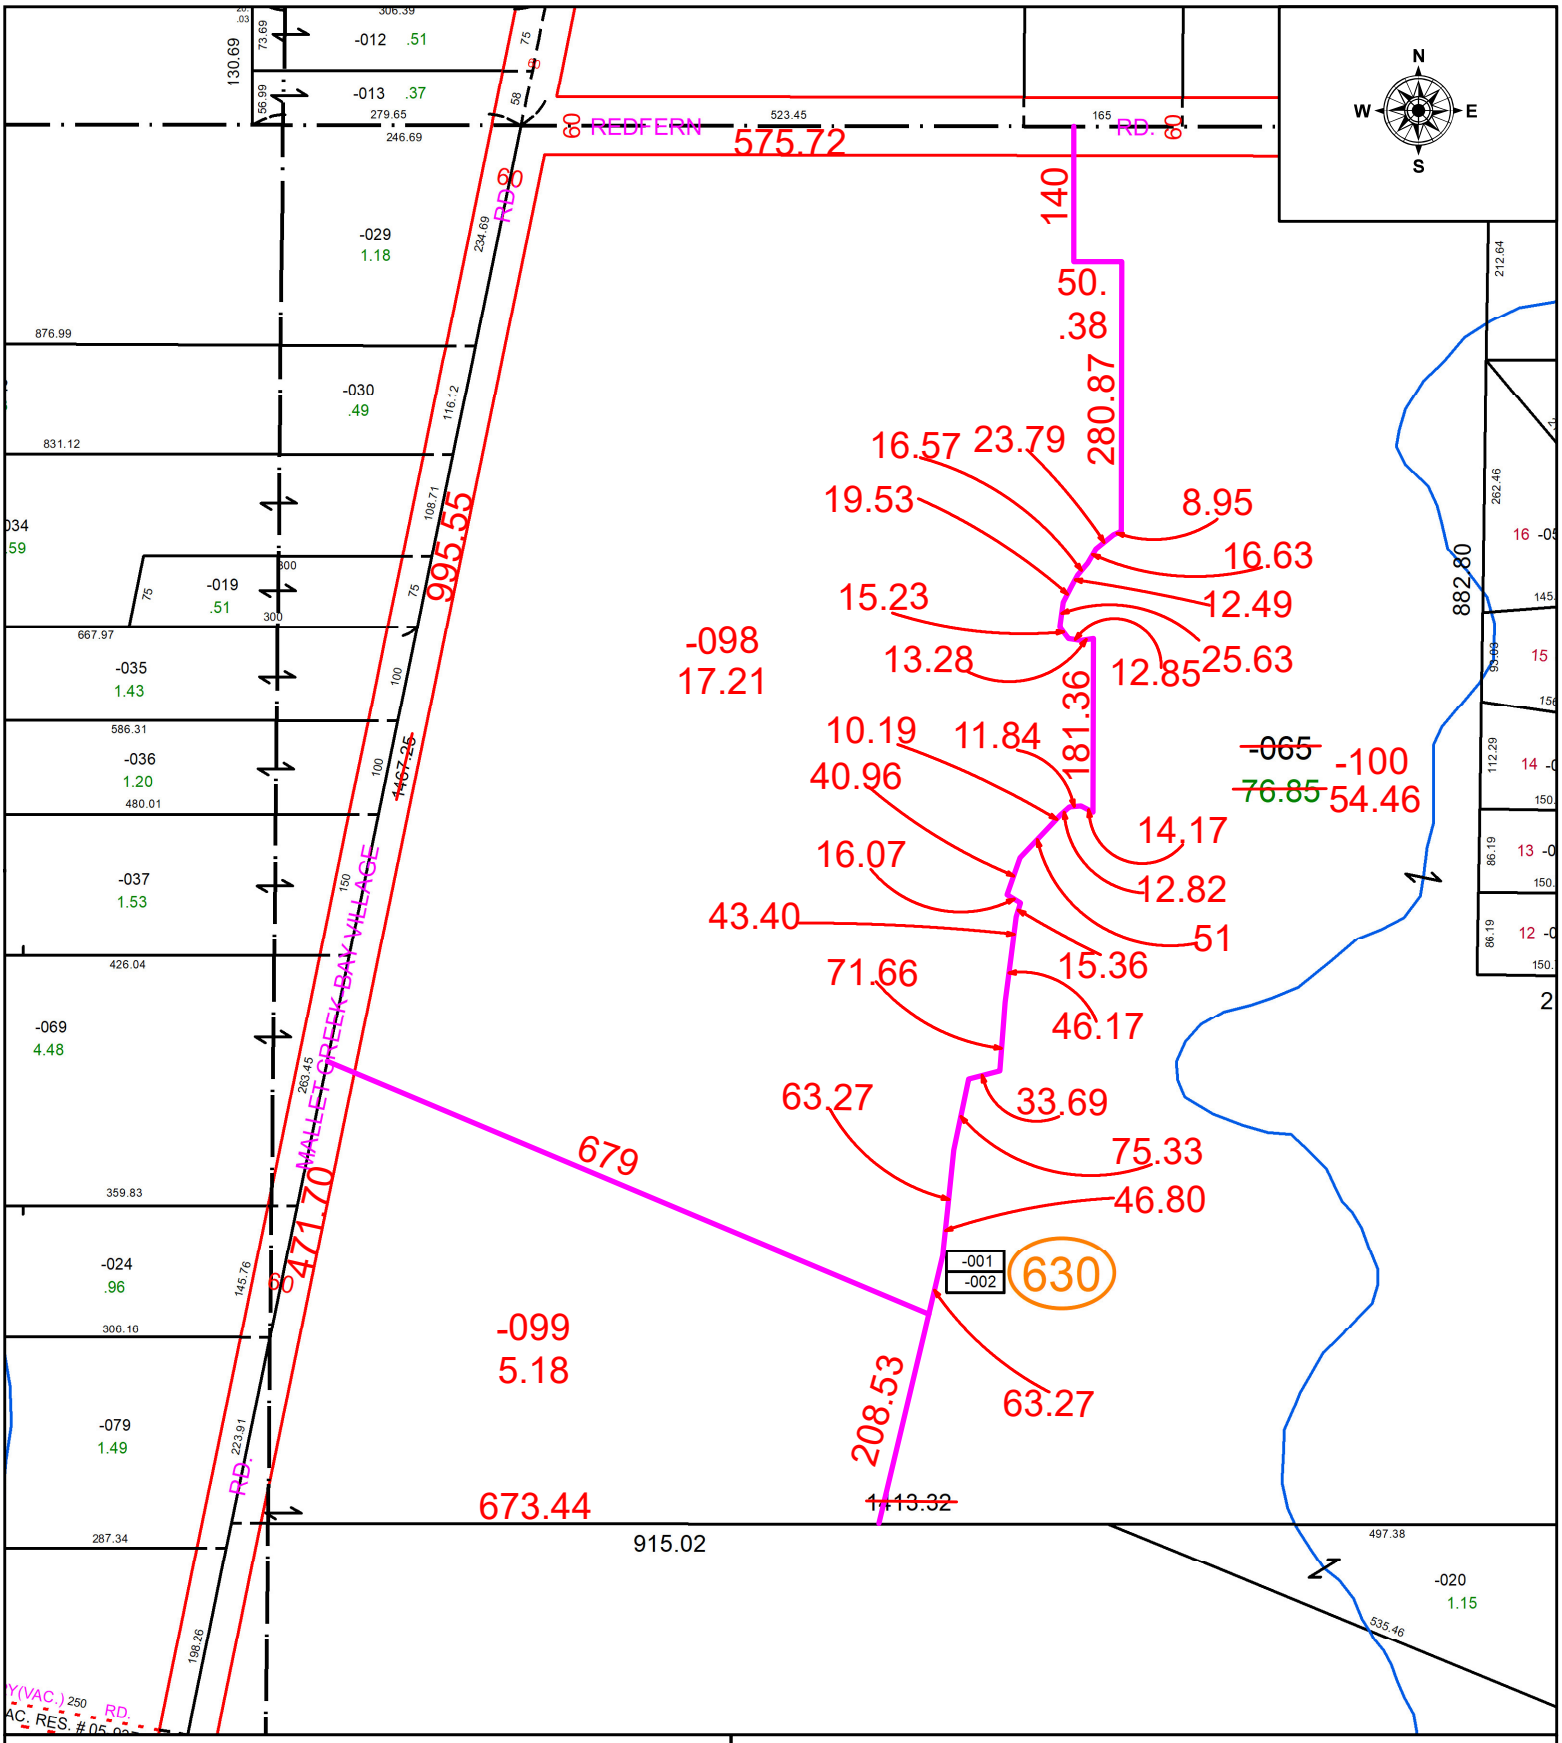

SPLITS/DEEDS PROCESSED

LORAIN COUNTY TAX MAP DEPARTMENT
226 MIDDLE AVE. ELYRIA, OH

SURVEYED BY: DALE HAYWOOD SURVEY # 50773
CLOSURE: 1: 167466
MAP PAGE(S): 12-00-022
APPOVED BY: WRZ **DATE:** 1/6/2023
SCALE: 1" = 200 **PRIOR INSTRUMENT:** #2014-0511080