PARENT PARCEL: 21-03-000-000-032
CHILD PARCEL: 21-03-000-000-124 & -125
STARTING POINT: AC CORR PER SURV BY JOHN A. DECHANT JR.

23-04606

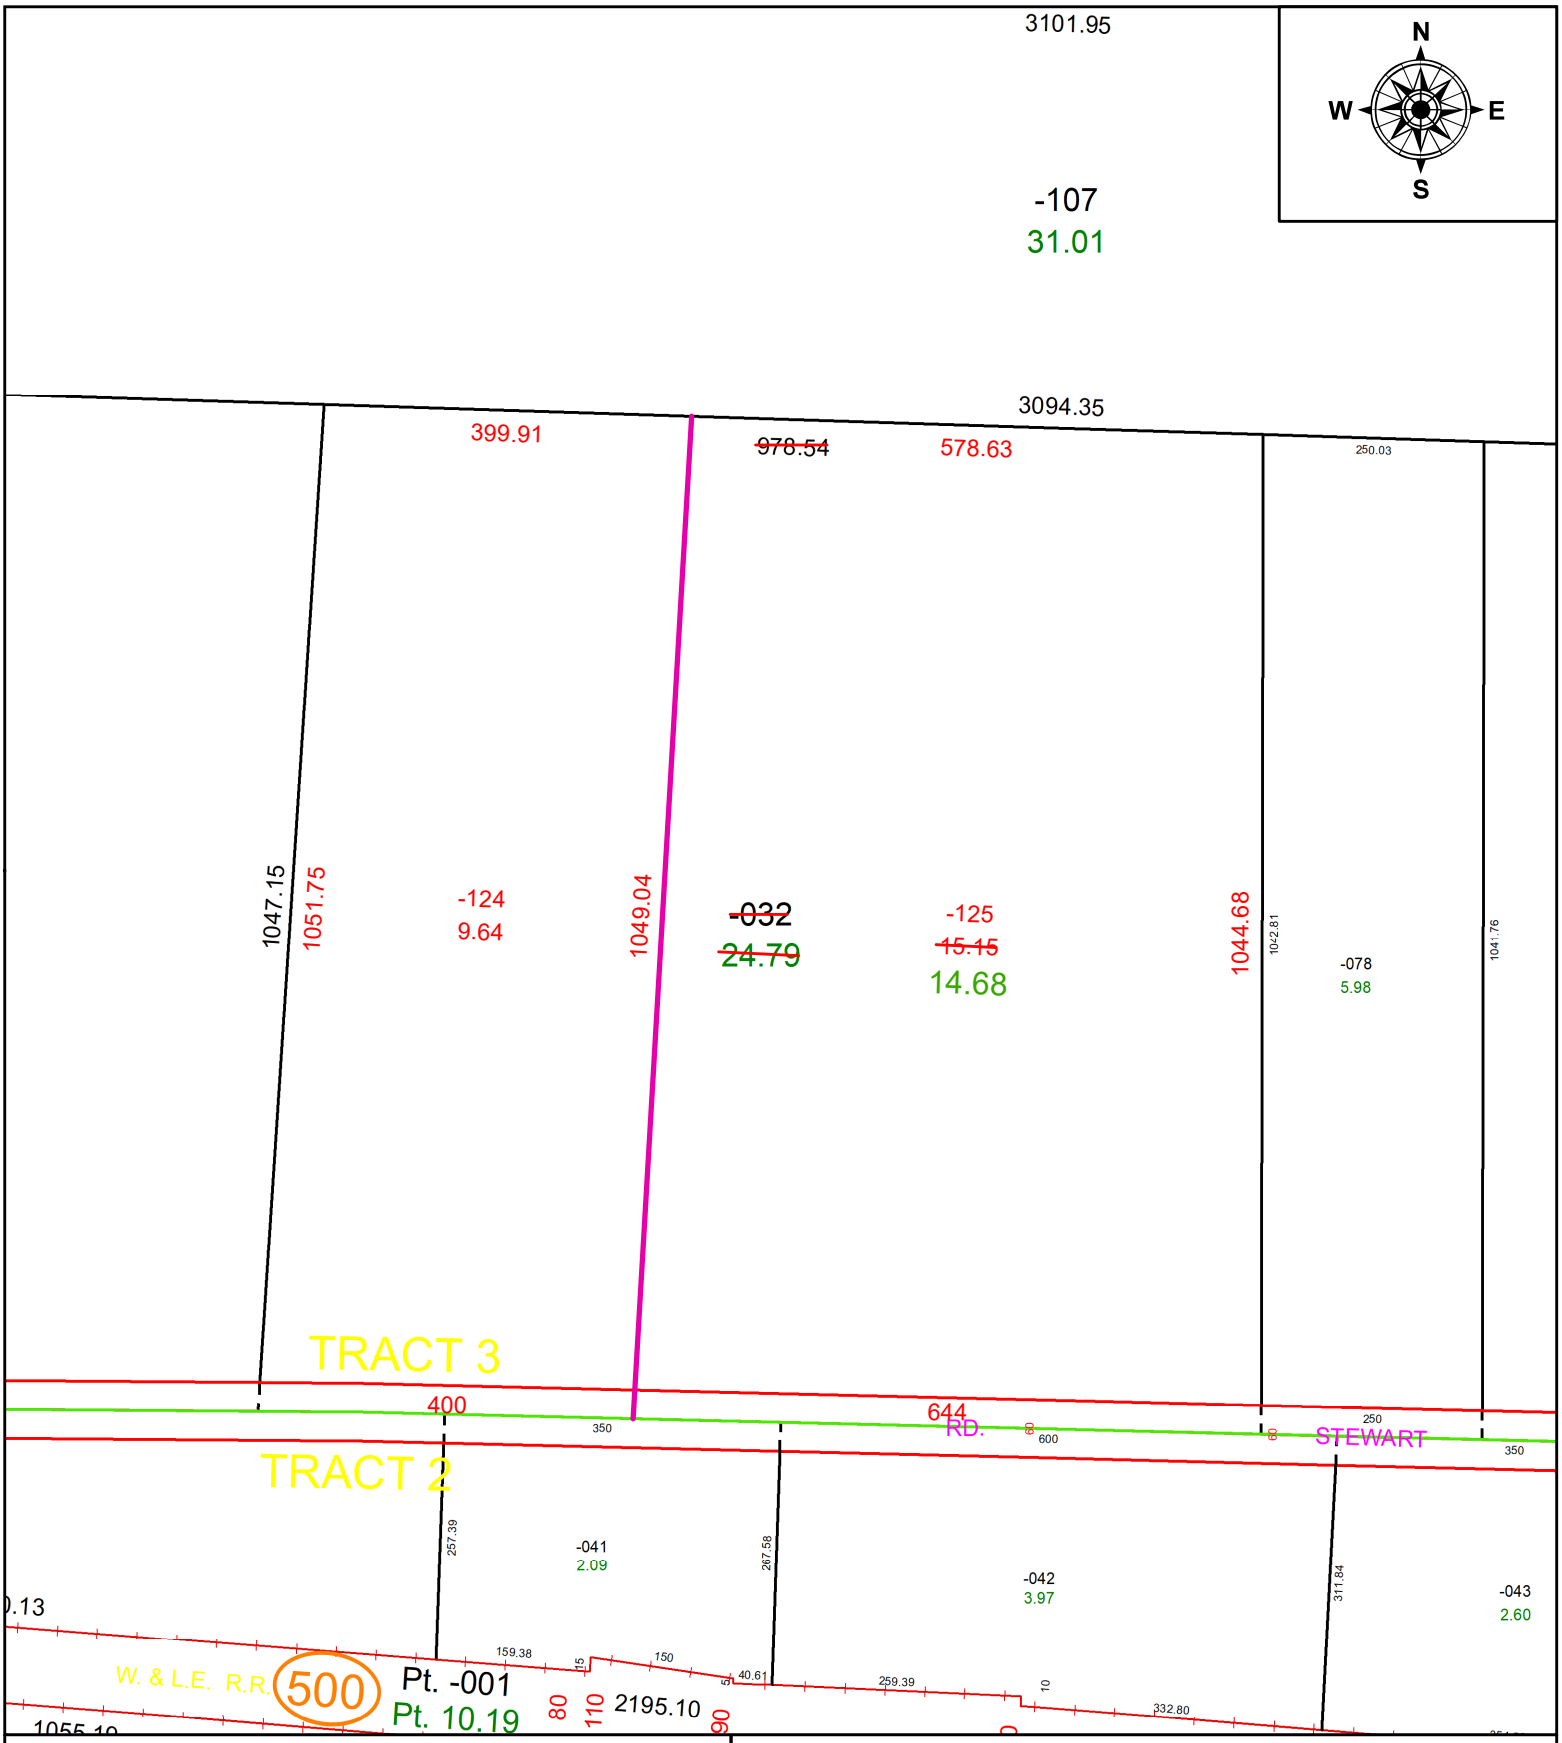

SPLITS/DEEDS PROCESSED

LORAIN COUNTY TAX MAP DEPARTMENT
226 MIDDLE AVE. ELYRIA, OH

SURVEYED BY: JOHN A. DECHANT JR **SURV # 50777**
CLOSURE: 1: 566191
MAP PAGE(S): 21-03-000
APPOVED BY: AC **DATE:** January 09, 2023
SCALE: 1 in = 200 ft **PRIOR INSTRUMENT:** DV 1102 PG 857