PARENT PARCEL: 07-00-021-115-039
CHILD PARCEL: FRONTAGE & DEPTH FROM 92.54 X 164.67 TO ACREAGE CORRECTION
STARTING POINT: NW CORNER OF SL 1

21-04607-C

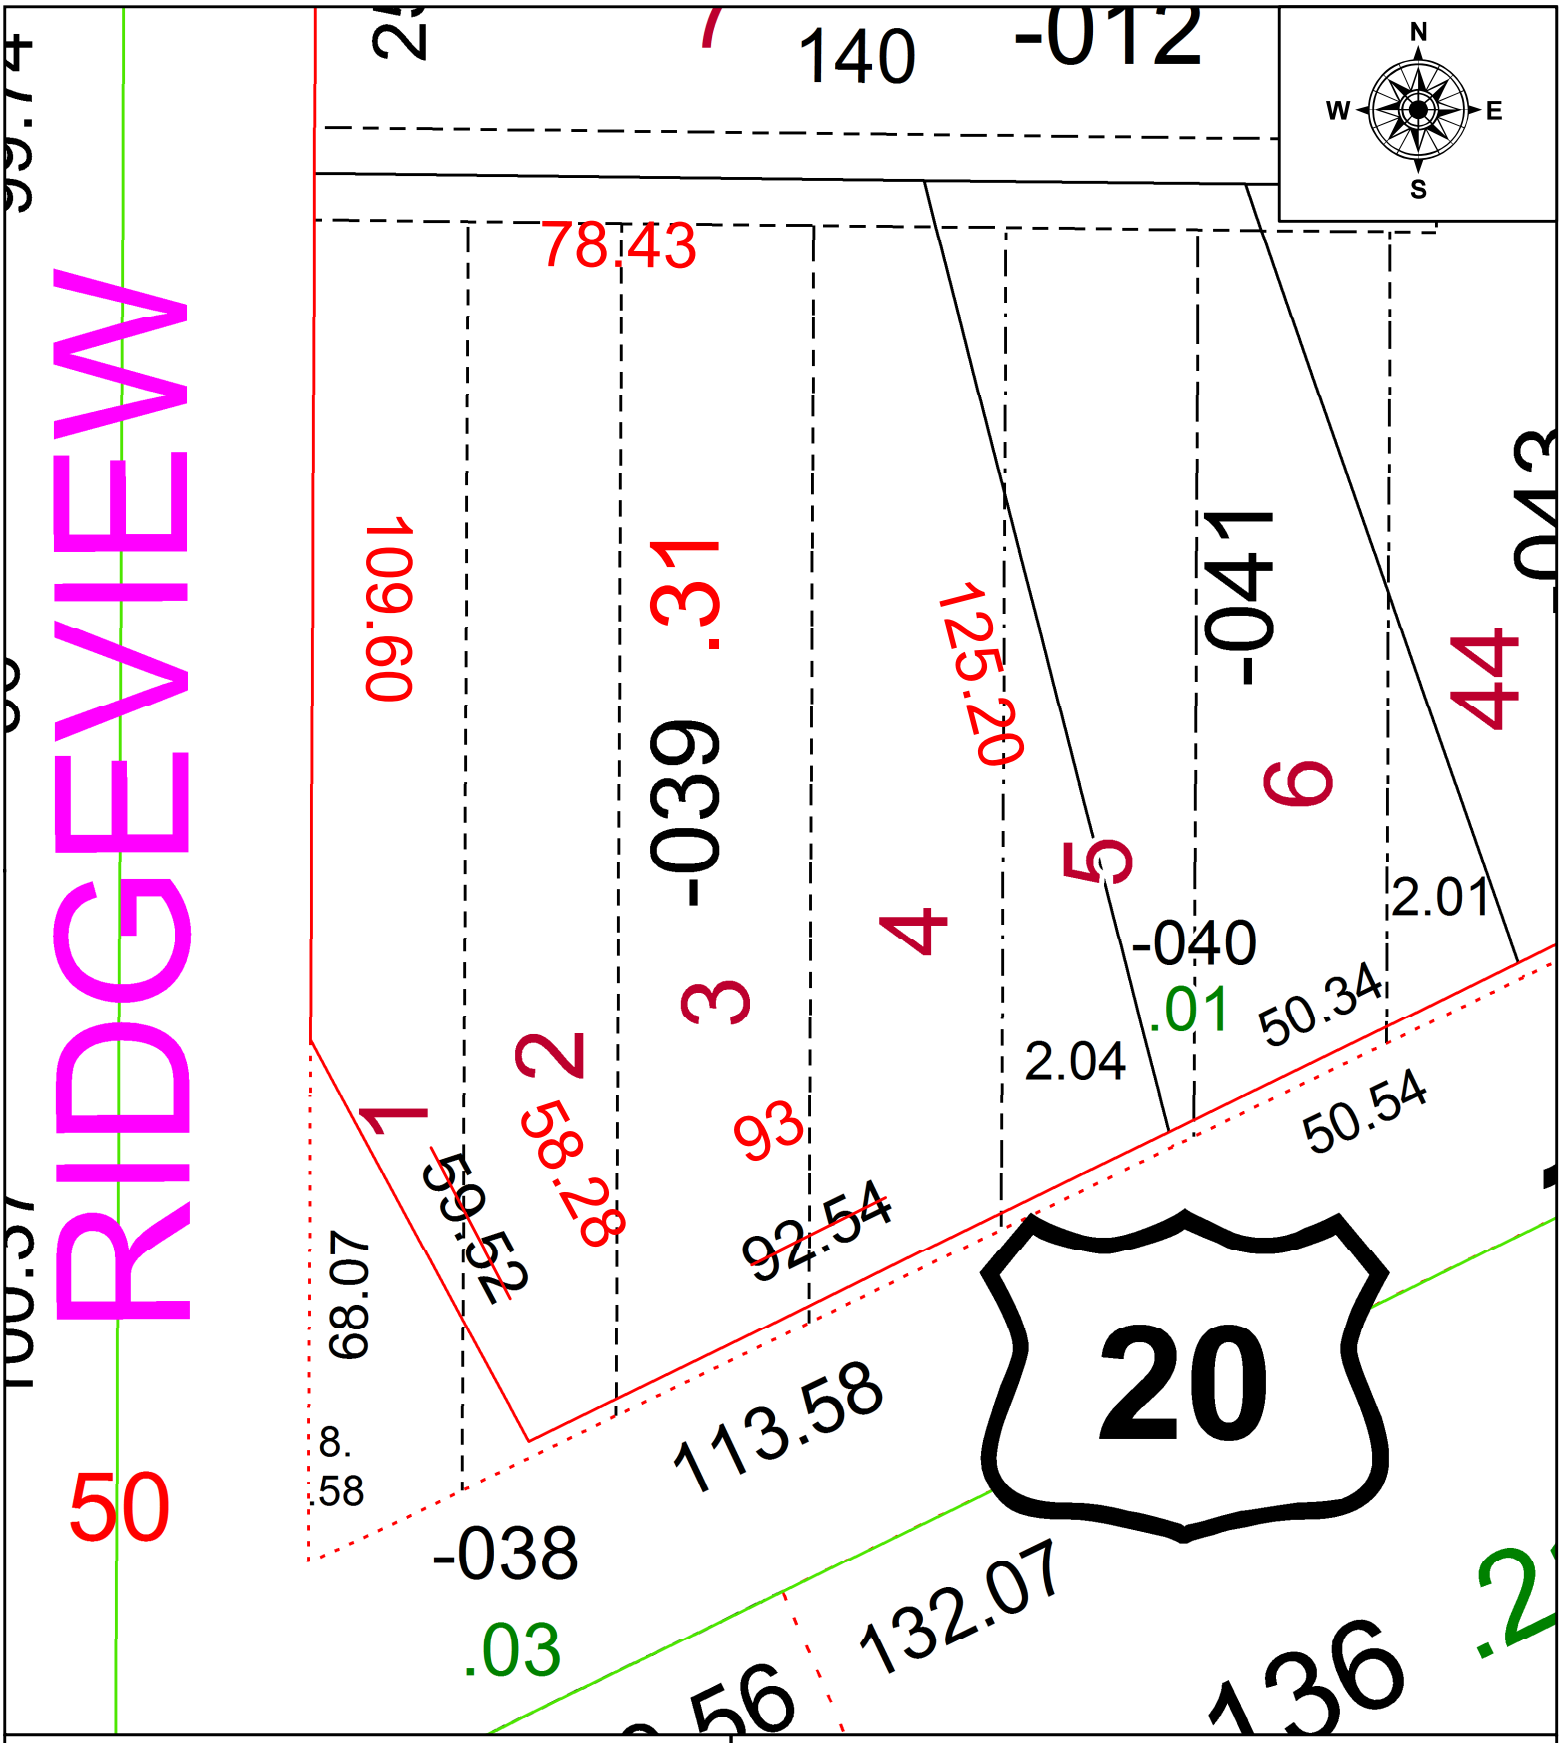

SPLITS/DEEDS PROCESSED
LORAIN COUNTY TAX MAP DEPARTMENT
226 MIDDLE AVE. ELYRIA, OH

SURVEYED BY: WILFREDO BARBOSA
CLOSURE: 1: 32202
MAP PAGE(S): 07-00-021-B
APPOVED BY: AC **DATE:** 7/15/2021
SCALE: 1" = 25 **PRIOR INSTRUMENT:** 2017- 0647643