PARENT PARCEL: 04-00-007-111-001, -002, -032, -034

CHILD PARCEL: 04-00-007-111-036, -037, -038

STARTING POINT: C/L OF MOORE RD ANDS LINE OF BEACH PARK ALLOTMENT

23-04609

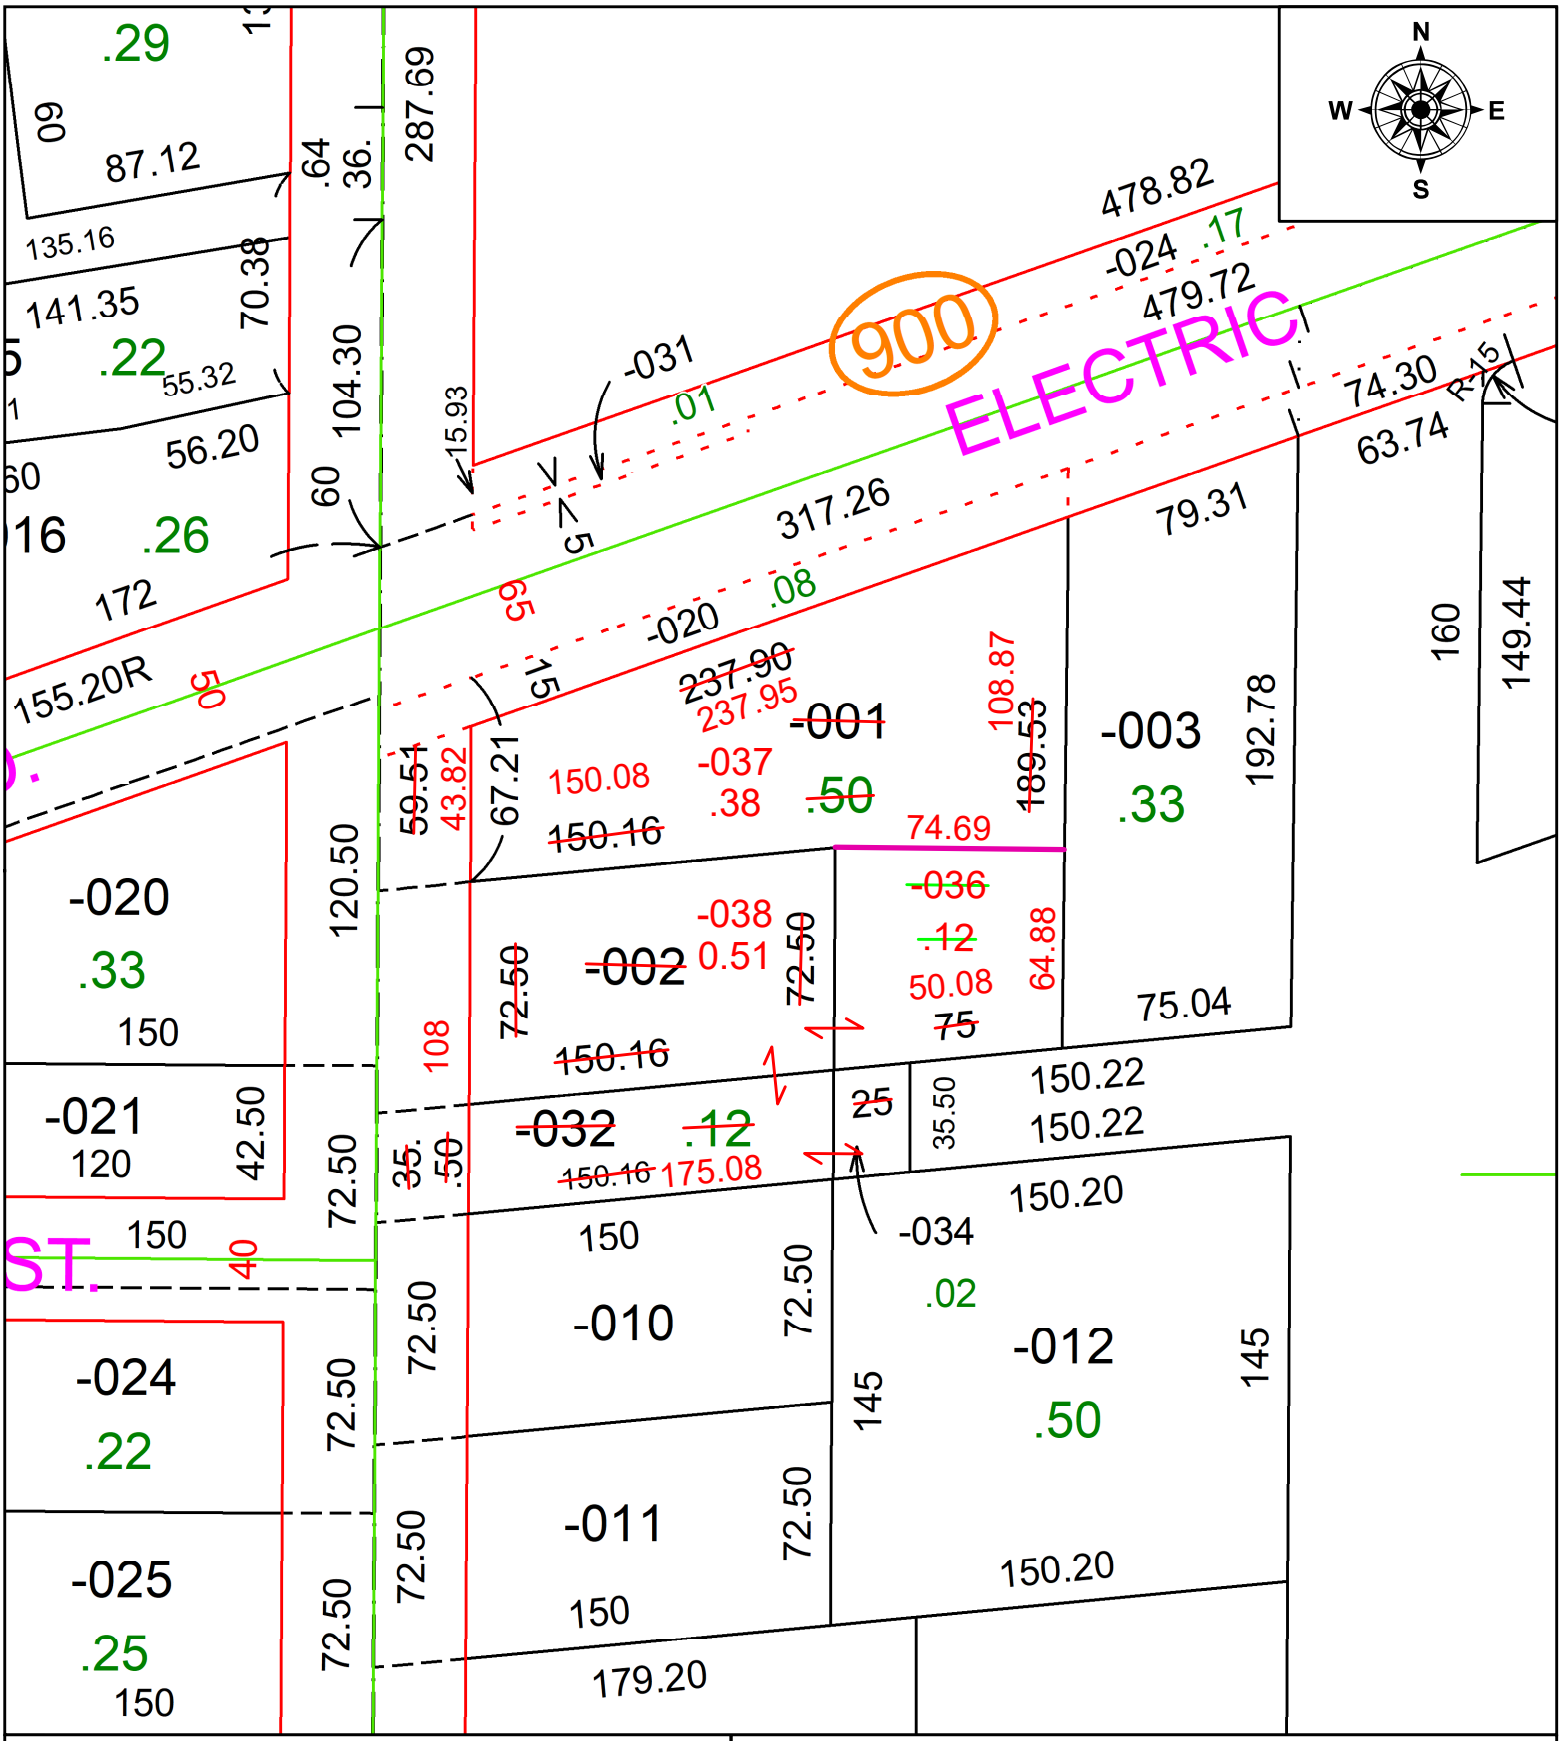

SPLITS/DEEDS PROCESSED

LORAIN COUNTY TAX MAP DEPARTMENT
226 MIDDLE AVE. ELYRIA, OH

SURVEYED BY: JAMES T. SAYLER **SURV # 50781**

CLOSURE: 1: 62475

MAP PAGE(S): 04-00-007-A

APPOVED BY: AC **DATE:** January 10, 2023

SCALE: 1 in = 62 ft **PRIOR INSTRUMENT:** 2022- 0889797