PARENT PARCEL: 09-00-095-102-048, -050 & -051
CHILD PARCEL: 09-00-095-102-053, -054 & -055
STARTING POINT: CL OF S. PROFESSOR ST. & NORTH LINE OF W. LINCOLN ST.

23-04611

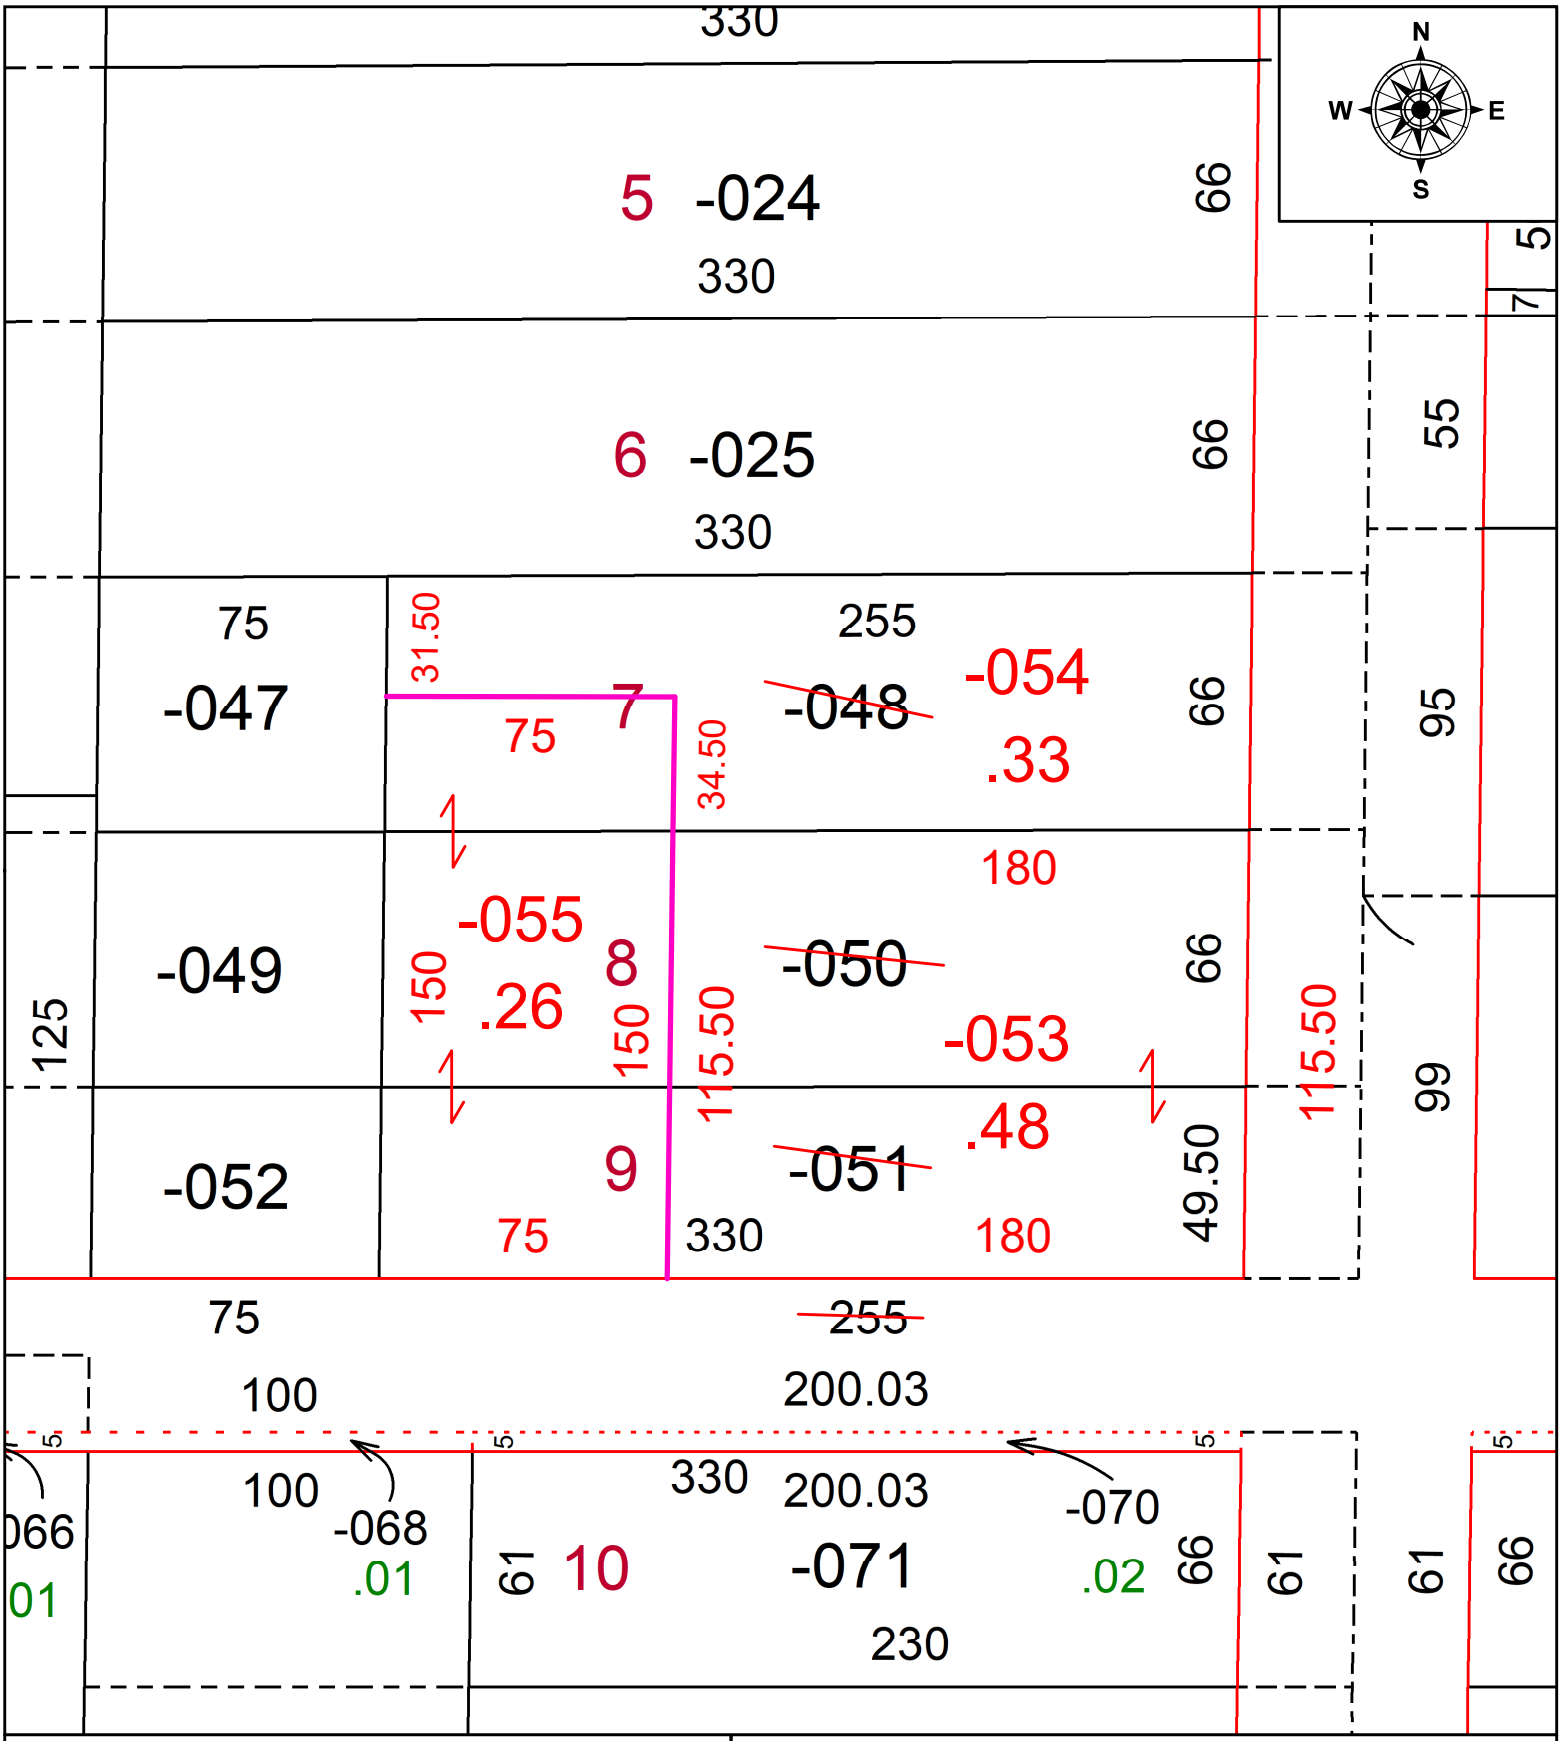

SPLITS/DEEDS PROCESSED
LORAIN COUNTY TAX MAP DEPARTMENT
226 MIDDLE AVE. ELYRIA, OH

SURVEYED BY: VINCENT McGERVEY **SURVEY #:** 50782
CLOSURE: 1:-2147483648
MAP PAGE(S): 09-00-095
APPOVED BY: DMA **DATE:** 1/12/2023
SCALE: 1" = 50' **PRIOR INSTRUMENT:** N/A