PARENT PARCEL: 04-00-007-105-054

CHILD PARCEL: Ac. Corr. per survey Patrick McGannon

STARTING POINT: CL OF LAKE RD. & MOORE RD.

21-04612-A

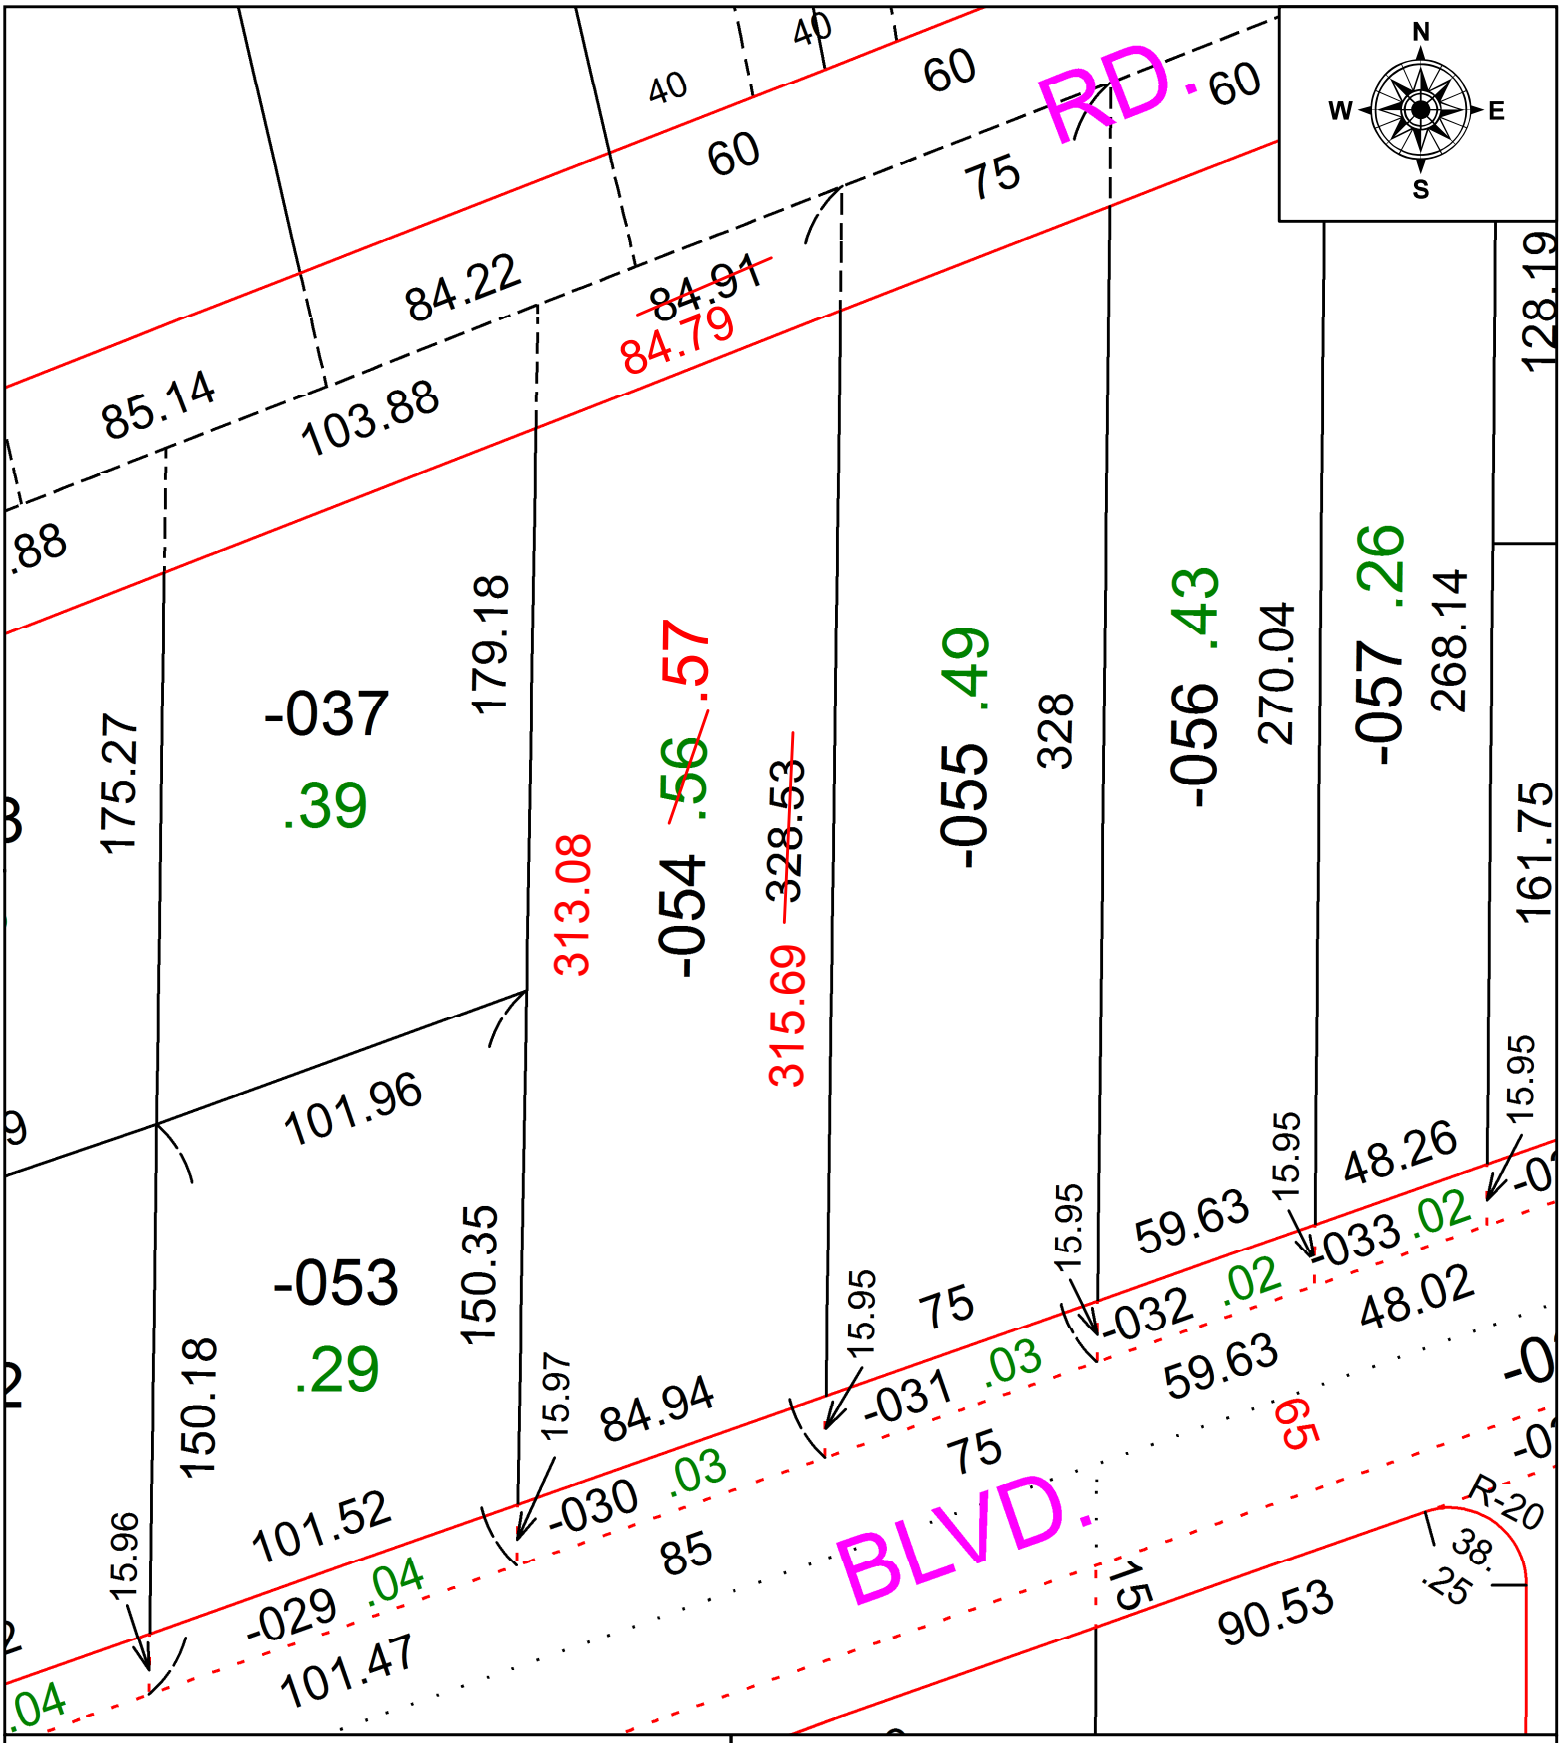

SPLITS/DEEDS PROCESSED

LORAIN COUNTY TAX MAP DEPARTMENT
226 MIDDLE AVE. ELYRIA, OH

SURVEYED BY: PATRICK MCGANNON
CLOSURE: 1: 180,892
MAP PAGE(S): 04-00-007
APPOVED BY: DMA **DATE:** 7/26/2021
SCALE: 1" = 50' **PRIOR INSTRUMENT:** 20200795617