PARENT PARCEL: 05-00-005-106-014, 05-00-016-101-189, & -190

CHILD PARCEL: 05-00-005-106-044 & 05-00-016-101-194 N/A

STARTING POINT: INTERSECTION OF C/LS OF WILLOW CREEK DR & SOUTH LAKE ST

23-04619

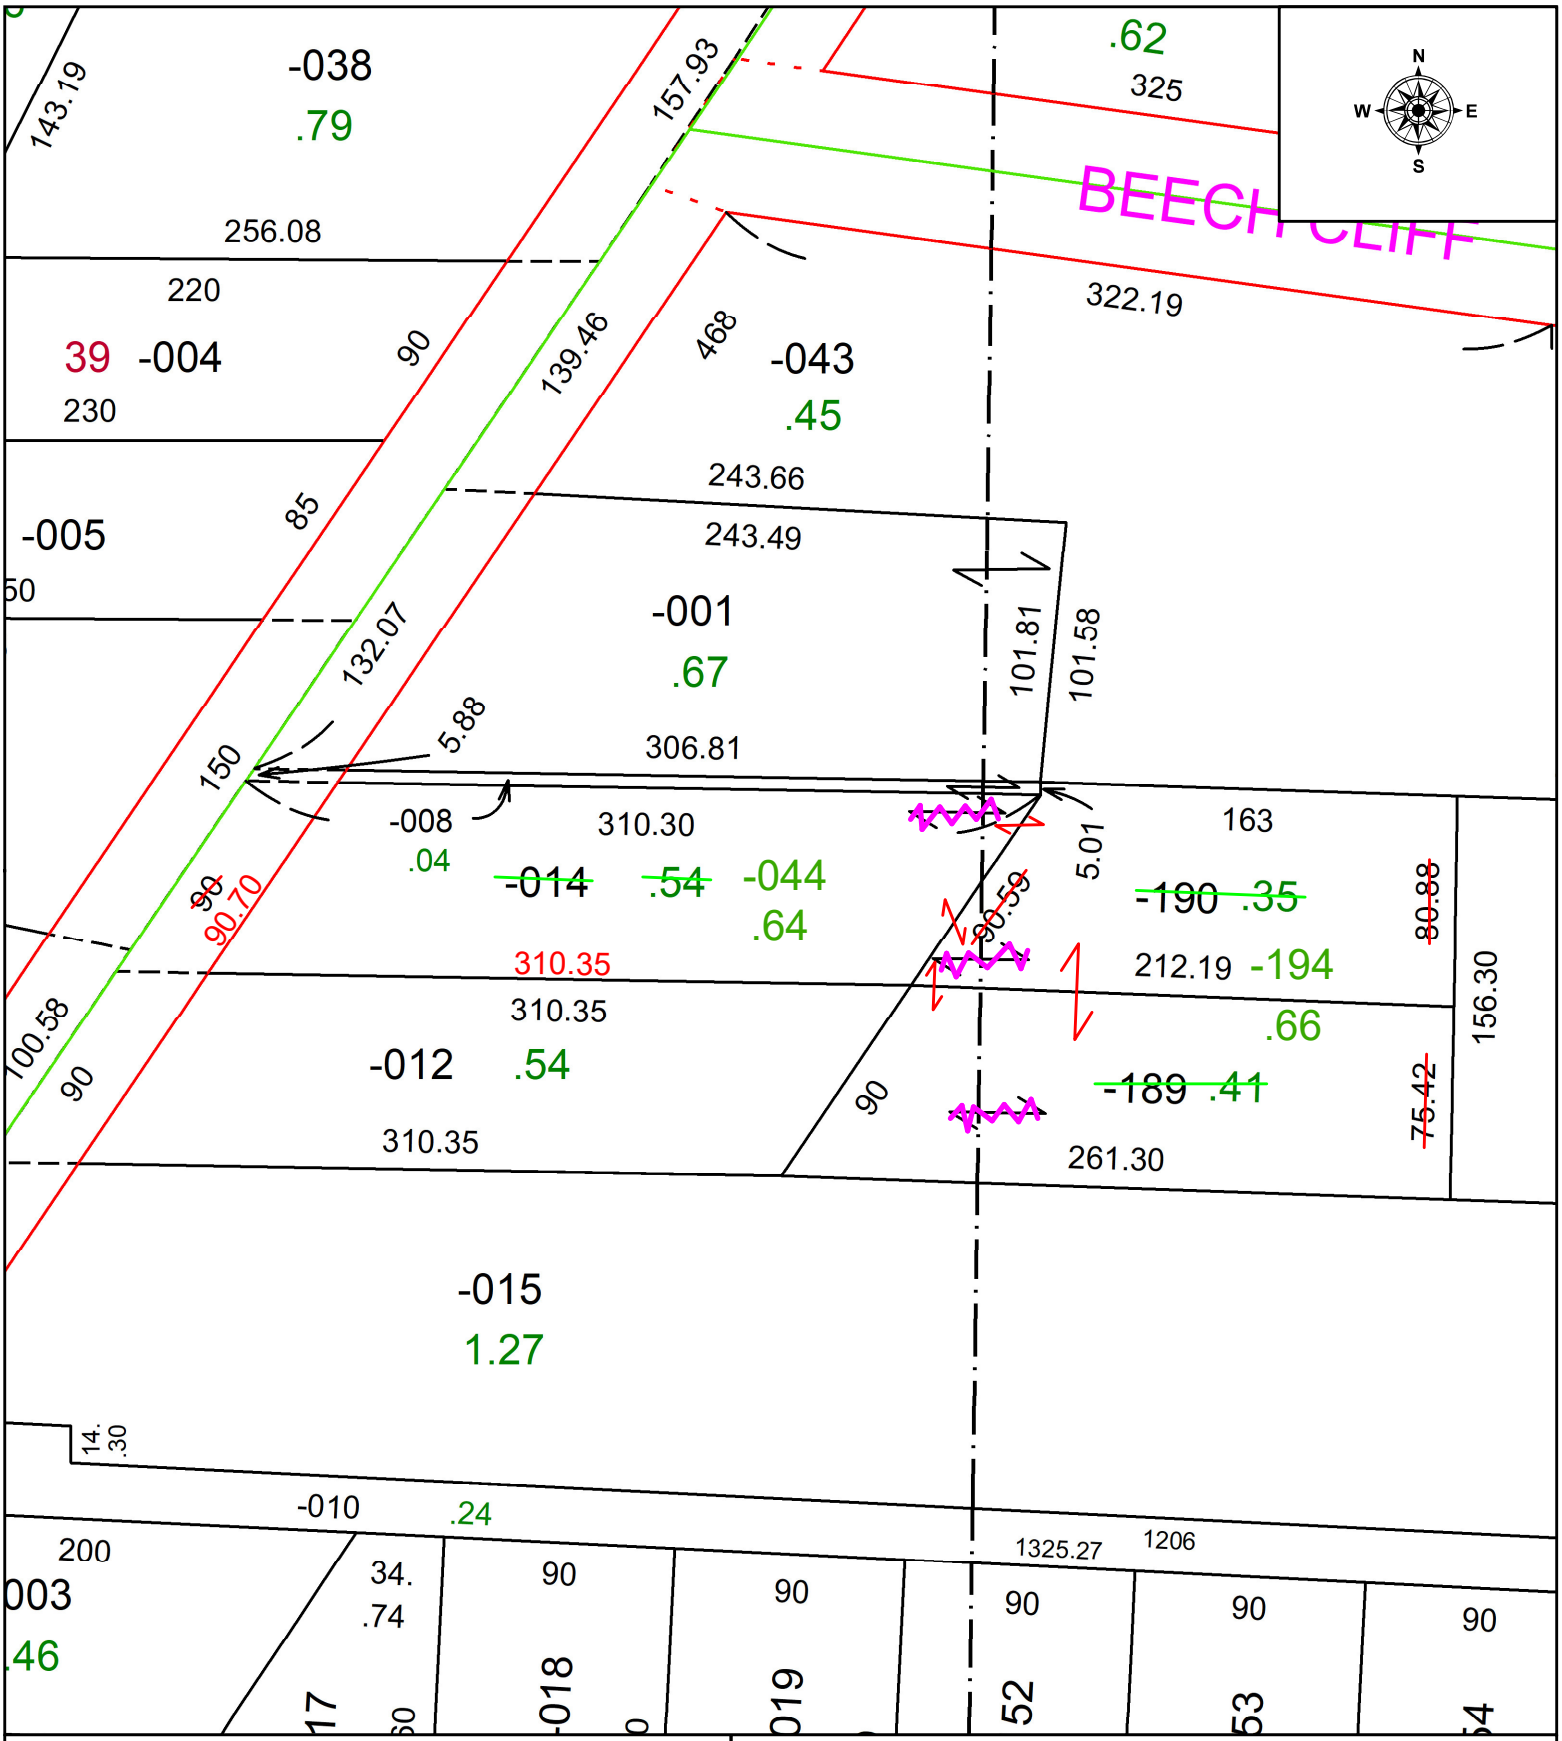

SPLITS/DEEDS PROCESSED

LORAIN COUNTY TAX MAP DEPARTMENT
226 MIDDLE AVE. ELYRIA, OH

SURVEYED BY: JOSHUA RIEDY SURVEY # 50793
CLOSURE: 1: 259436
MAP PAGE(S): 05-00-005 & 05-00-016
APPOVED BY: WRZ **DATE:** 1/26-2023
SCALE: 1" = 75 **PRIOR INSTRUMENT:** #2022-0859892