PARENT PARCEL: 02-03-004-000-170 THRU -172
CHILD PARCEL: 02-03-004-000-193
STARTING POINT: S.E. CORNER OF S/L 7 MALLARD CREEK ESTATES SUB. 1 P.V. 77 PG. 42

23-04627

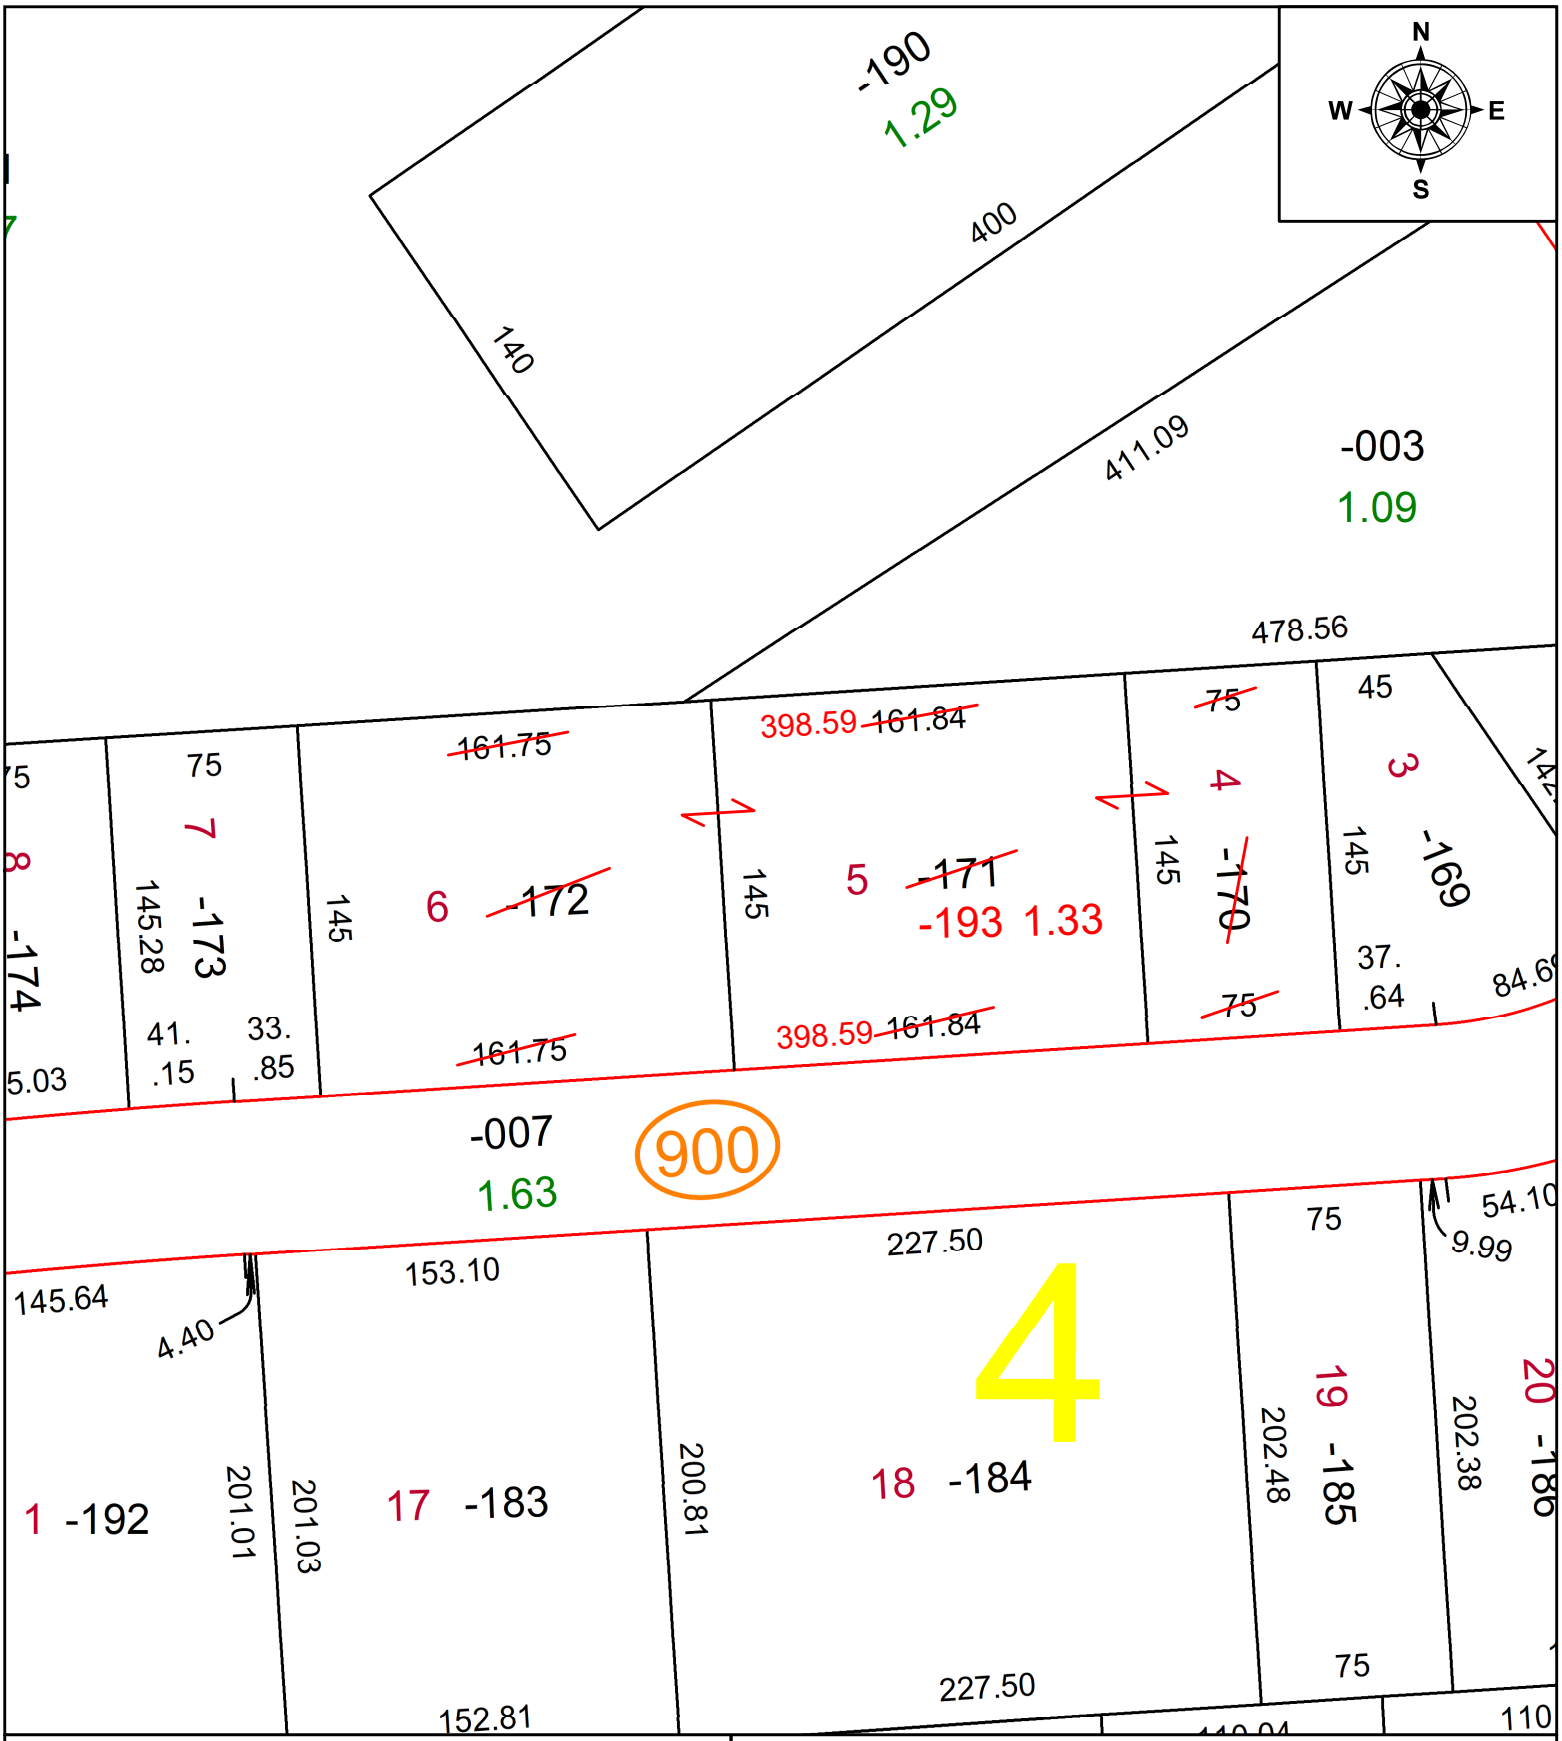

SPLITS/DEEDS PROCESSED
LORAIN COUNTY TAX MAP DEPARTMENT
226 MIDDLE AVE. ELYRIA, OH

SURVEYED BY: JOSHUA RIEDY **SURVEY #:** 50805
CLOSURE: 1:-2147483648
MAP PAGE(S): 02-03-004
APPOVED BY: DMA **DATE:** 2/13/2023
SCALE: 1" = 75' **PRIOR INSTRUMENT:** 2021-0837807