PARENT PARCEL: 02-01-006-174-011
CHILD PARCEL: FRONT & DEPTH TO AC CORR PER SURV BY RUDY SCHWARTZ
STARTING POINT: C/L OF OBERLIN AND MEISTER RD

21-04628-C

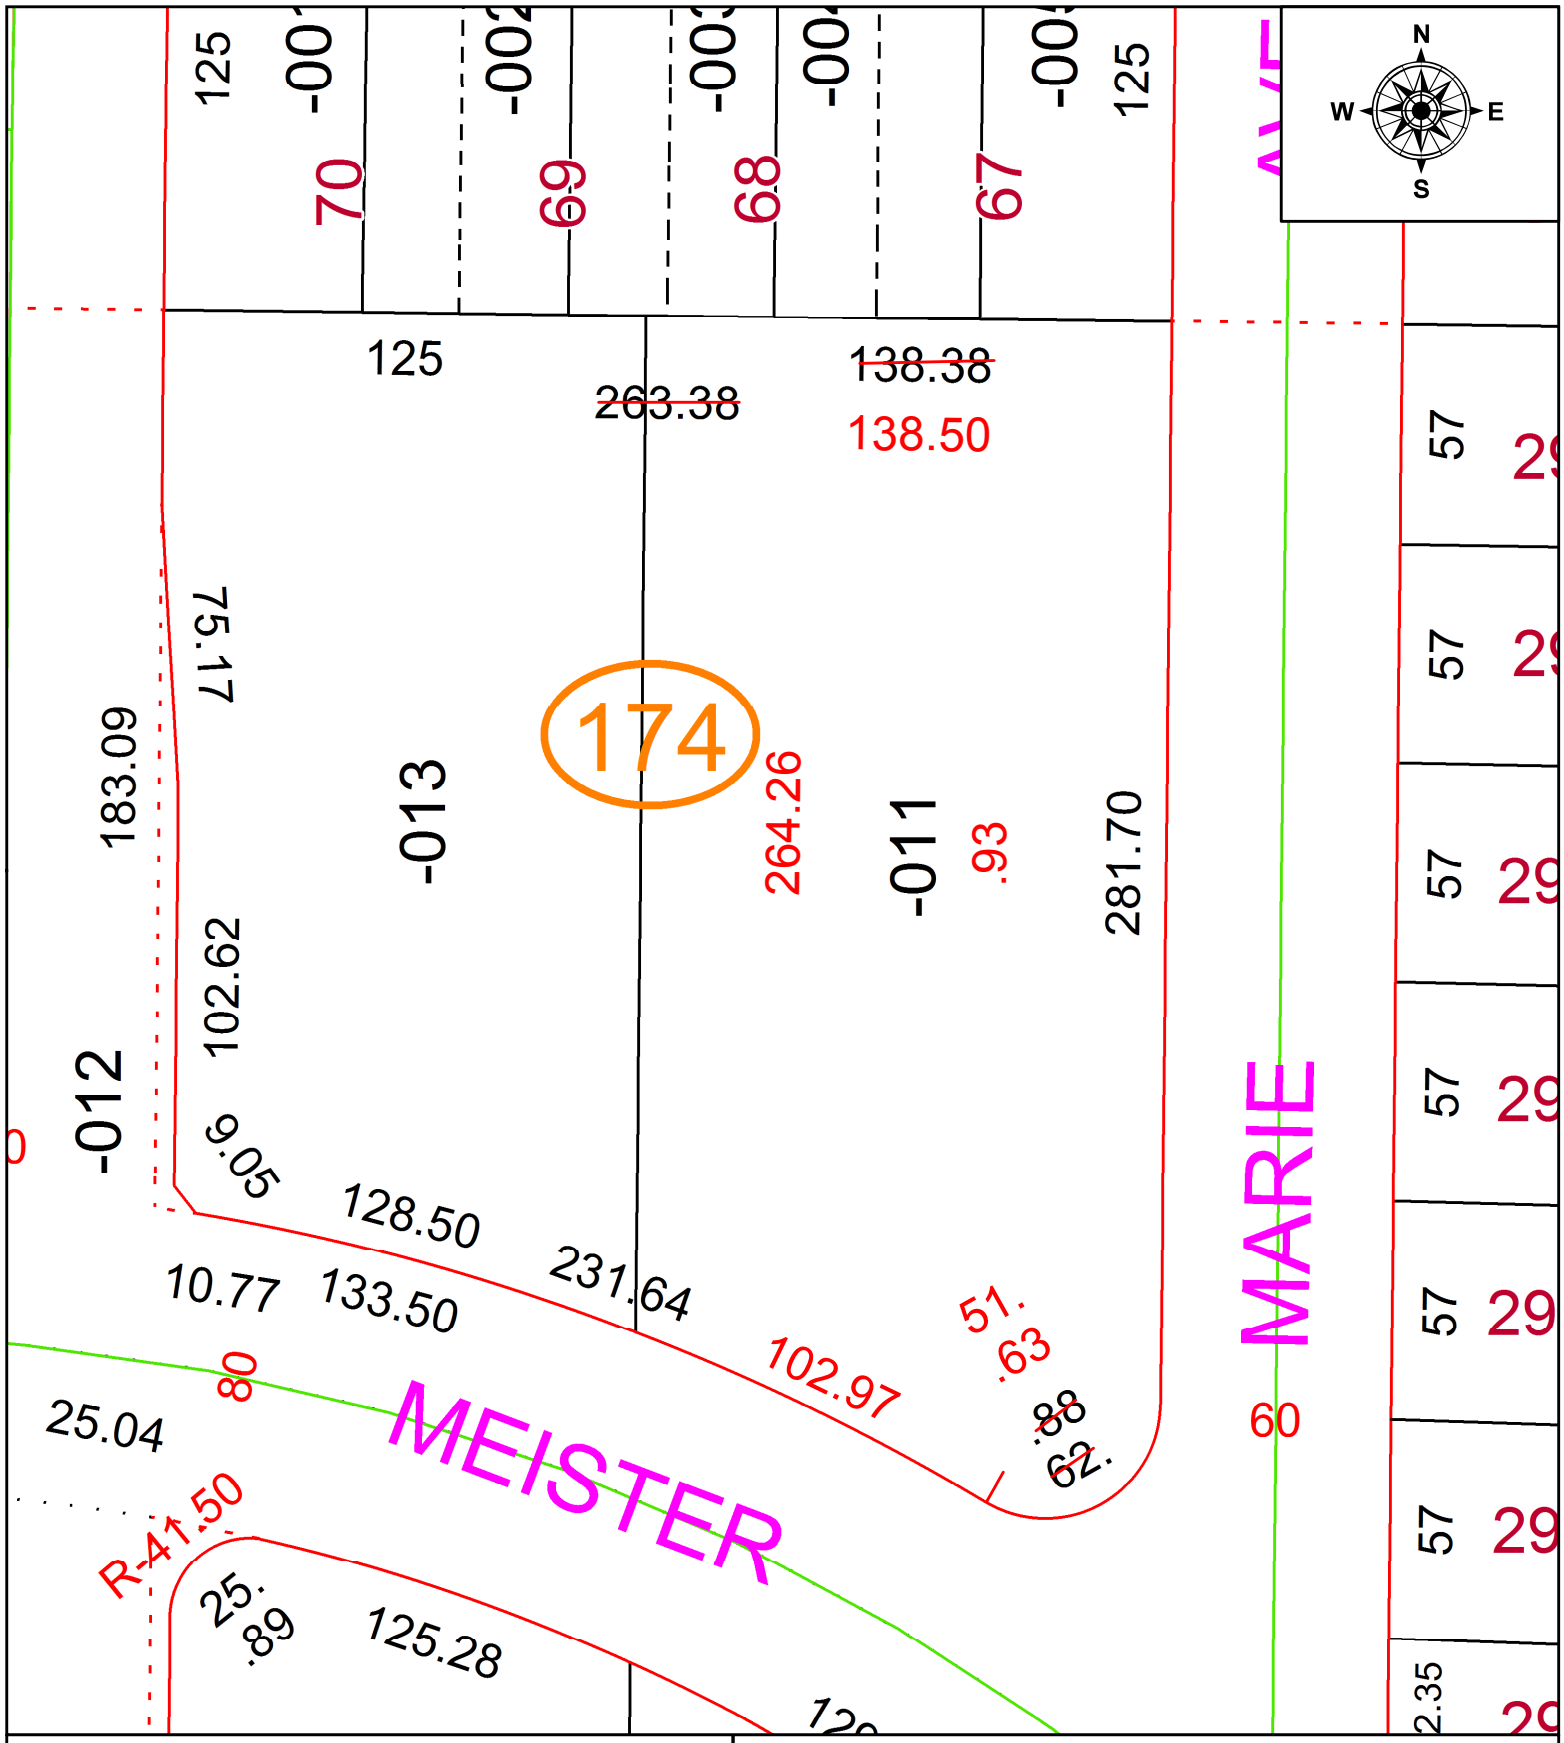

SPLITS/DEEDS PROCESSED
LORAIN COUNTY TAX MAP DEPARTMENT
226 MIDDLE AVE. ELYRIA, OH

SURVEYED BY: RUDY E. SCHWARTZ
CLOSURE: 1: 1435383
MAP PAGE(S): 02-01-006
APPOVED BY: AC **DATE:** 8/19/2021
SCALE: 1" = 50 **PRIOR INSTRUMENT:** 2006- 0166048