PARENT PARCEL: 14-00-116-000-001

CHILD PARCEL: 14-00-116-000-009 & -010

STARTING POINT: C/L OF WHITNEY RD AND NW CORNER OF O/L 116

23-04630

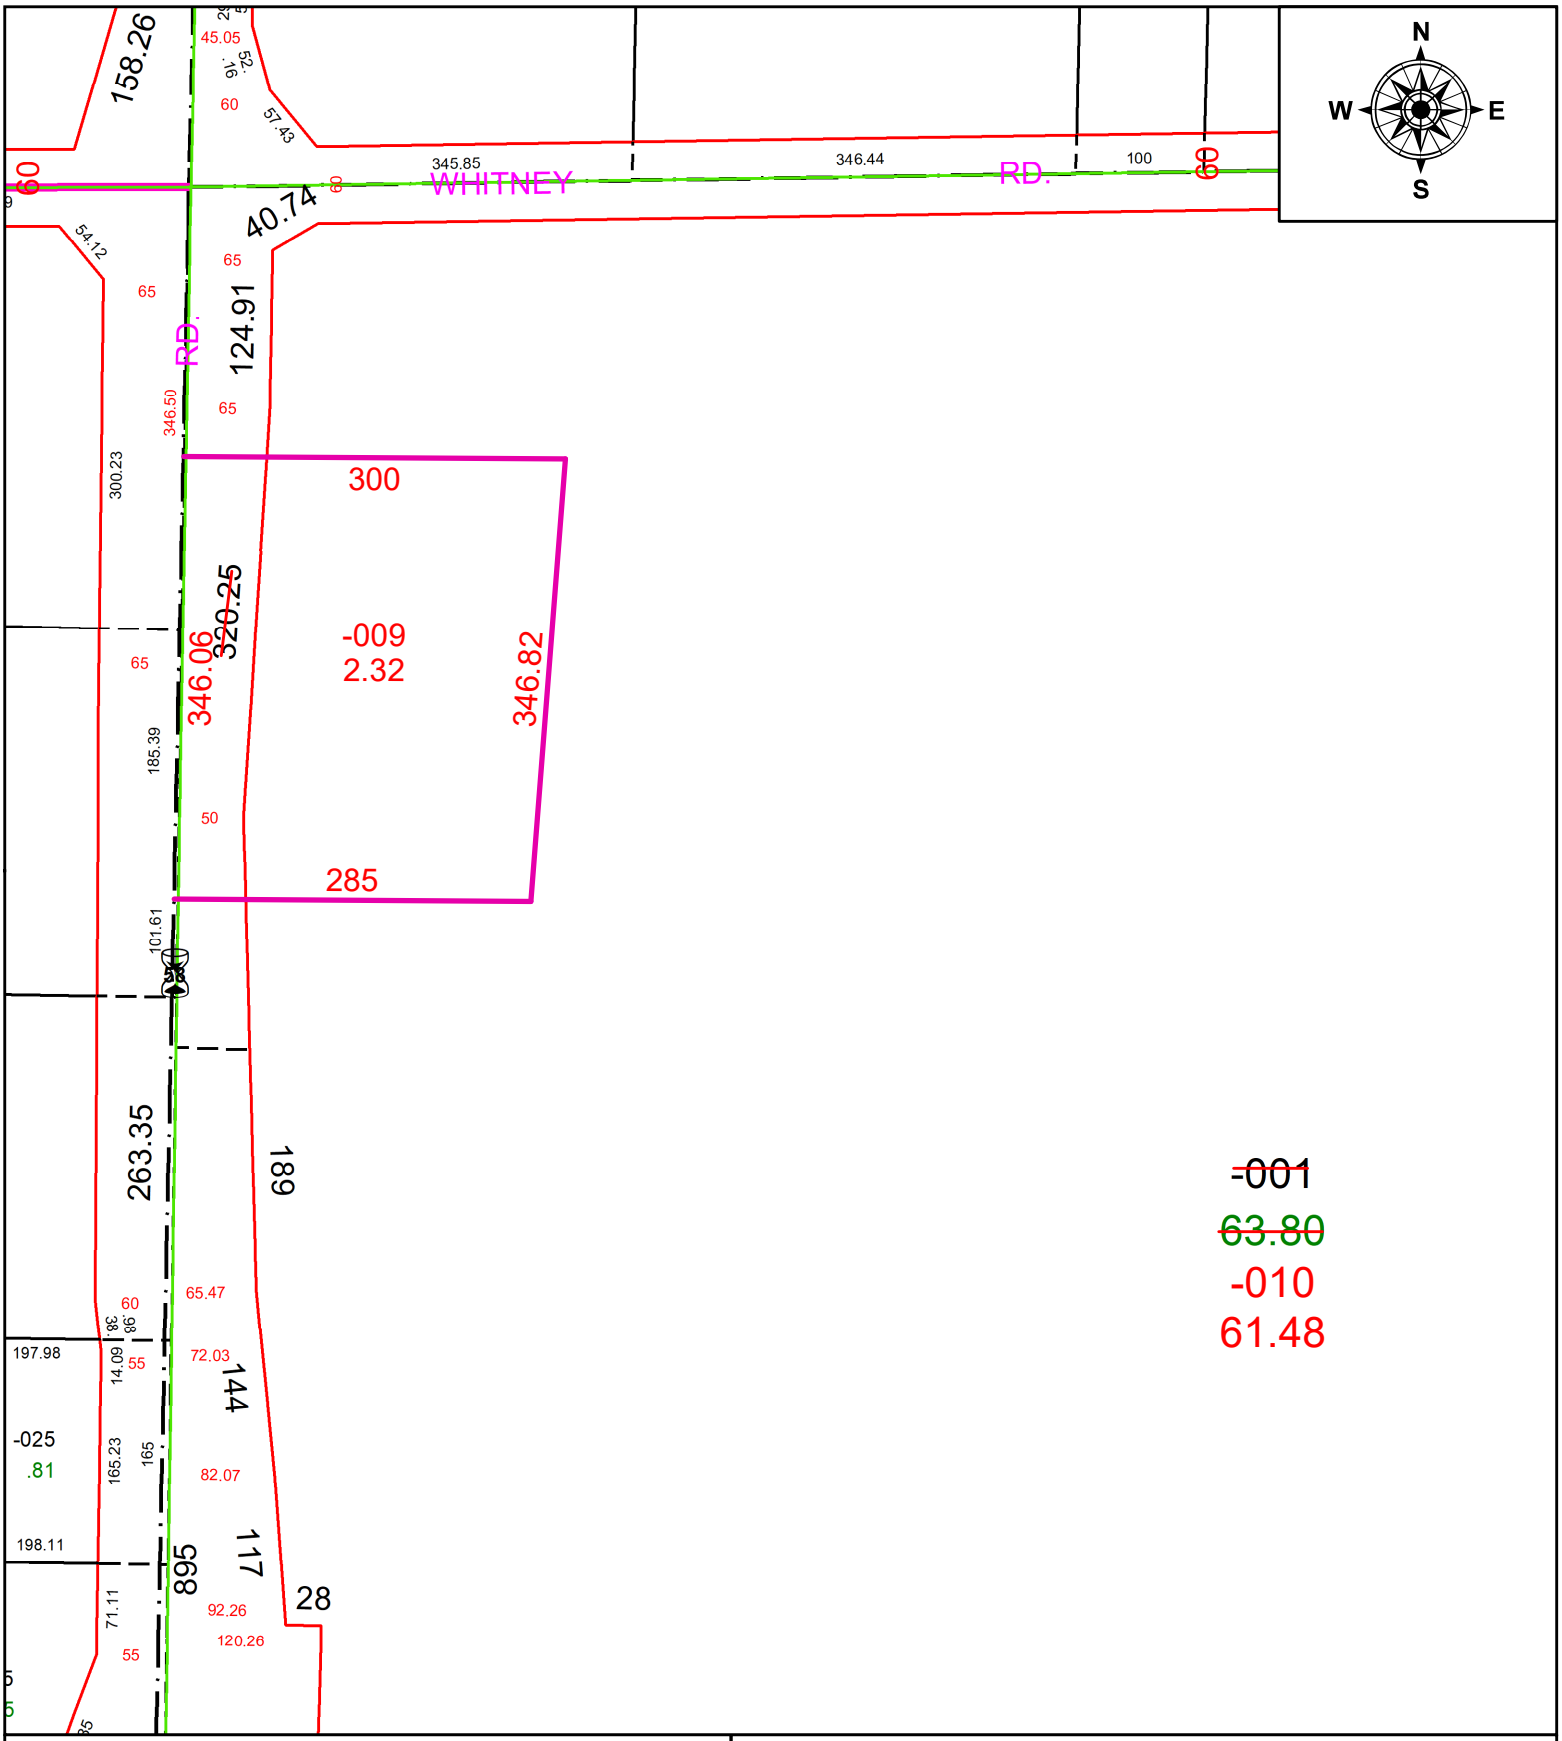

SPLITS/DEEDS PROCESSED

LORAIN COUNTY TAX MAP DEPARTMENT
226 MIDDLE AVE. ELYRIA, OH

SURVEYED BY: THOMAS A. SIMON **SURV # 50807**

CLOSURE: 1: 251864

MAP PAGE(S): 14-00-116

APPOVED BY: AC **DATE:** February 14, 2023

SCALE: 1 in = 150 ft **PRIOR INSTRUMENT:** 2001- 0796111