PARENT PARCEL: 15-00-020-000-040

CHILD PARCEL: 15-00-020-000-057 & -058

STARTING POINT: EAST LINE OF O.L. 20 CL OF KIPTON NICKLE PLATED RD.

23-04633

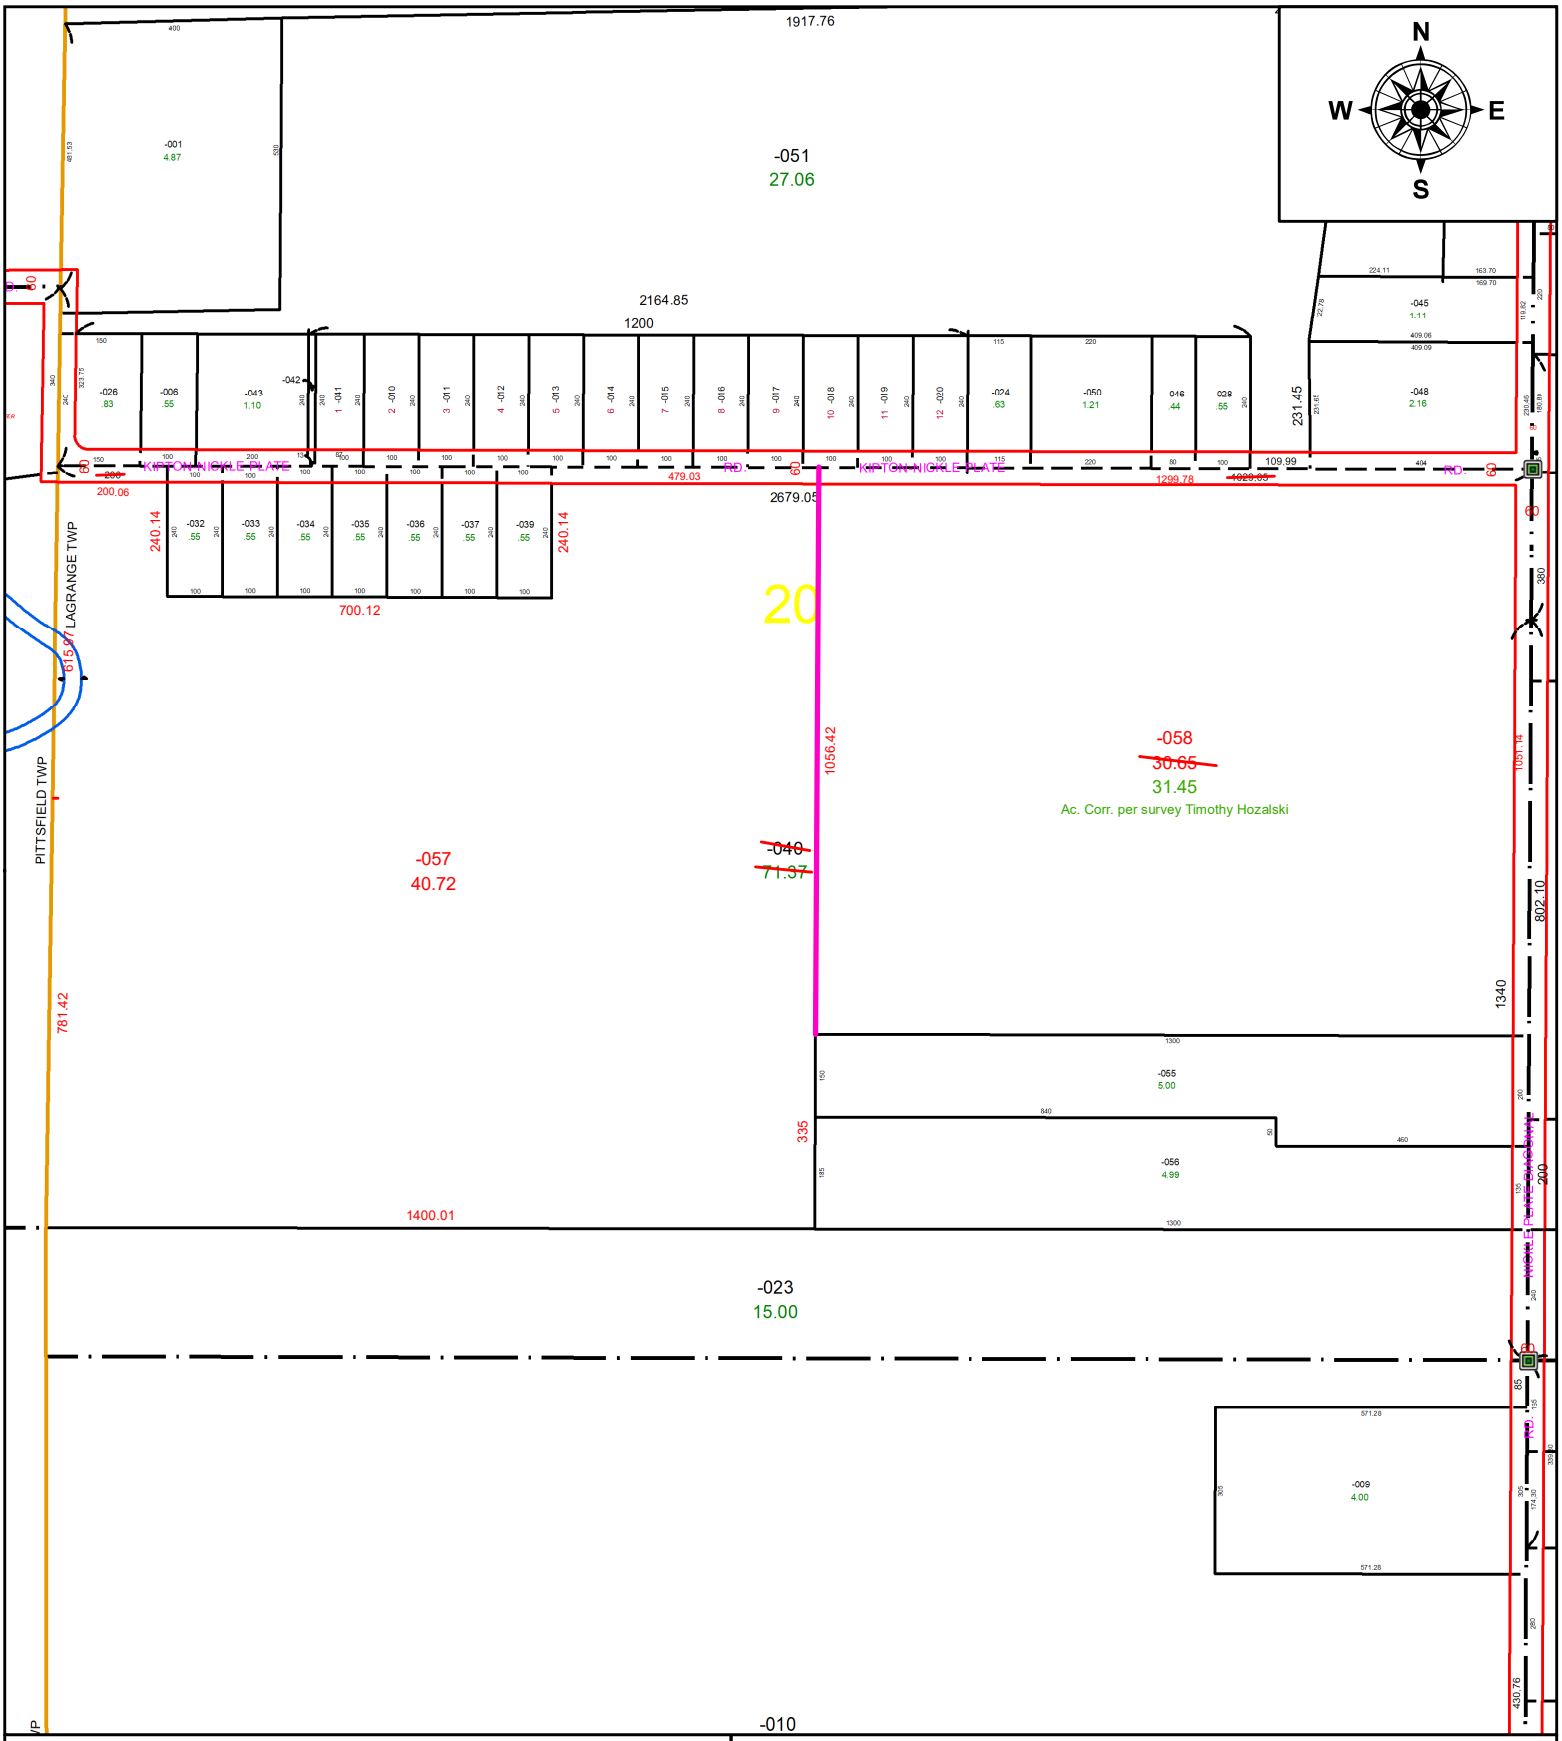

SPLITS/DEEDS PROCESSED

LORAIN COUNTY TAX MAP DEPARTMENT
226 MIDDLE AVE. ELYRIA, OH

SURVEYED BY: TIMOTHY HOZALSKI **SURVEY #:** 50812

CLOSURE: 1:769159

MAP PAGE(S): 15-00-020

APPOVED BY: DMA **DATE:** 2/17/2023

SCALE: 1" = 350' **PRIOR INSTRUMENT:** 2014-0512035