PARENT PARCEL: 09-00-096-106-009 & -011 (FRONTAGE & DEPTH CORR. 09-00-096-106-008)
CHILD PARCEL: 09-00-096-106-028
STARTING POINT: N.W. CORNER S/L 31 (I.P. FD. 2' EAST)

23-04638

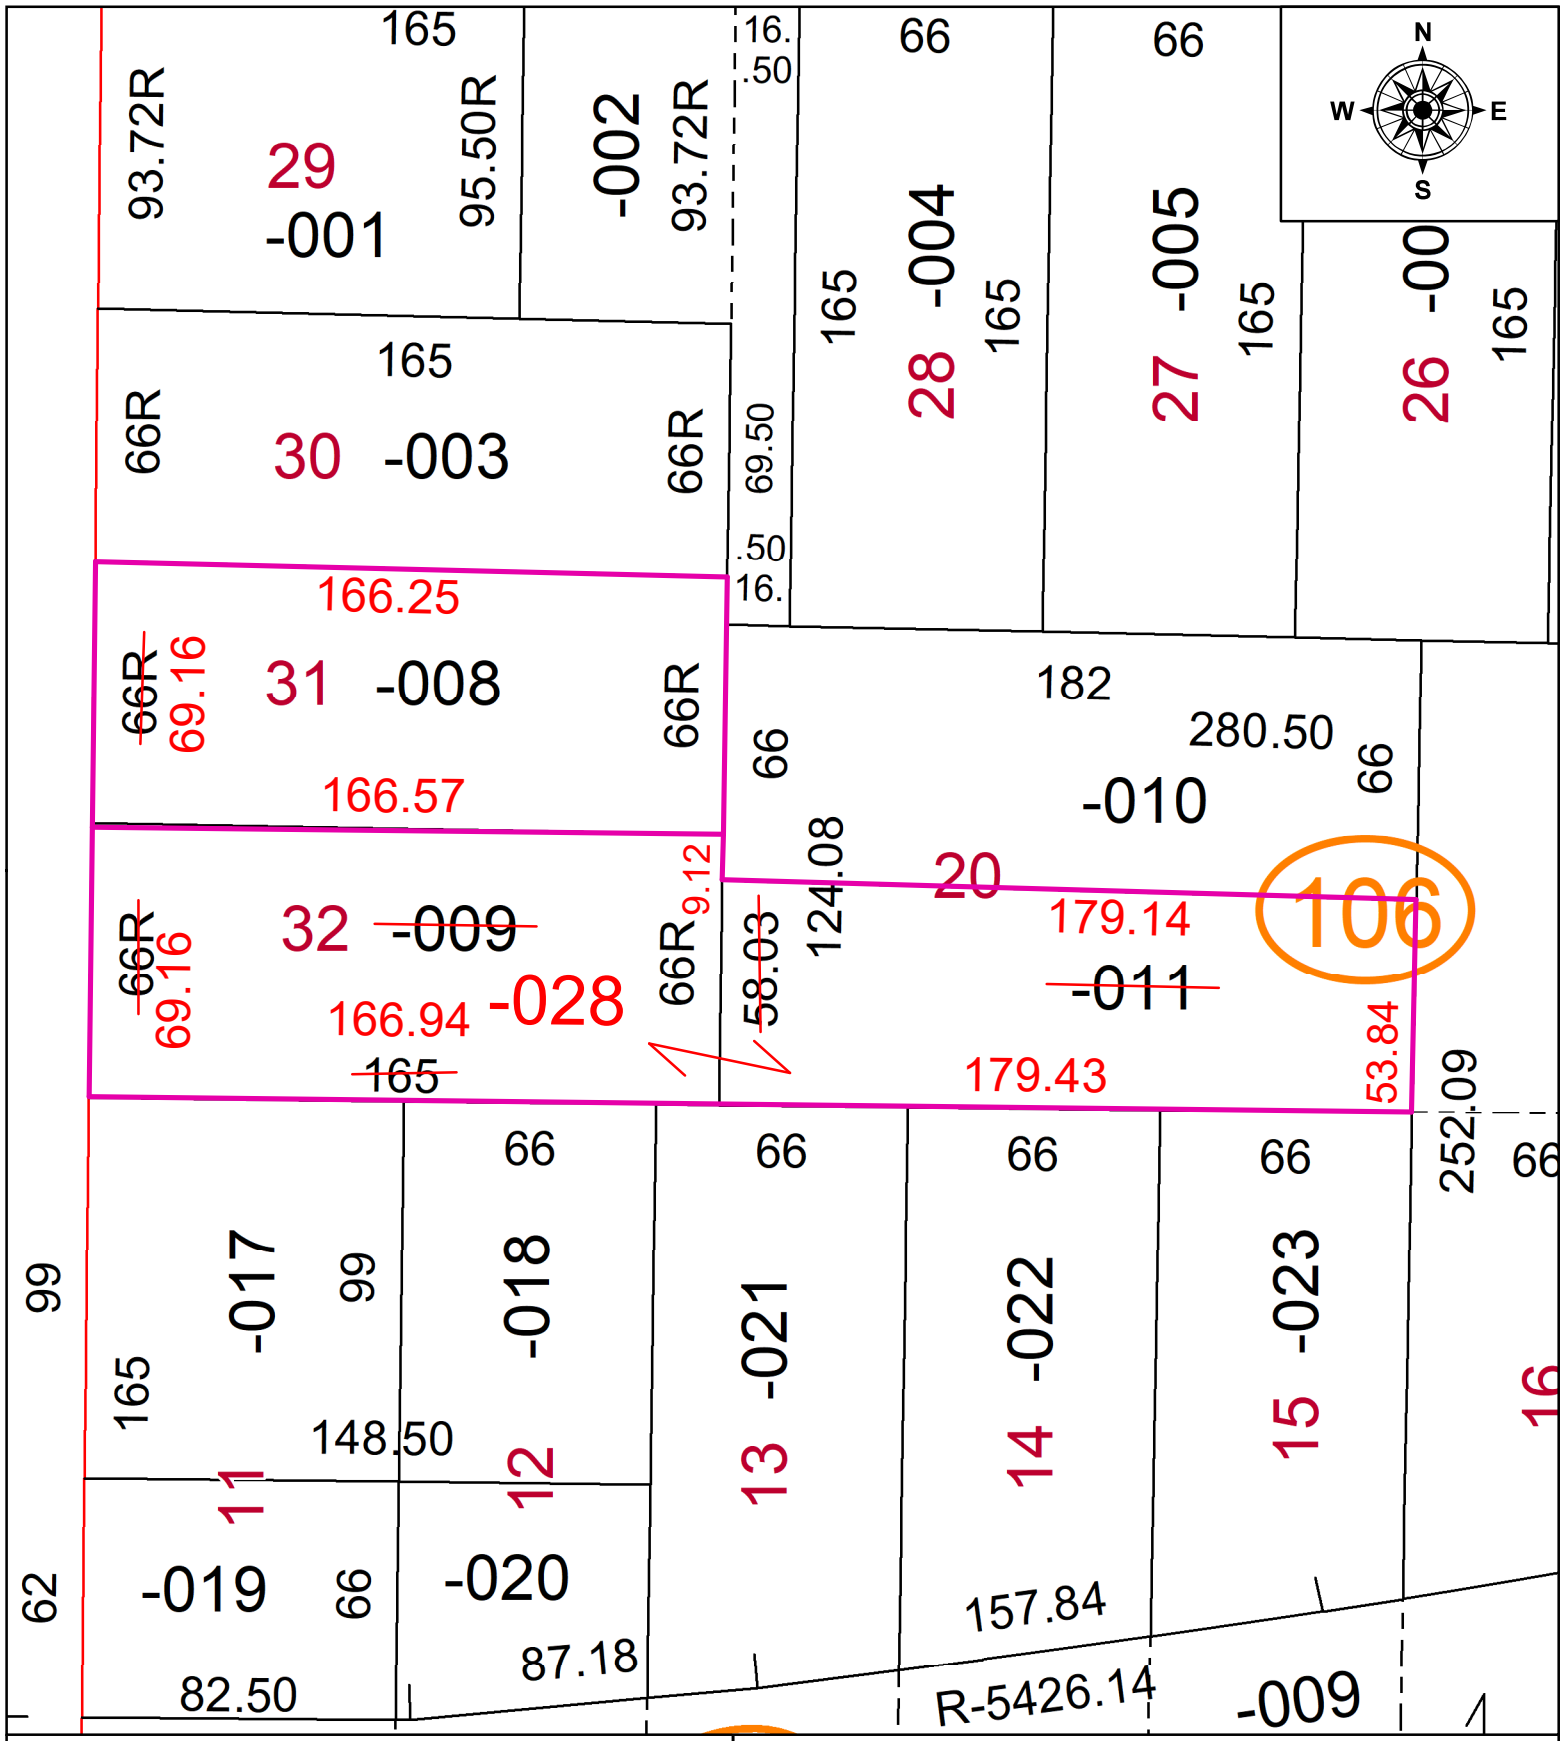

SPLITS/DEEDS PROCESSED
LORAIN COUNTY TAX MAP DEPARTMENT
226 MIDDLE AVE. ELYRIA, OH

SURVEYED BY: TIM HOZALSKI
CLOSURE: 1:158424
MAP PAGE(S): 09-00-096
APPOVED BY: TJS **DATE:** 2/22/2023
SCALE: 1" = 50' **PRIOR INSTRUMENT:** 2021-0809720