PARENT PARCEL: 18-00-035-000-016, 017

CHILD PARCEL:

STARTING POINT: MAP CORR ONLY PER PRIOR DEED VOL 1021 PG 000727

21-04645-C

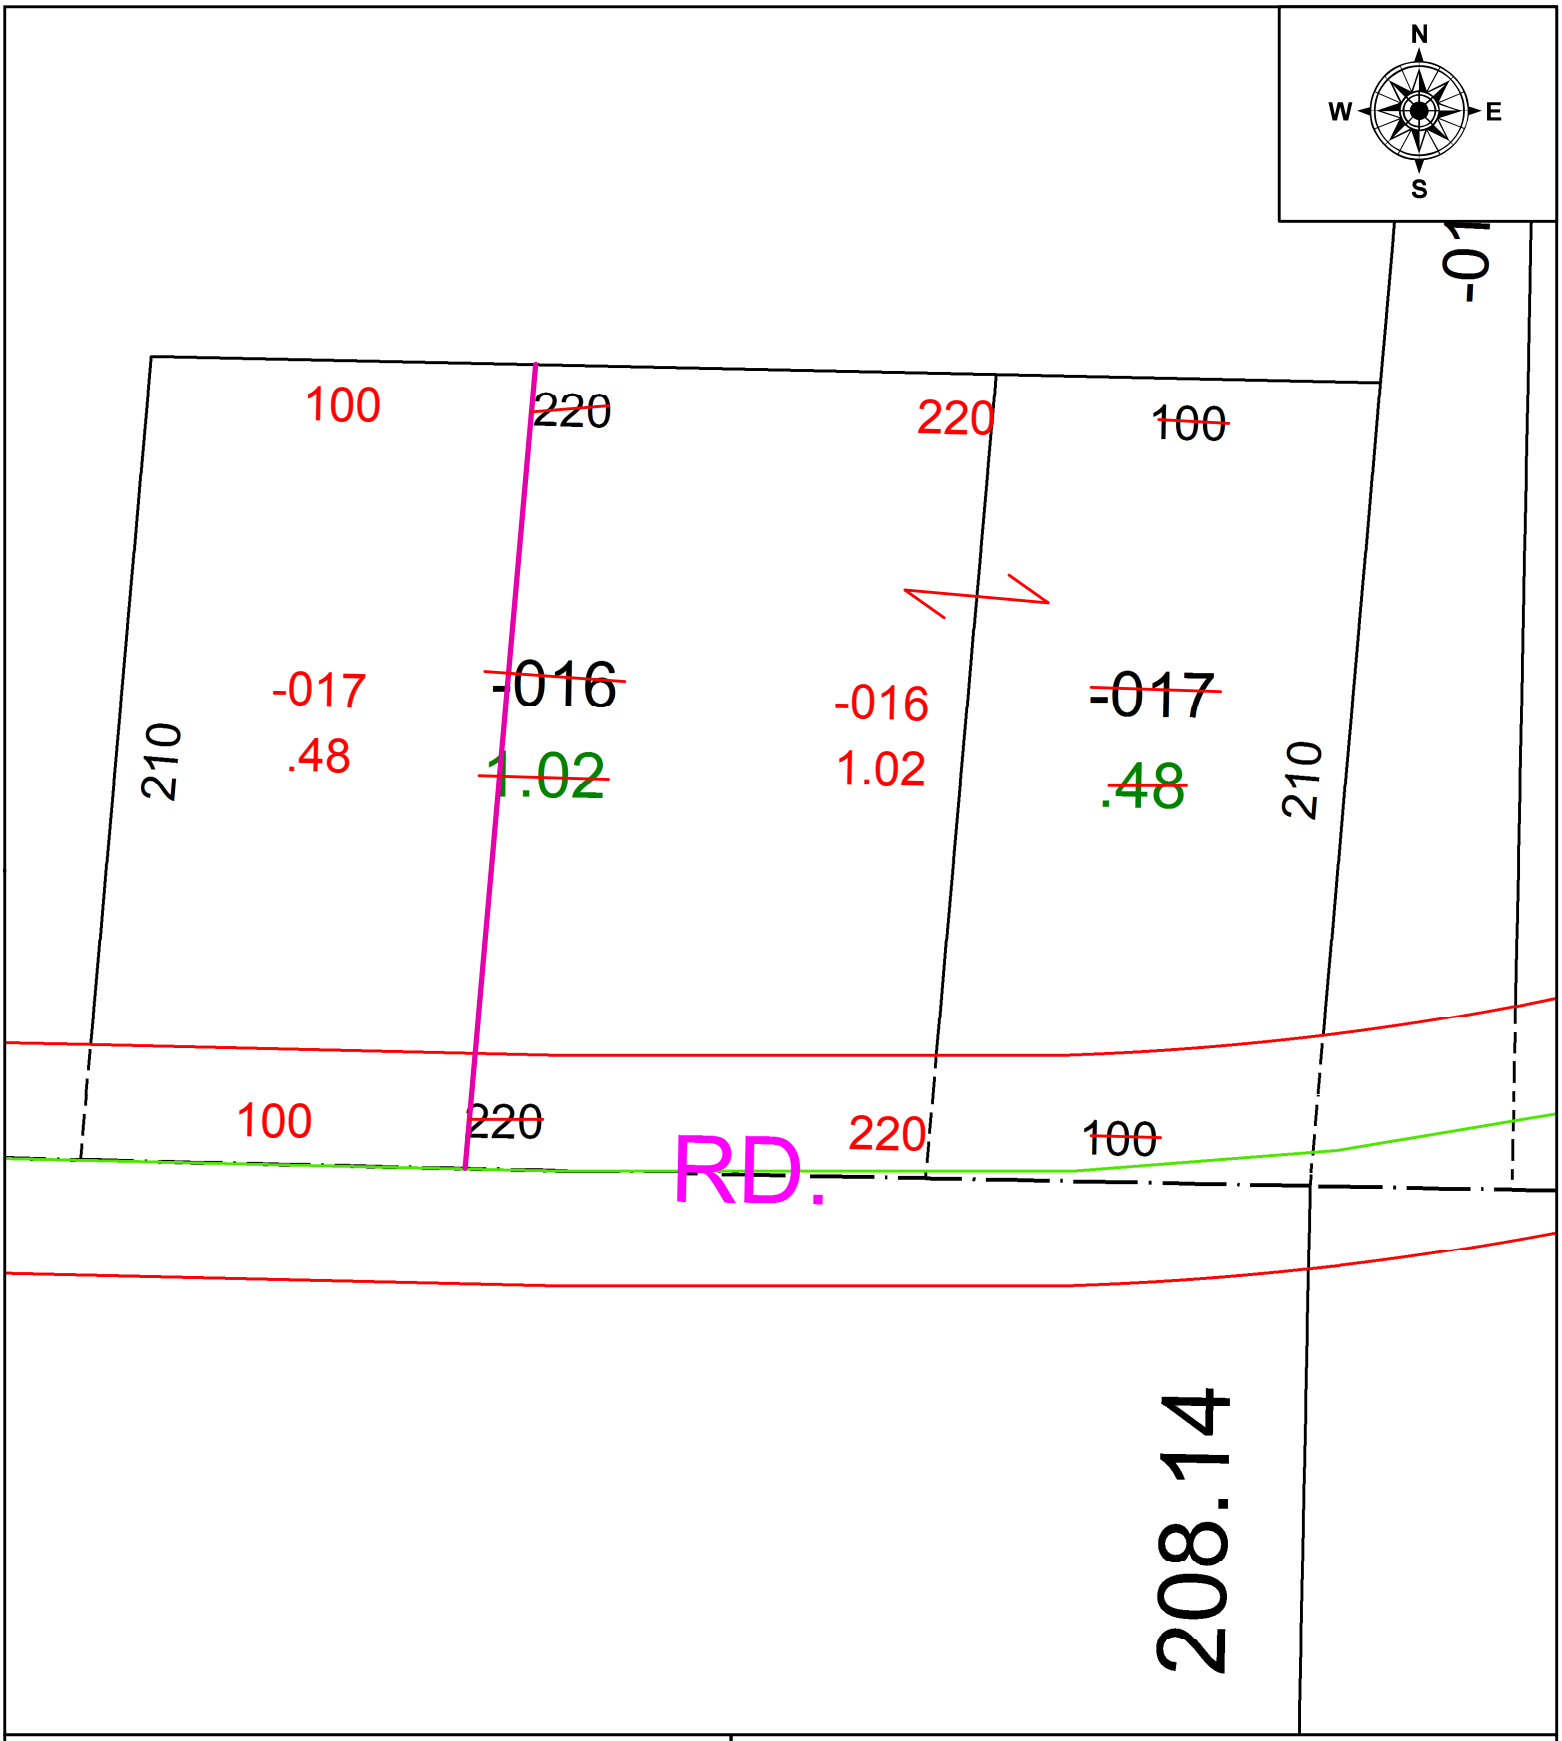

SPLITS/DEEDS PROCESSED

LORAIN COUNTY TAX MAP DEPARTMENT
226 MIDDLE AVE. ELYRIA, OH

SURVEYED BY: N/A
CLOSURE: N/A
MAP PAGE(S): 18-00-035-C
APPOVED BY: AC **DATE:** 9/9/2021
SCALE: 1" = 50 **PRIOR INSTRUMENT:** 2021- 0801242