PARENT PARCEL: 13-11-016-105-005, -006, -007, -008

CHILD PARCEL: 13-11-016-105-020

STARTING POINT: COMBINATION

21-04646-C

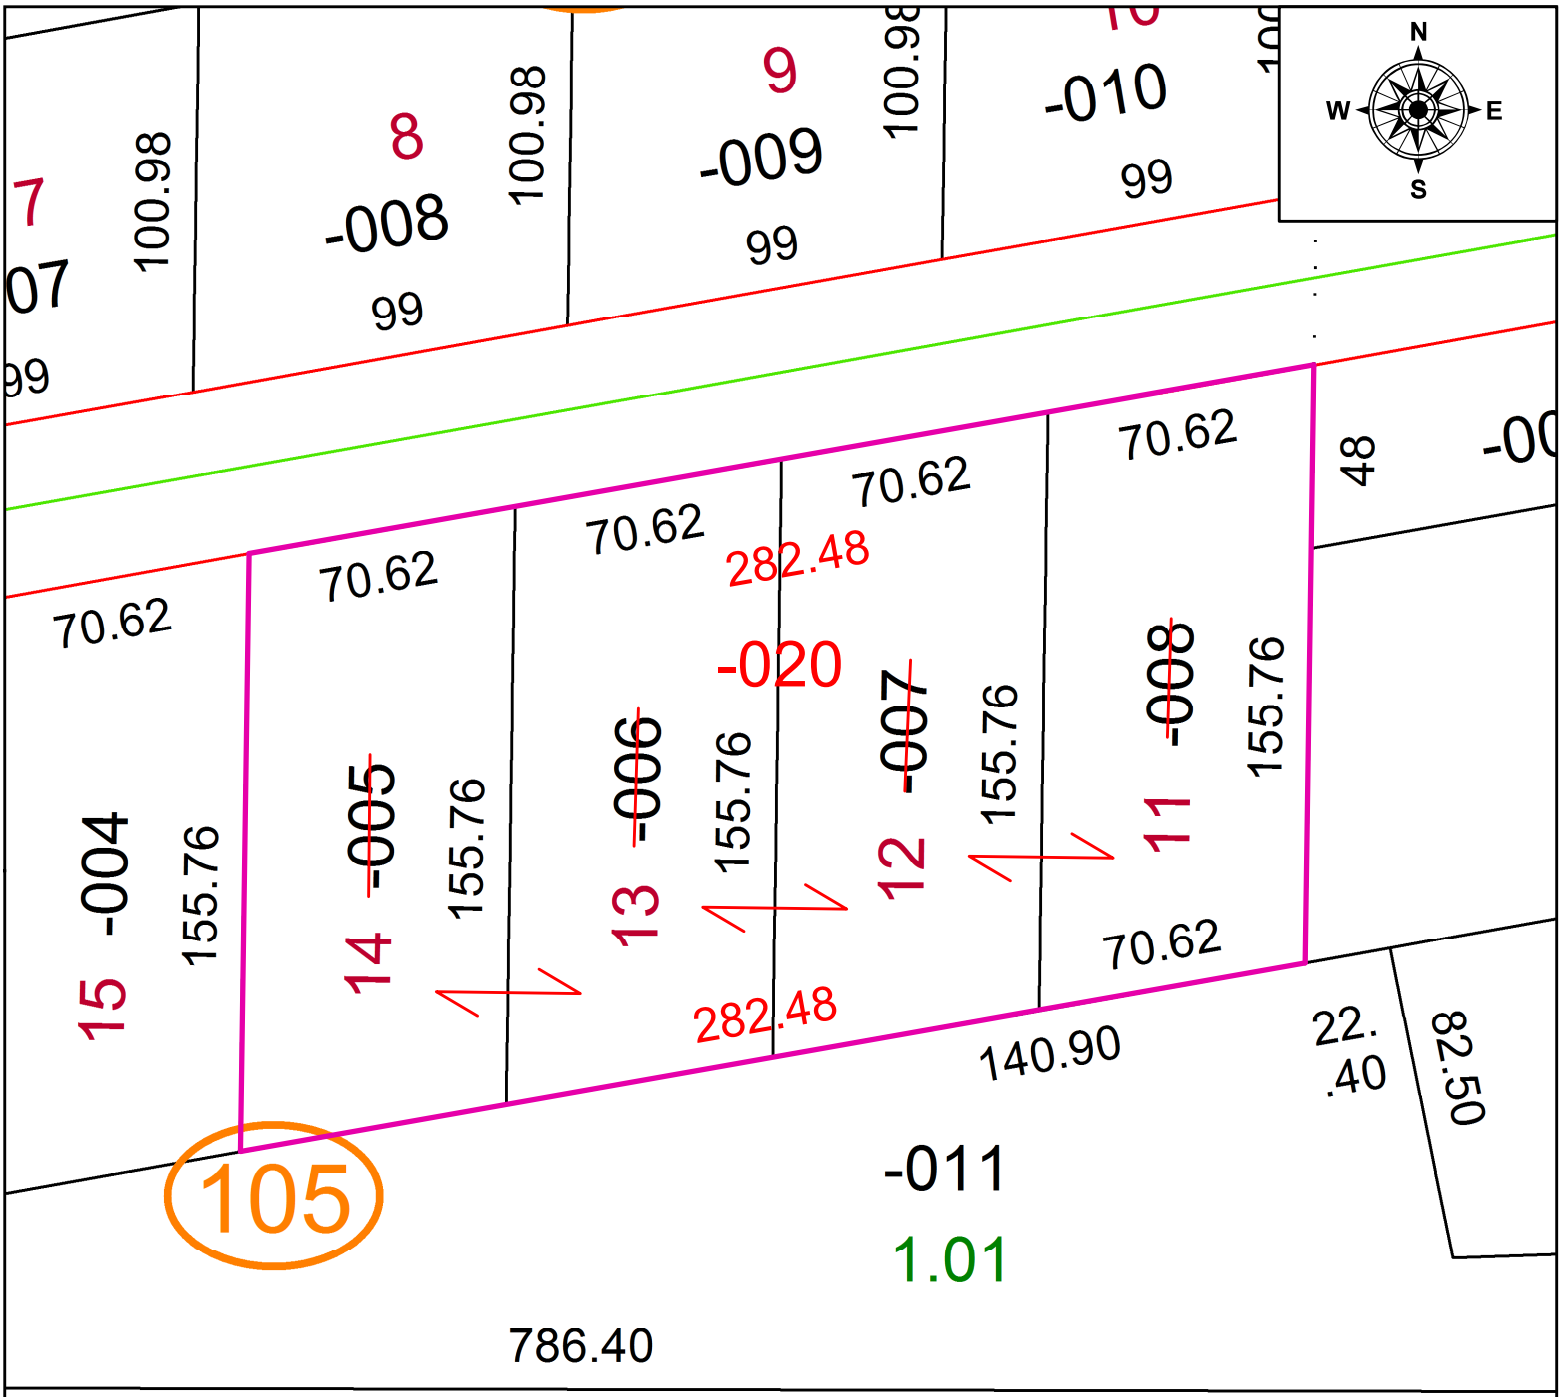

SPLITS/DEEDS PROCESSED

LORAIN COUNTY TAX MAP DEPARTMENT
226 MIDDLE AVE. ELYRIA, OH

SURVEYED BY: N/A
CLOSURE: N/A
MAP PAGE(S): 13-11-016
APPOVED BY: AC **DATE:** 9/1/2021
SCALE: 1" = 50 **PRIOR INSTRUMENT:** 2021- 0833557