PARENT PARCEL: 18-00-024-000-016

CHILD PARCEL: 18-00-024-000-026 & -027 N/A

STARTING POINT: NORTHWESTERLY CORNER OF O.L. 24 & THE C/L OF JONES RD

23-04646

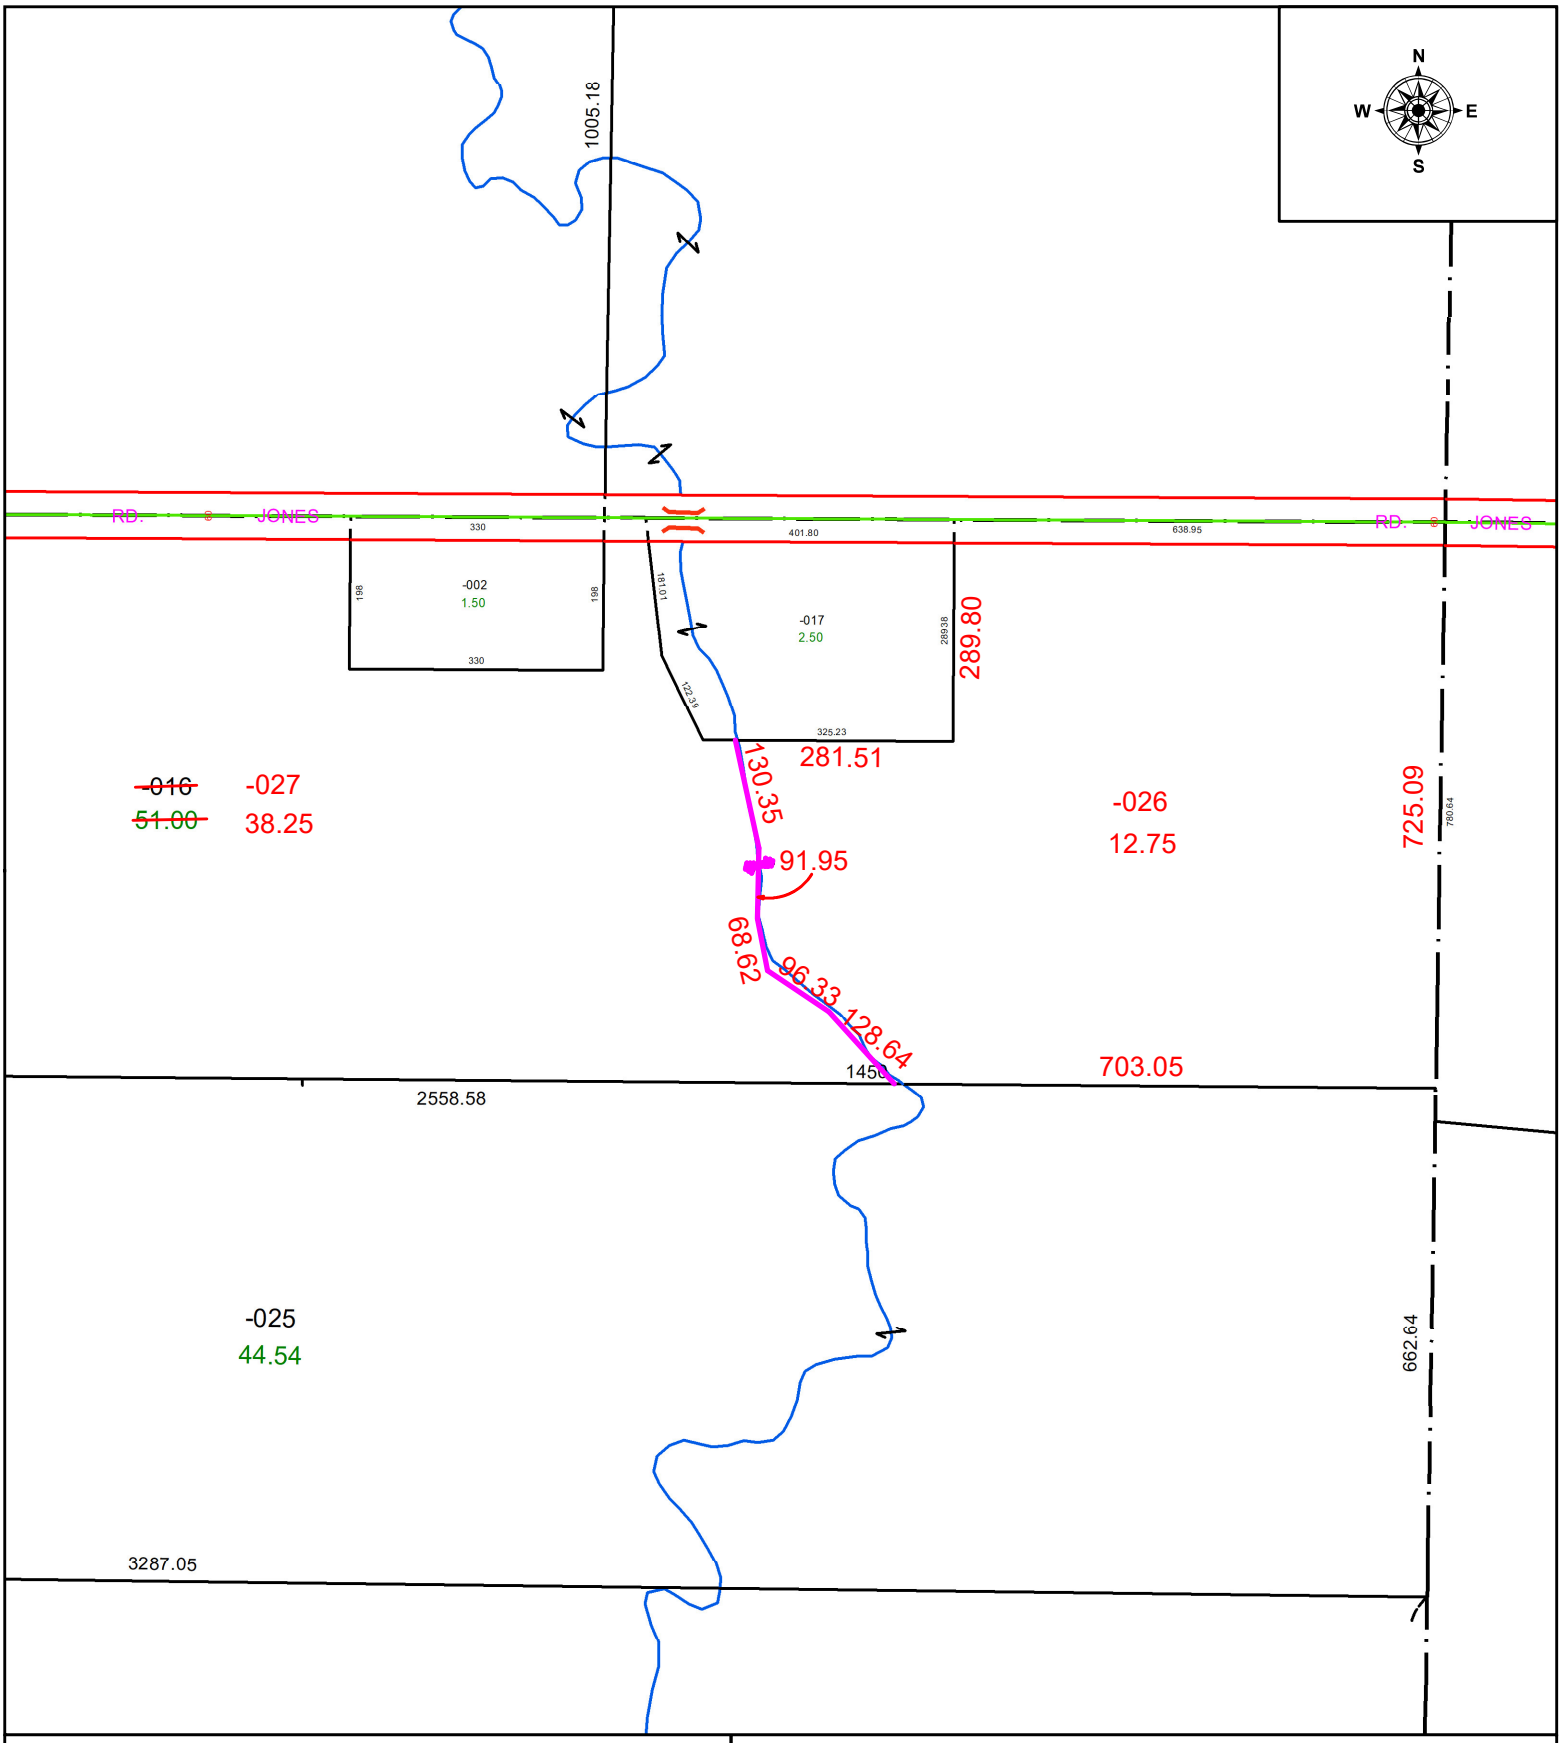

SPLITS/DEEDS PROCESSED

LORAIN COUNTY TAX MAP DEPARTMENT
226 MIDDLE AVE. ELYRIA, OH

SURVEYED BY: TIMOTHY HOZALSKI SURVEY # 50826

CLOSURE: 1: 241293

MAP PAGE(S): 18-00-024

APPOVED BY: WRZ **DATE:** 3/2/2023

SCALE: 1" = 250 **PRIOR INSTRUMENT:** #2000-0691211