PARENT PARCEL: 12-00-011-000-002

CHILD PARCEL: AC CORR PER SURV MICHAEL ACKERMAN

STARTING POINT: N/A

21-04649-C

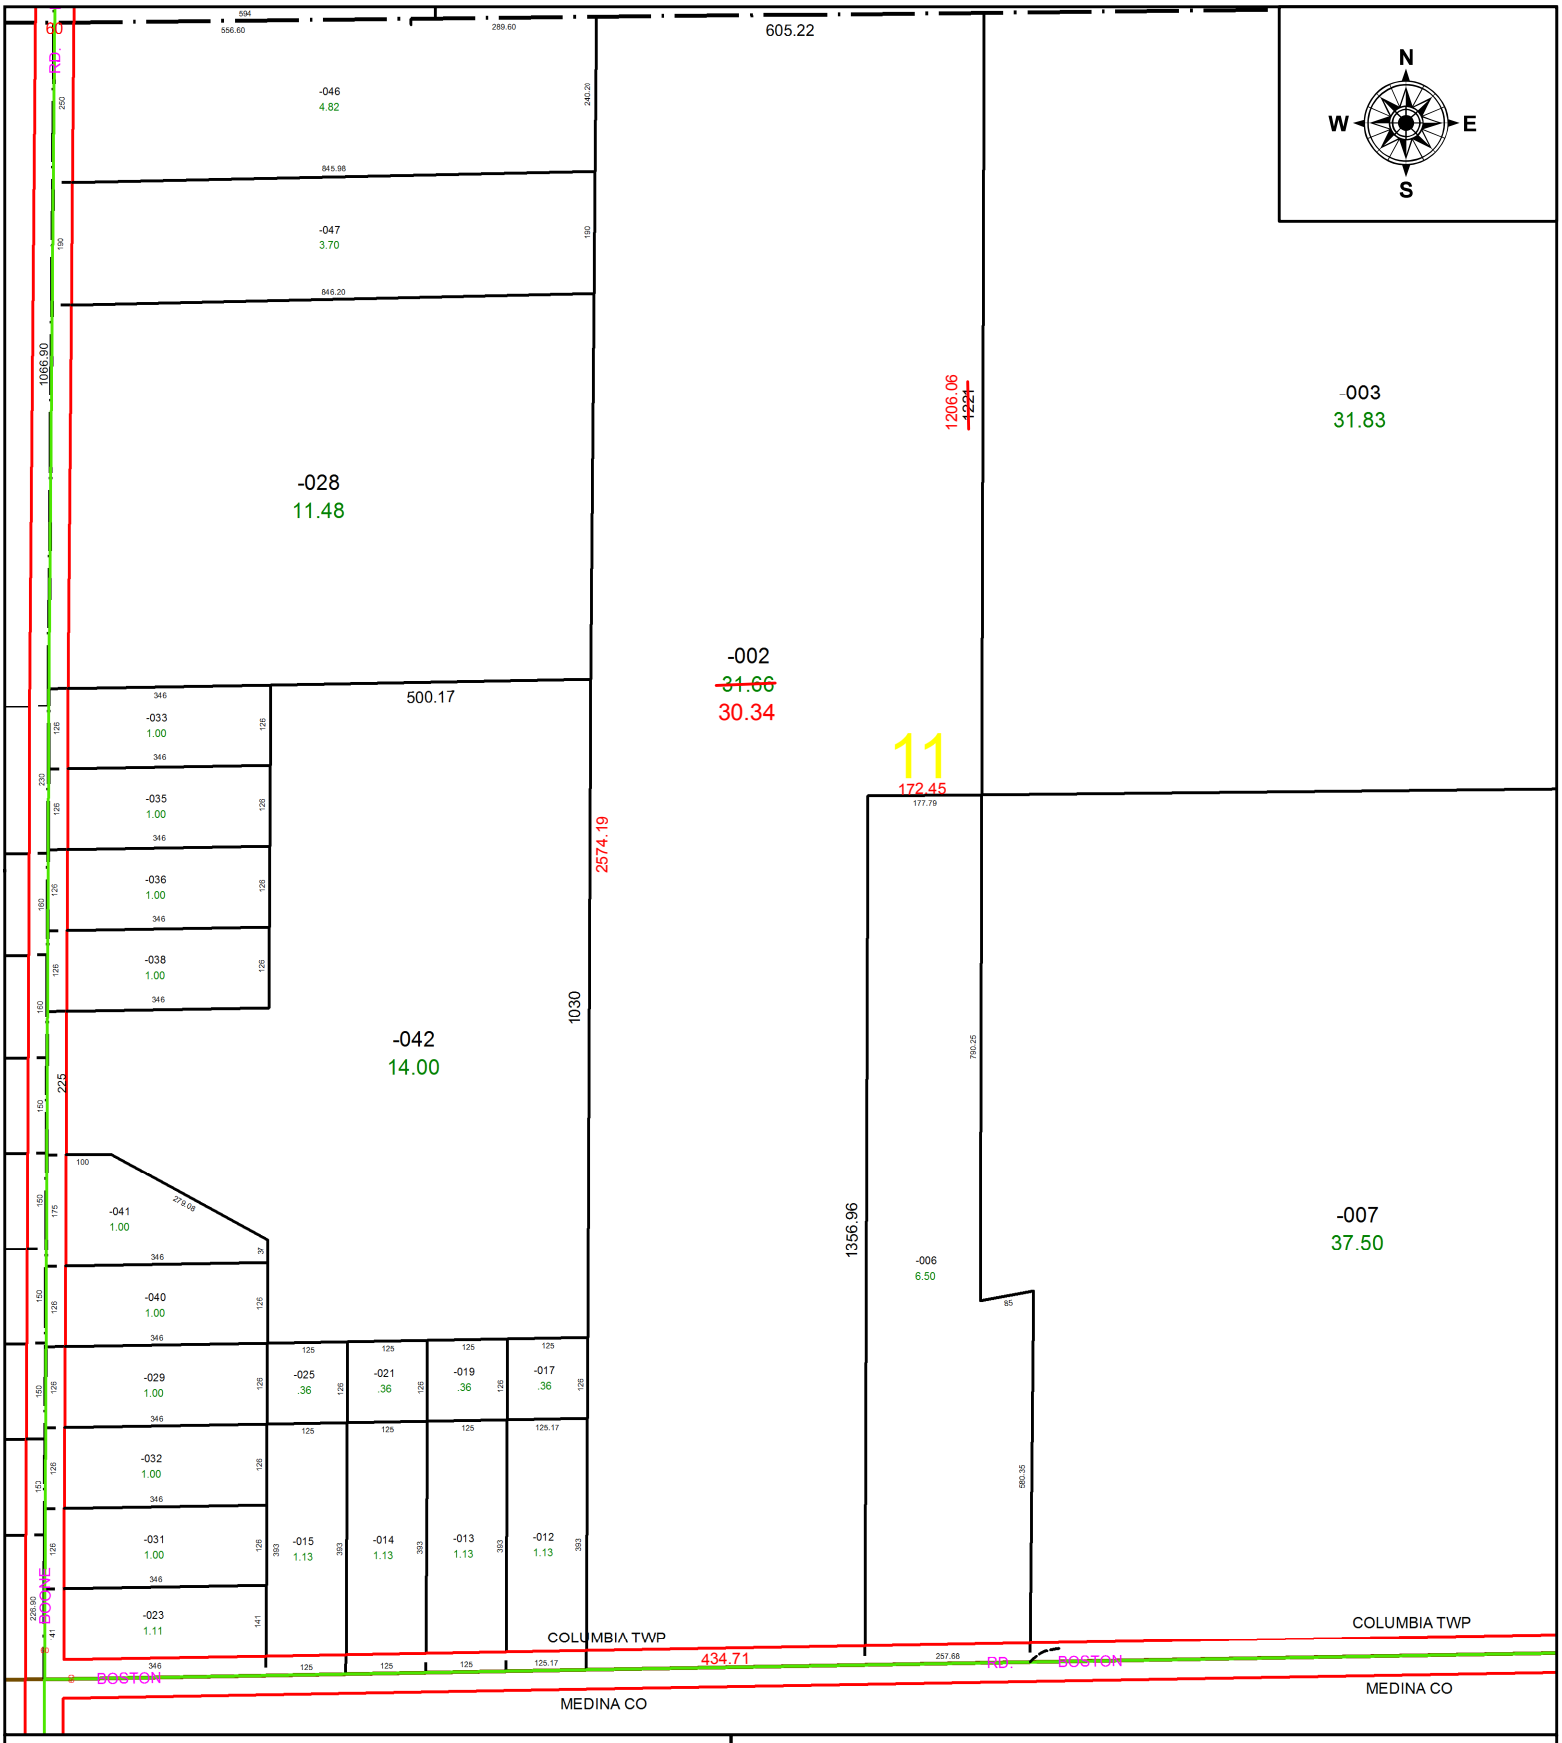

SPLITS/DEEDS PROCESSED

LORAIN COUNTY TAX MAP DEPARTMENT
226 MIDDLE AVE. ELYRIA, OH

SURVEYED BY: MICHAEL ACKERMAN
CLOSURE: 1:705,220
MAP PAGE(S): 12-00-011
APPOVED BY: WRZ **DATE:** 9/2/2021
SCALE: 1" = 300 **PRIOR INSTRUMENT:** 2017-0639724