PARENT PARCEL: 16-00-018-102-023 & -024

CHILD PARCEL: 16-00-018-102-042 N/A

STARTING POINT: SOUTHEAST CORNER OF S/L 6 IN NELSON G. HITCHCOCK ALLOTMENT NO. 1

23-04649

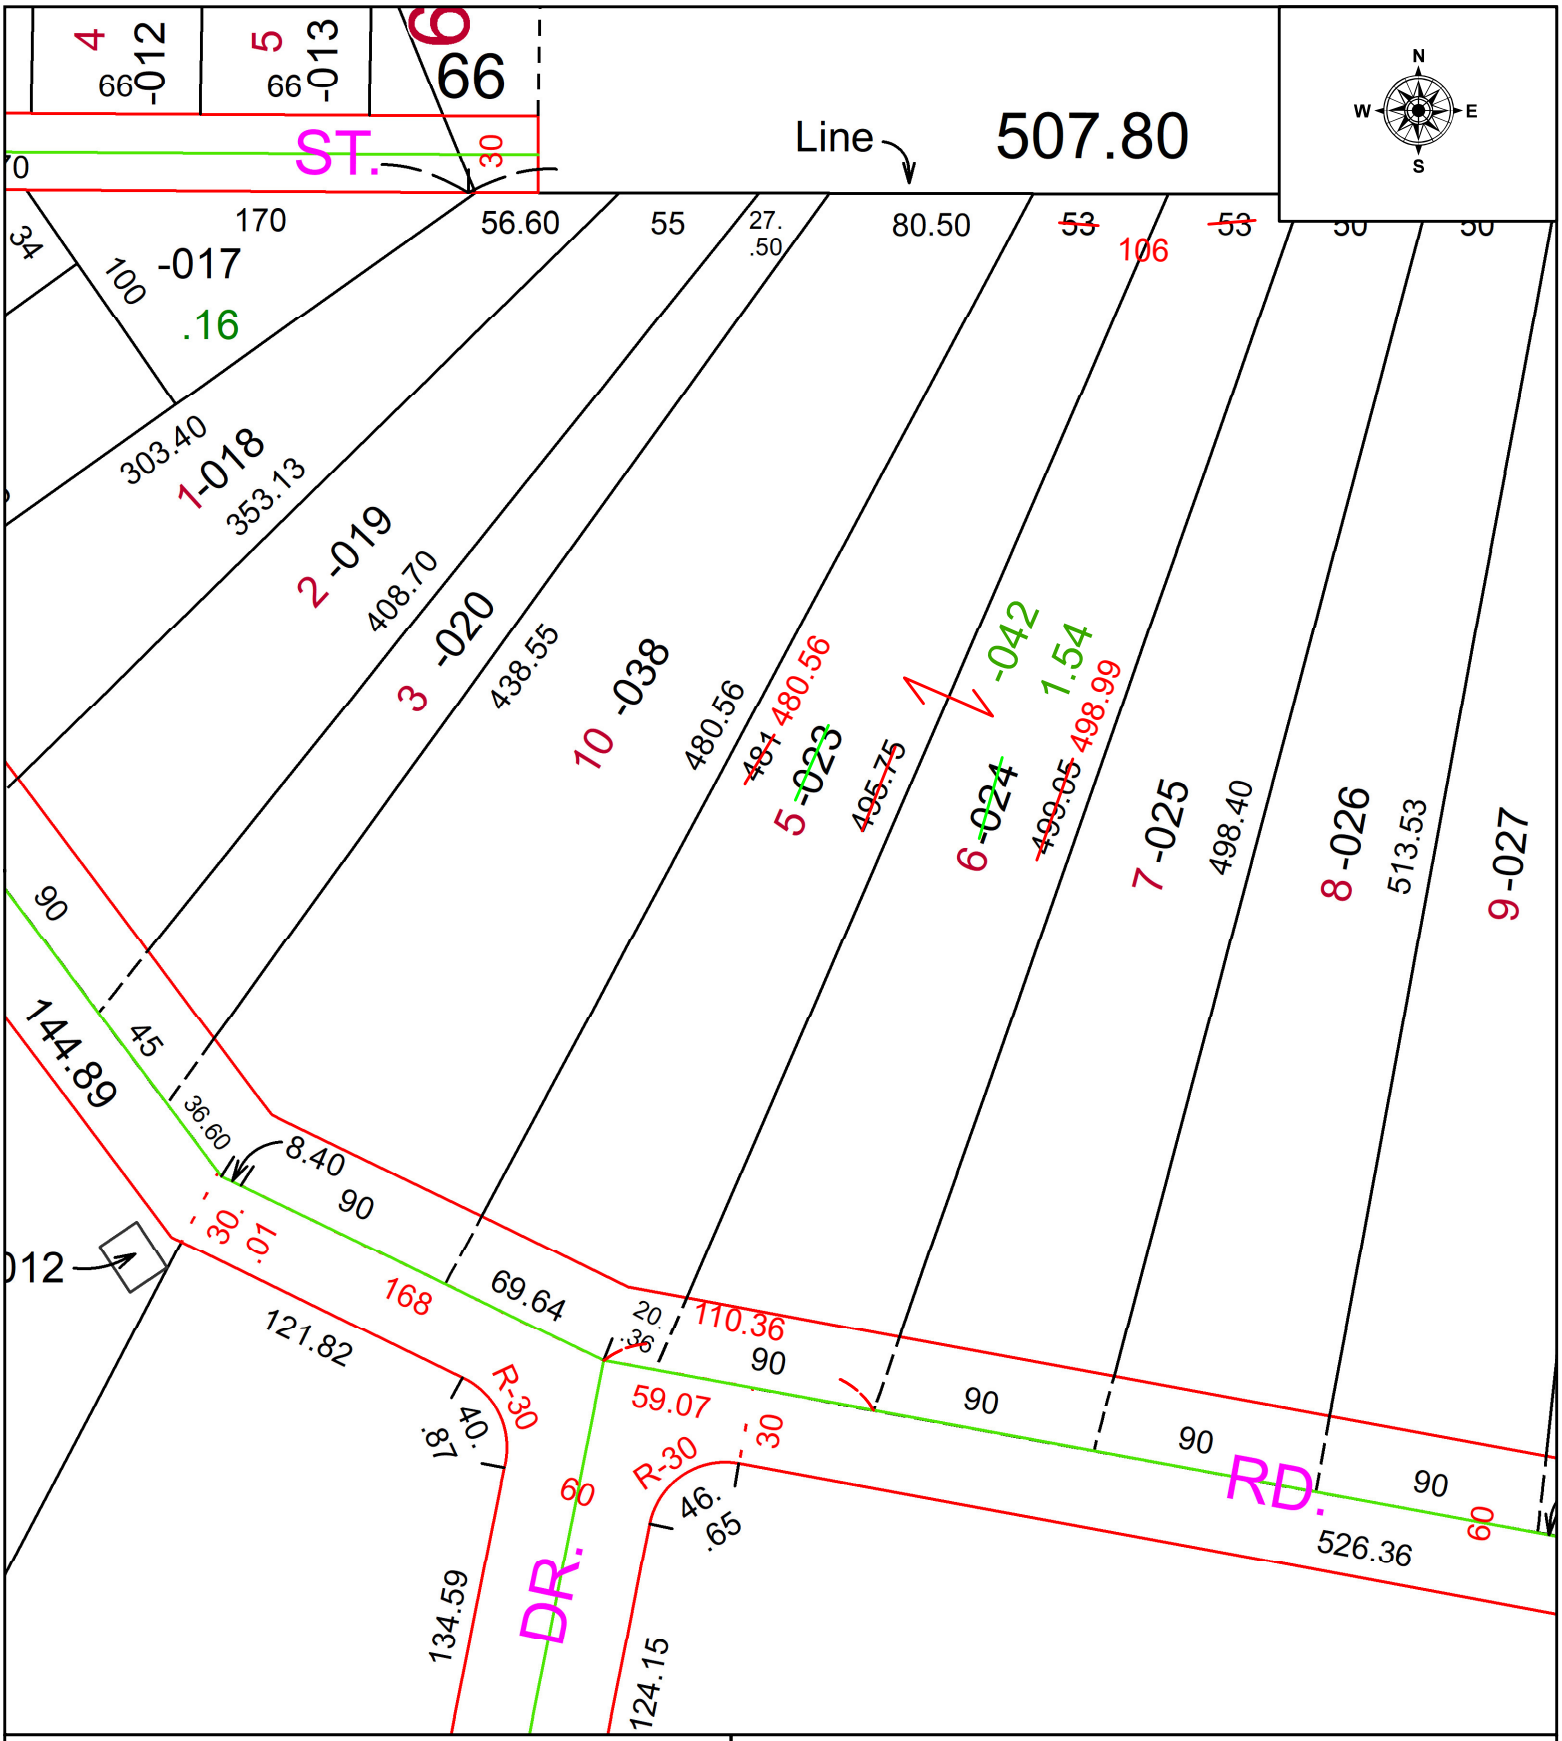

SPLITS/DEEDS PROCESSED

LORAIN COUNTY TAX MAP DEPARTMENT
226 MIDDLE AVE. ELYRIA, OH

SURVEYED BY: WILFREDO BARBOSA SURVEY # 50829

CLOSURE: 1: 4533522

MAP PAGE(S): 16-00-018

APPOVED BY: WRZ **DATE:** 3/6/2023

SCALE: 1" = 75 **PRIOR INSTRUMENT:** #2022-0866651