PARENT PARCEL: 05-00-003-106-026
CHILD PARCEL: 05-00-003-106-032 & -033
STARTING POINT: AC CORR PER SURV BY THOMAS P. BAUMANN

23-04650

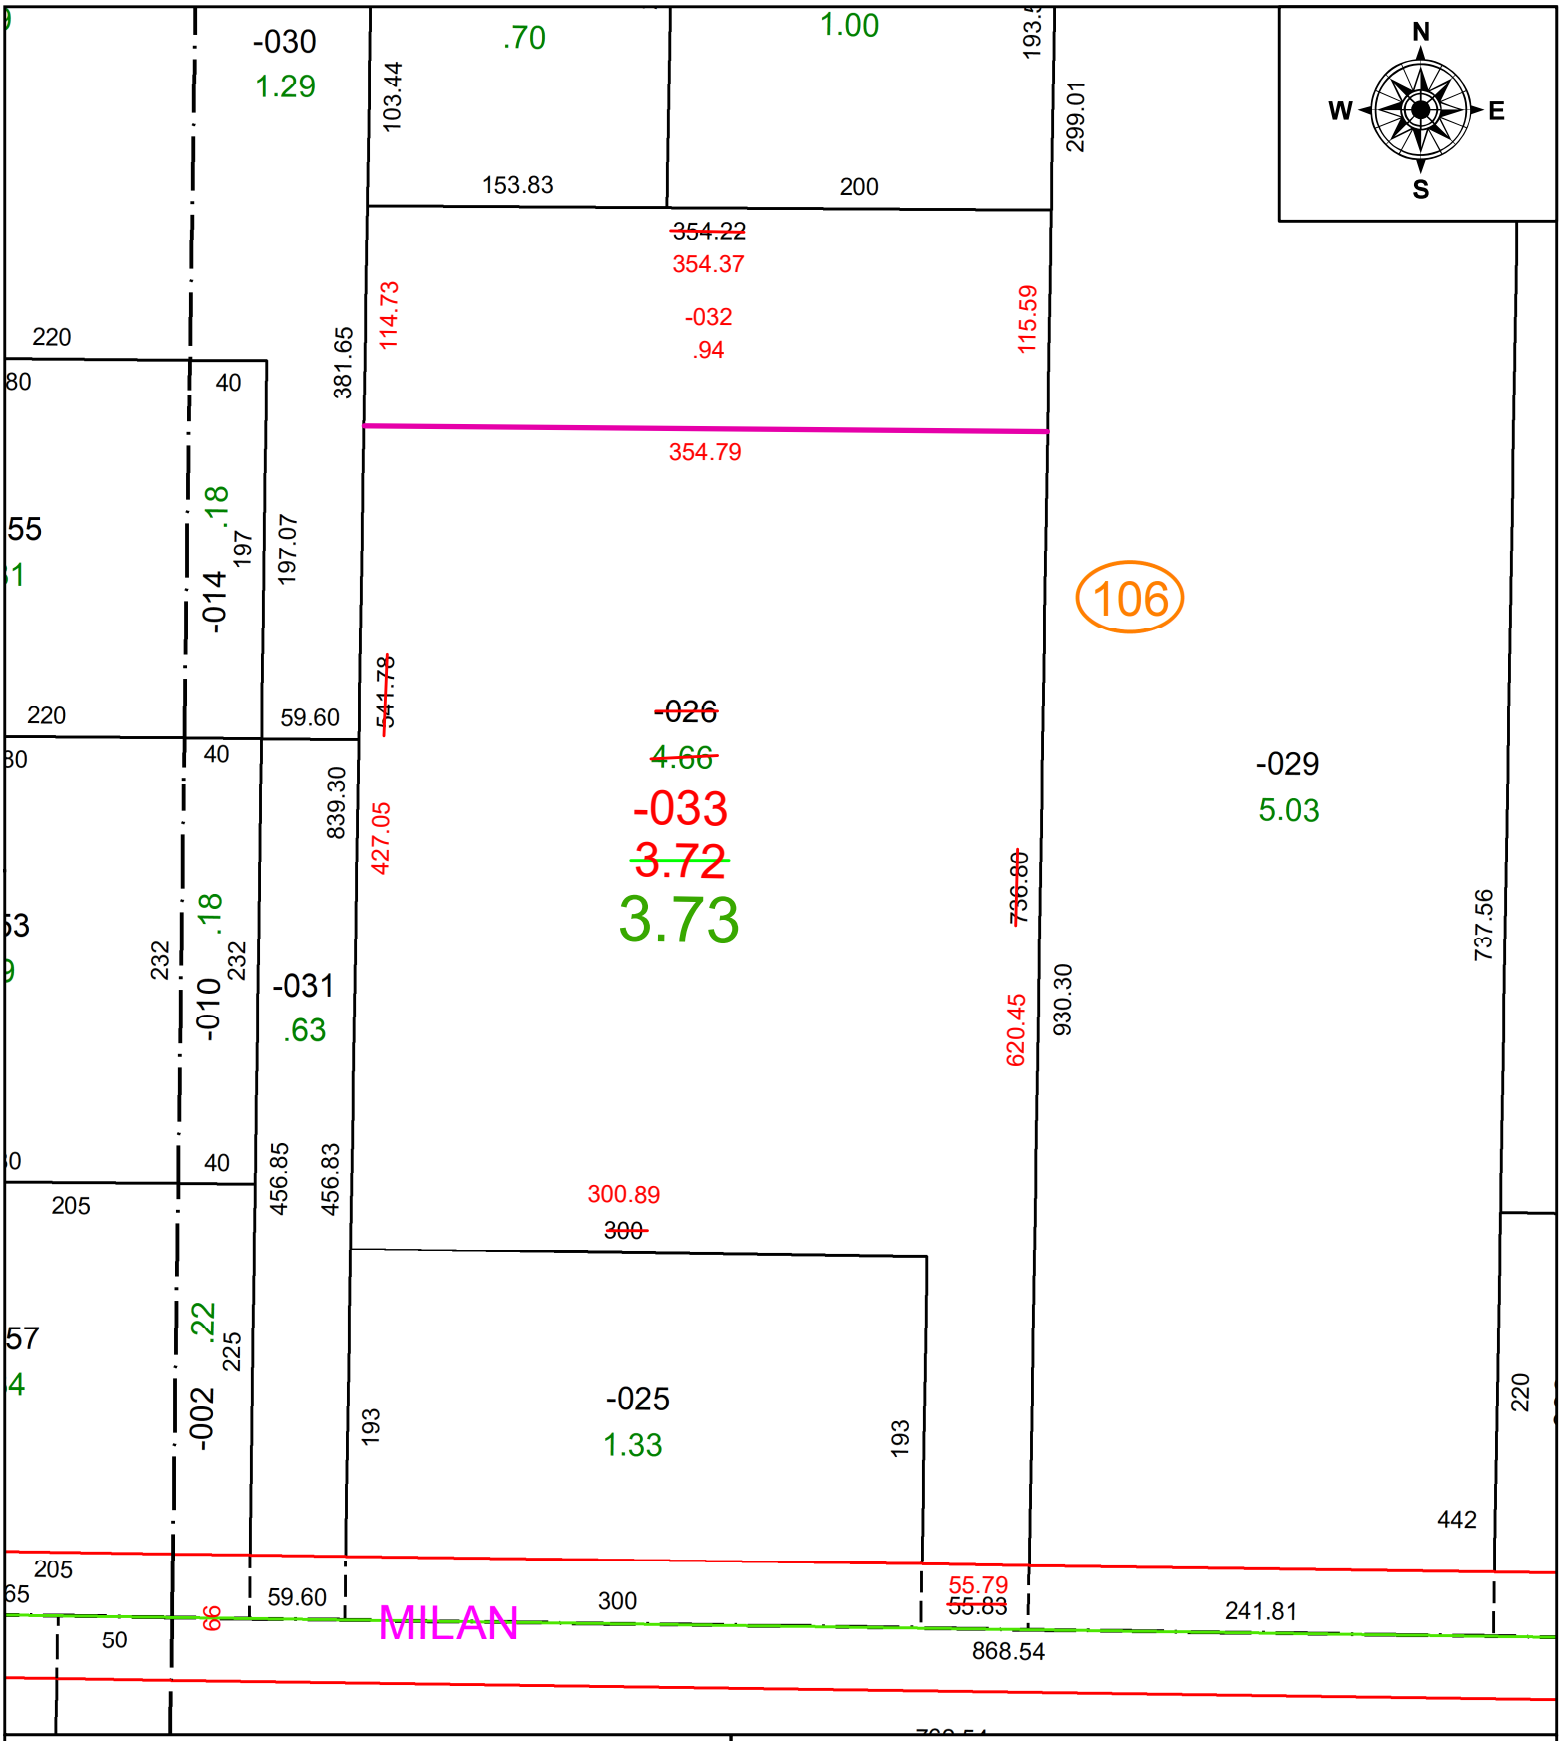

SPLITS/DEEDS PROCESSED
LORAIN COUNTY TAX MAP DEPARTMENT
226 MIDDLE AVE. ELYRIA, OH

SURVEYED BY: THOMAS P. BAUMANN **SURV # 50832**
CLOSURE: 1: 129083
MAP PAGE(S): 05-00-003
APPOVED BY: AC **DATE:** March 07, 2023
SCALE: 1 in = 100 ft **PRIOR INSTRUMENT:** VOL: 1087 PG: 81