PARENT PARCEL: 06-25-020-108-001
CHILD PARCEL: N/A
STARTING POINT: ACREAGE CORRECTION PER PRIOR DEED INSTR. # 2018-0669524

21-04659-C

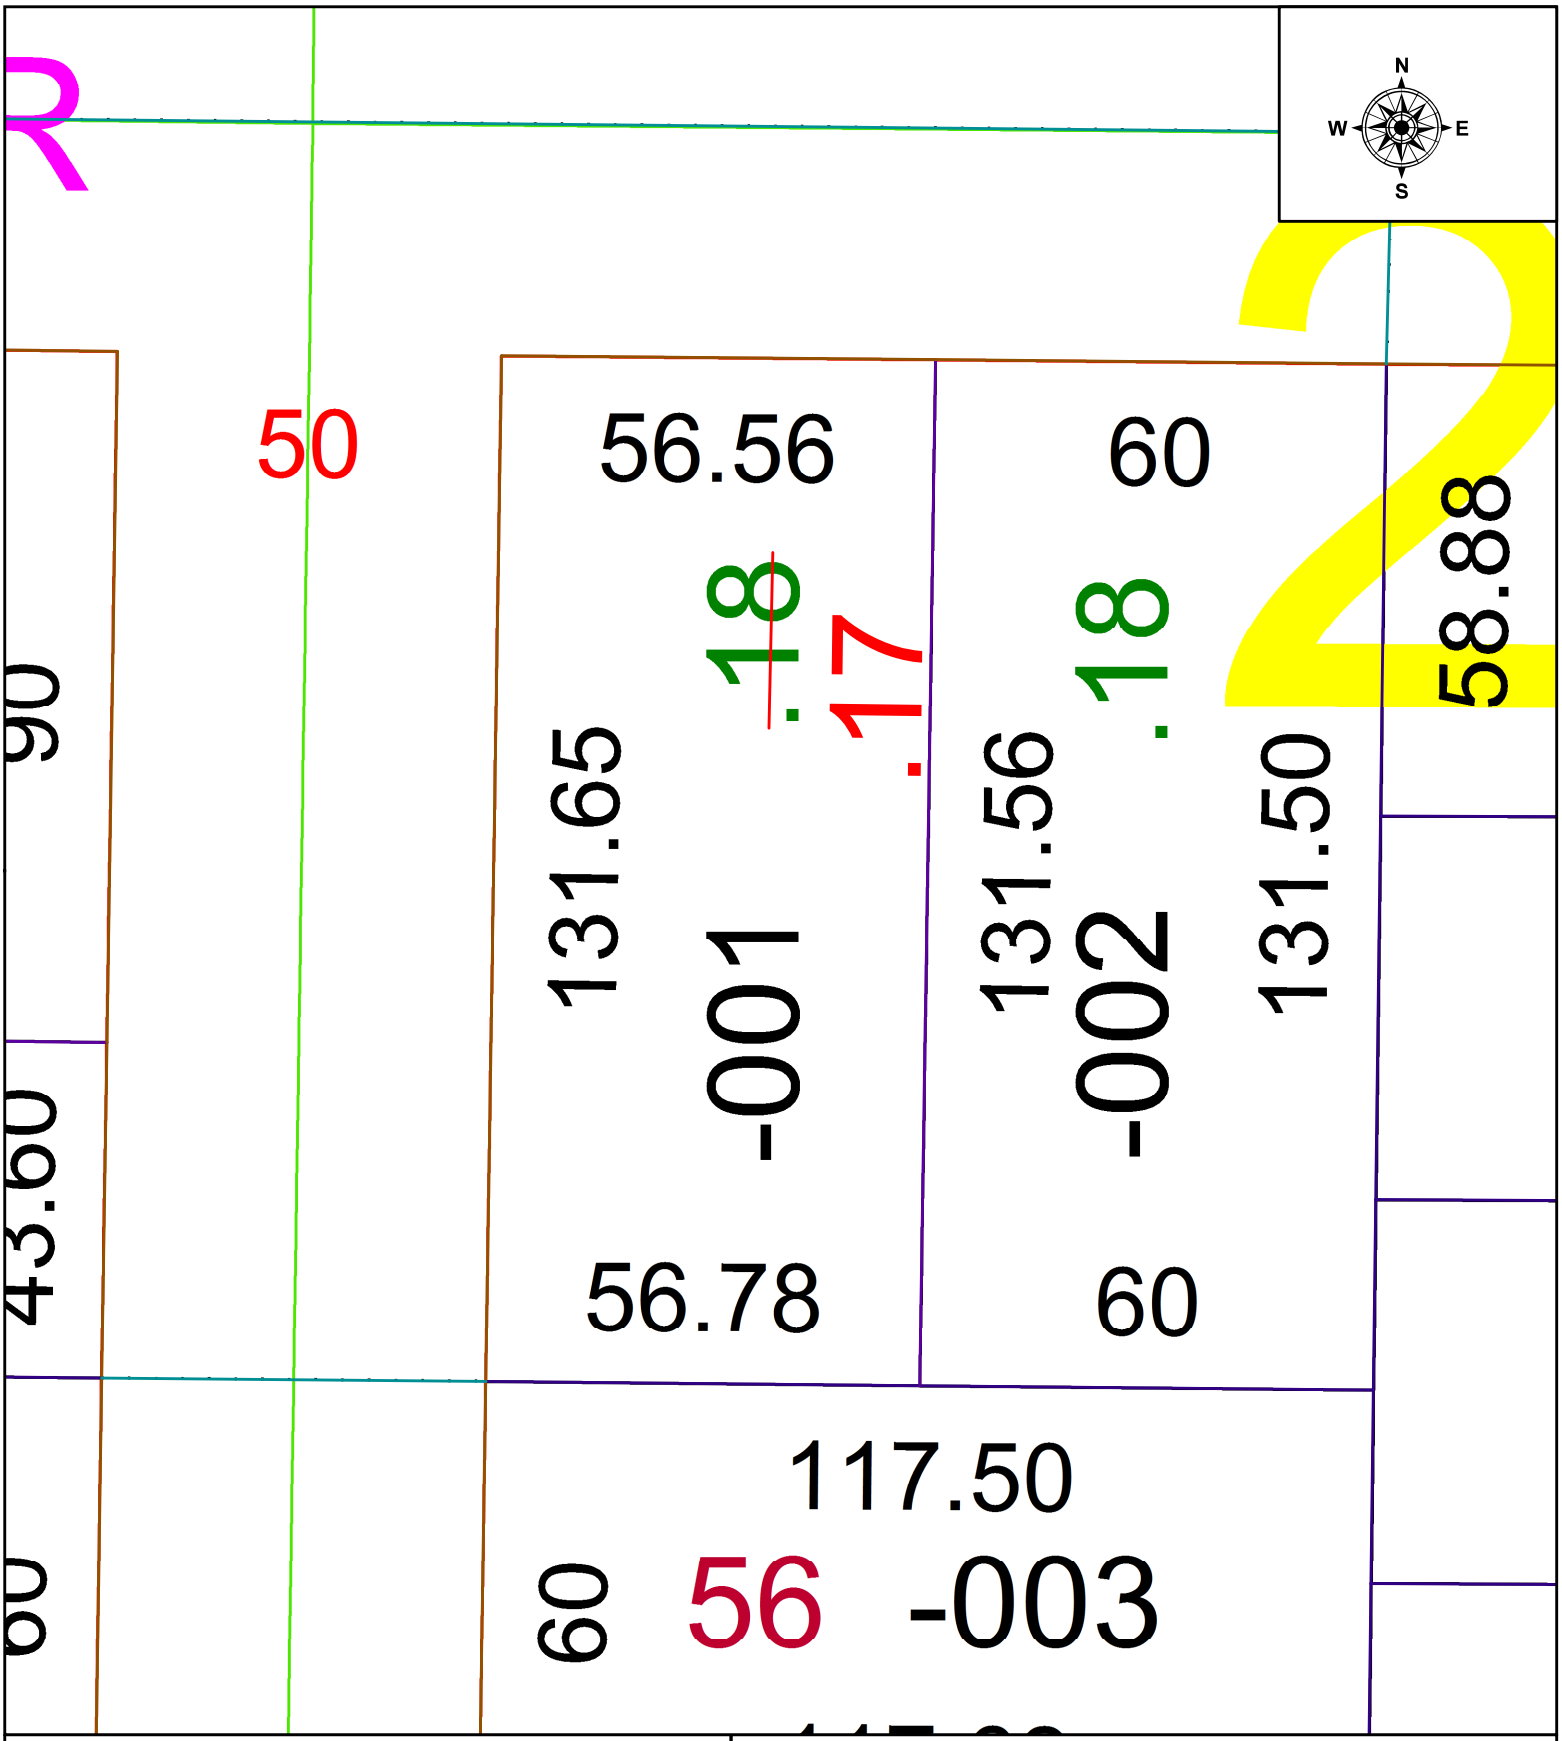

SPLITS/DEEDS PROCESSED
LORAIN COUNTY TAX MAP DEPARTMENT
226 MIDDLE AVE. ELYRIA, OH

SURVEYED BY: N/A
CLOSURE: N/A
MAP PAGE(S): 06-25-020
APPOVED BY: WRZ **DATE:** 9/14/2021
SCALE: 1" = 25 **PRIOR INSTRUMENT:** 2018-0669524