PARENT PARCEL: 16-00-013-000-034

CHILD PARCEL: AC. CORR. PER SURVEY LOUIS GIFFELS

STARTING POINT: CL OF GRAFTON EASTERN RD & ISLAND RD.

21-04660-A

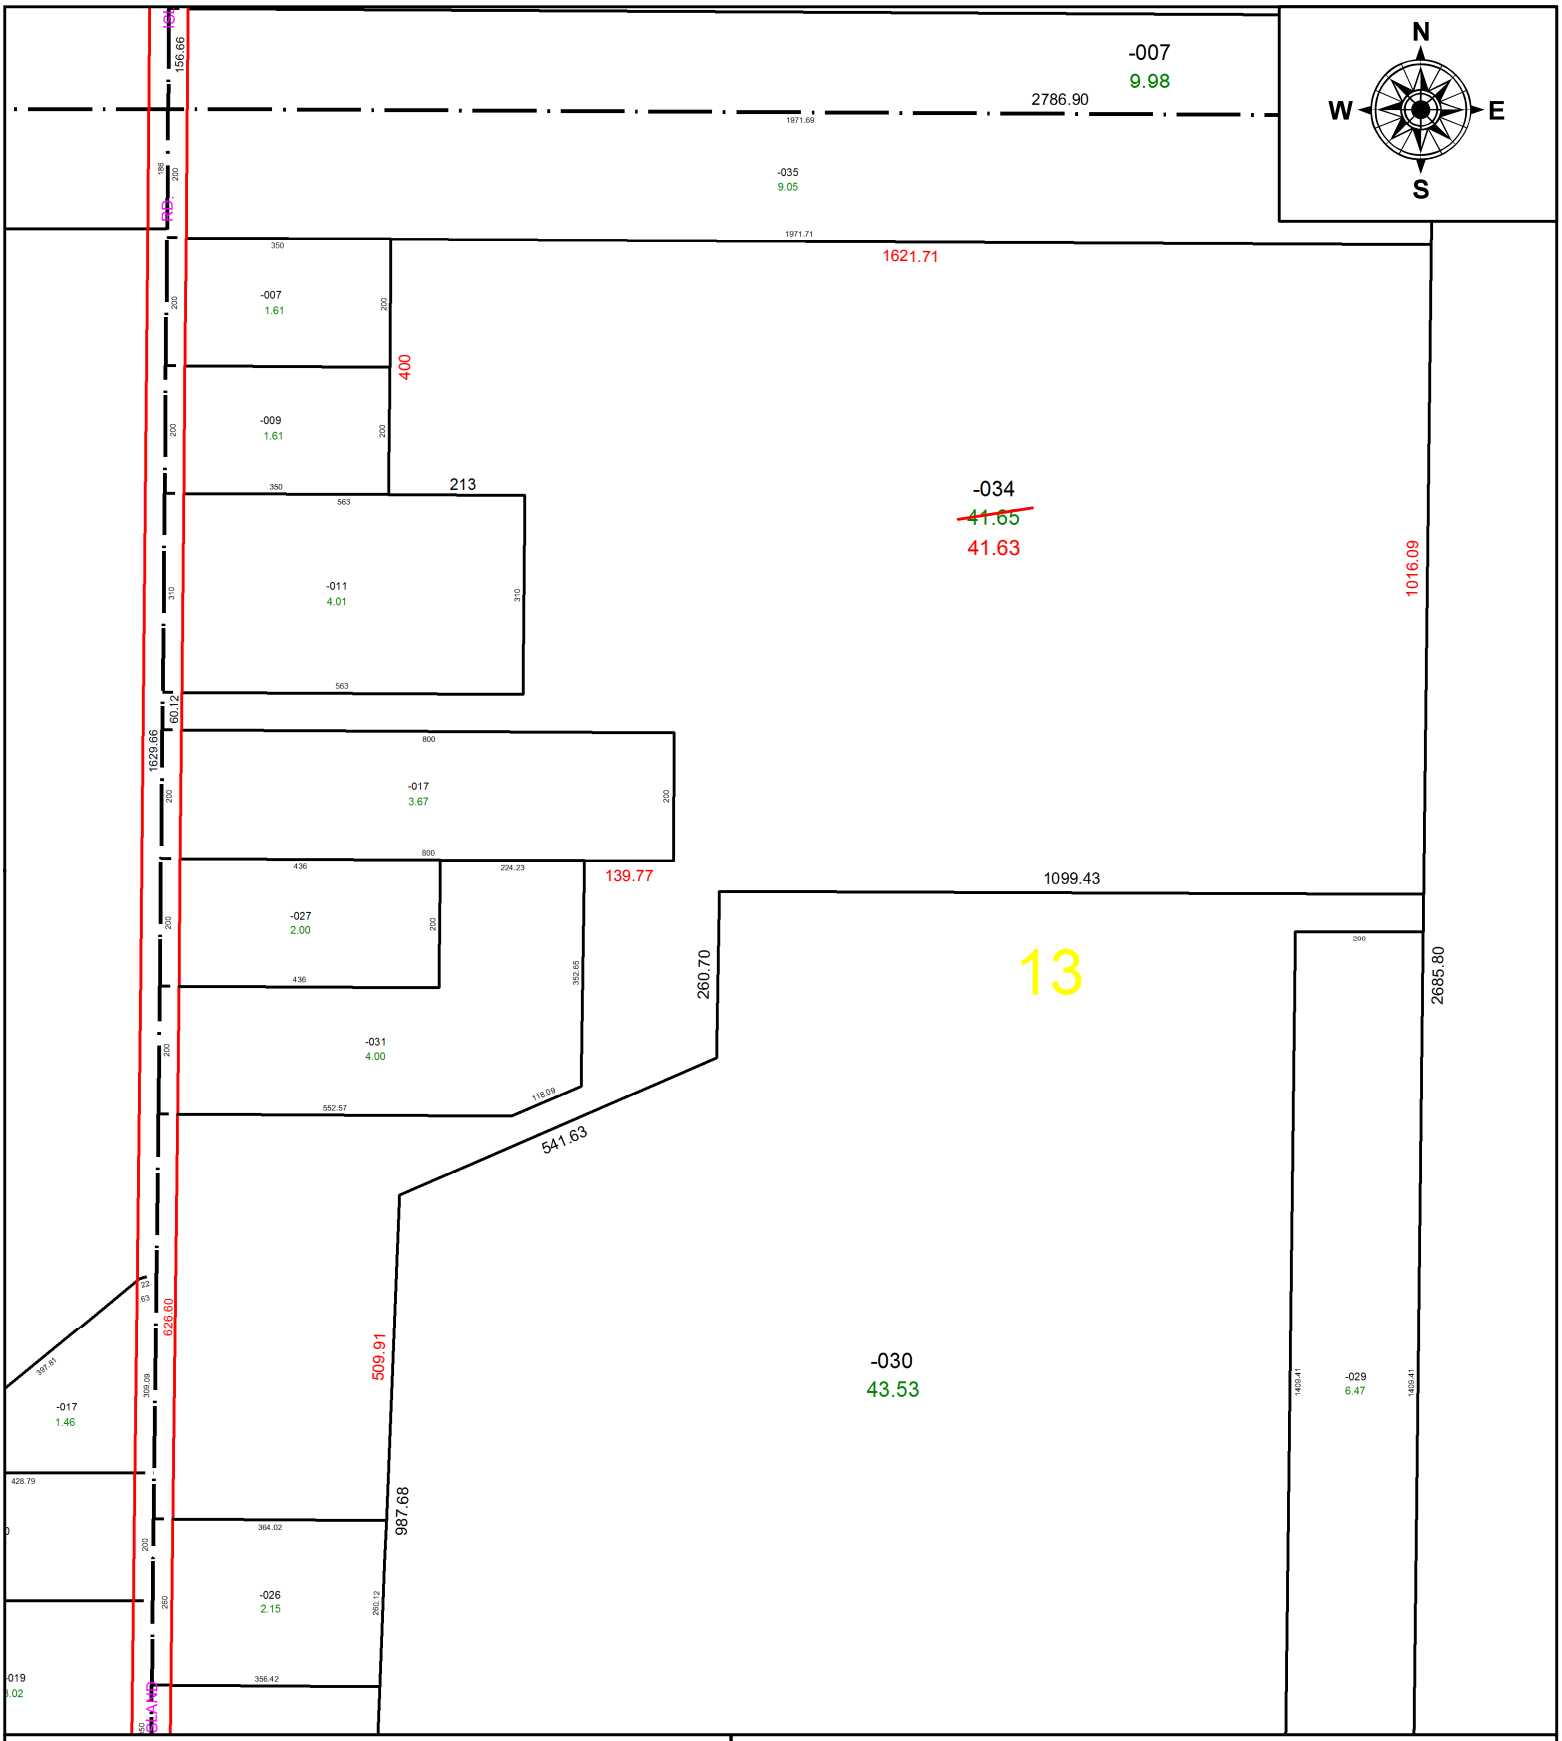

SPLITS/DEEDS PROCESSED

LORAIN COUNTY TAX MAP DEPARTMENT
226 MIDDLE AVE. ELYRIA, OH

SURVEYED BY: LOUIS GIFFELS
CLOSURE: 1: 862048
MAP PAGE(S): 16-00-013
APPOVED BY: DMA **DATE:** 9/15/2021
SCALE: 1" = 300' **PRIOR INSTRUMENT:** 20140509794