PARENT PARCEL: 06-25-035-108-008

CHILD PARCEL: FRONTAGE & DEPTH TO ACREAGE CORRECTION PER SURV BY JOSHUA S. RIEDY

STARTING POINT: SE CORNER OF SUBLOT 2 RECORDED PLAT VOL 6 PG 22

21-04662-C

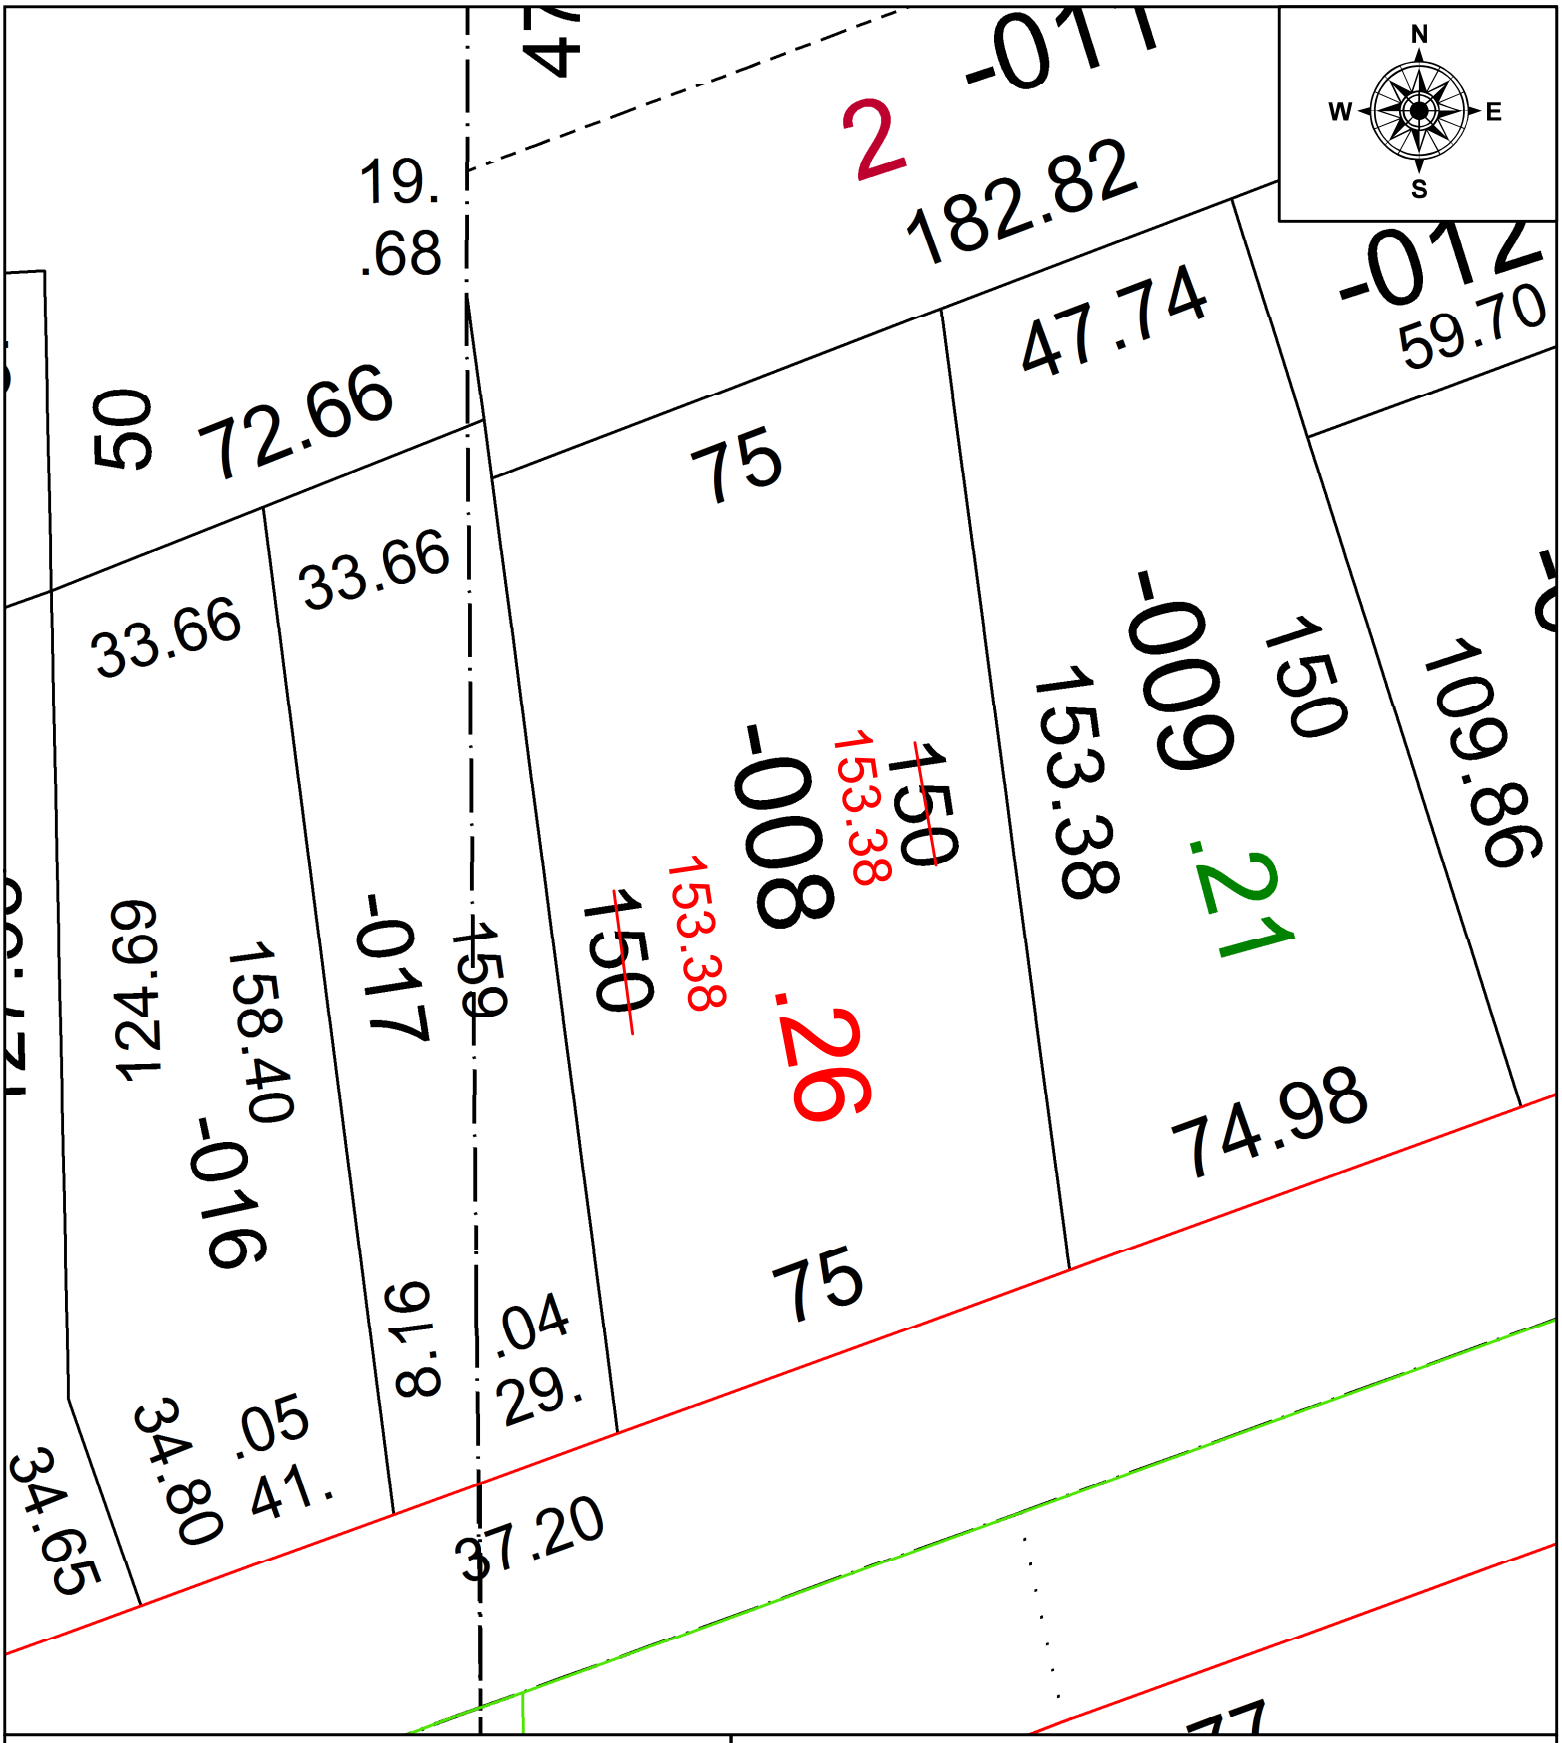

SPLITS/DEEDS PROCESSED

LORAIN COUNTY TAX MAP DEPARTMENT
226 MIDDLE AVE. ELYRIA, OH

SURVEYED BY: JOSHUA S. RIEDY
CLOSURE: 1: 2147483648
MAP PAGE(S): 06-25-035
APPOVED BY: AC **DATE:** 9/20/2021
SCALE: 1" = 30 **PRIOR INSTRUMENT:** 2017- 0644162