PARENT PARCEL: 10-00-001-101-020

CHILD PARCEL: 10-00-001-101-102 & -103

STARTING POINT: CL OF RUSSIA RD. & WEST RIDGE RD.

23-04663

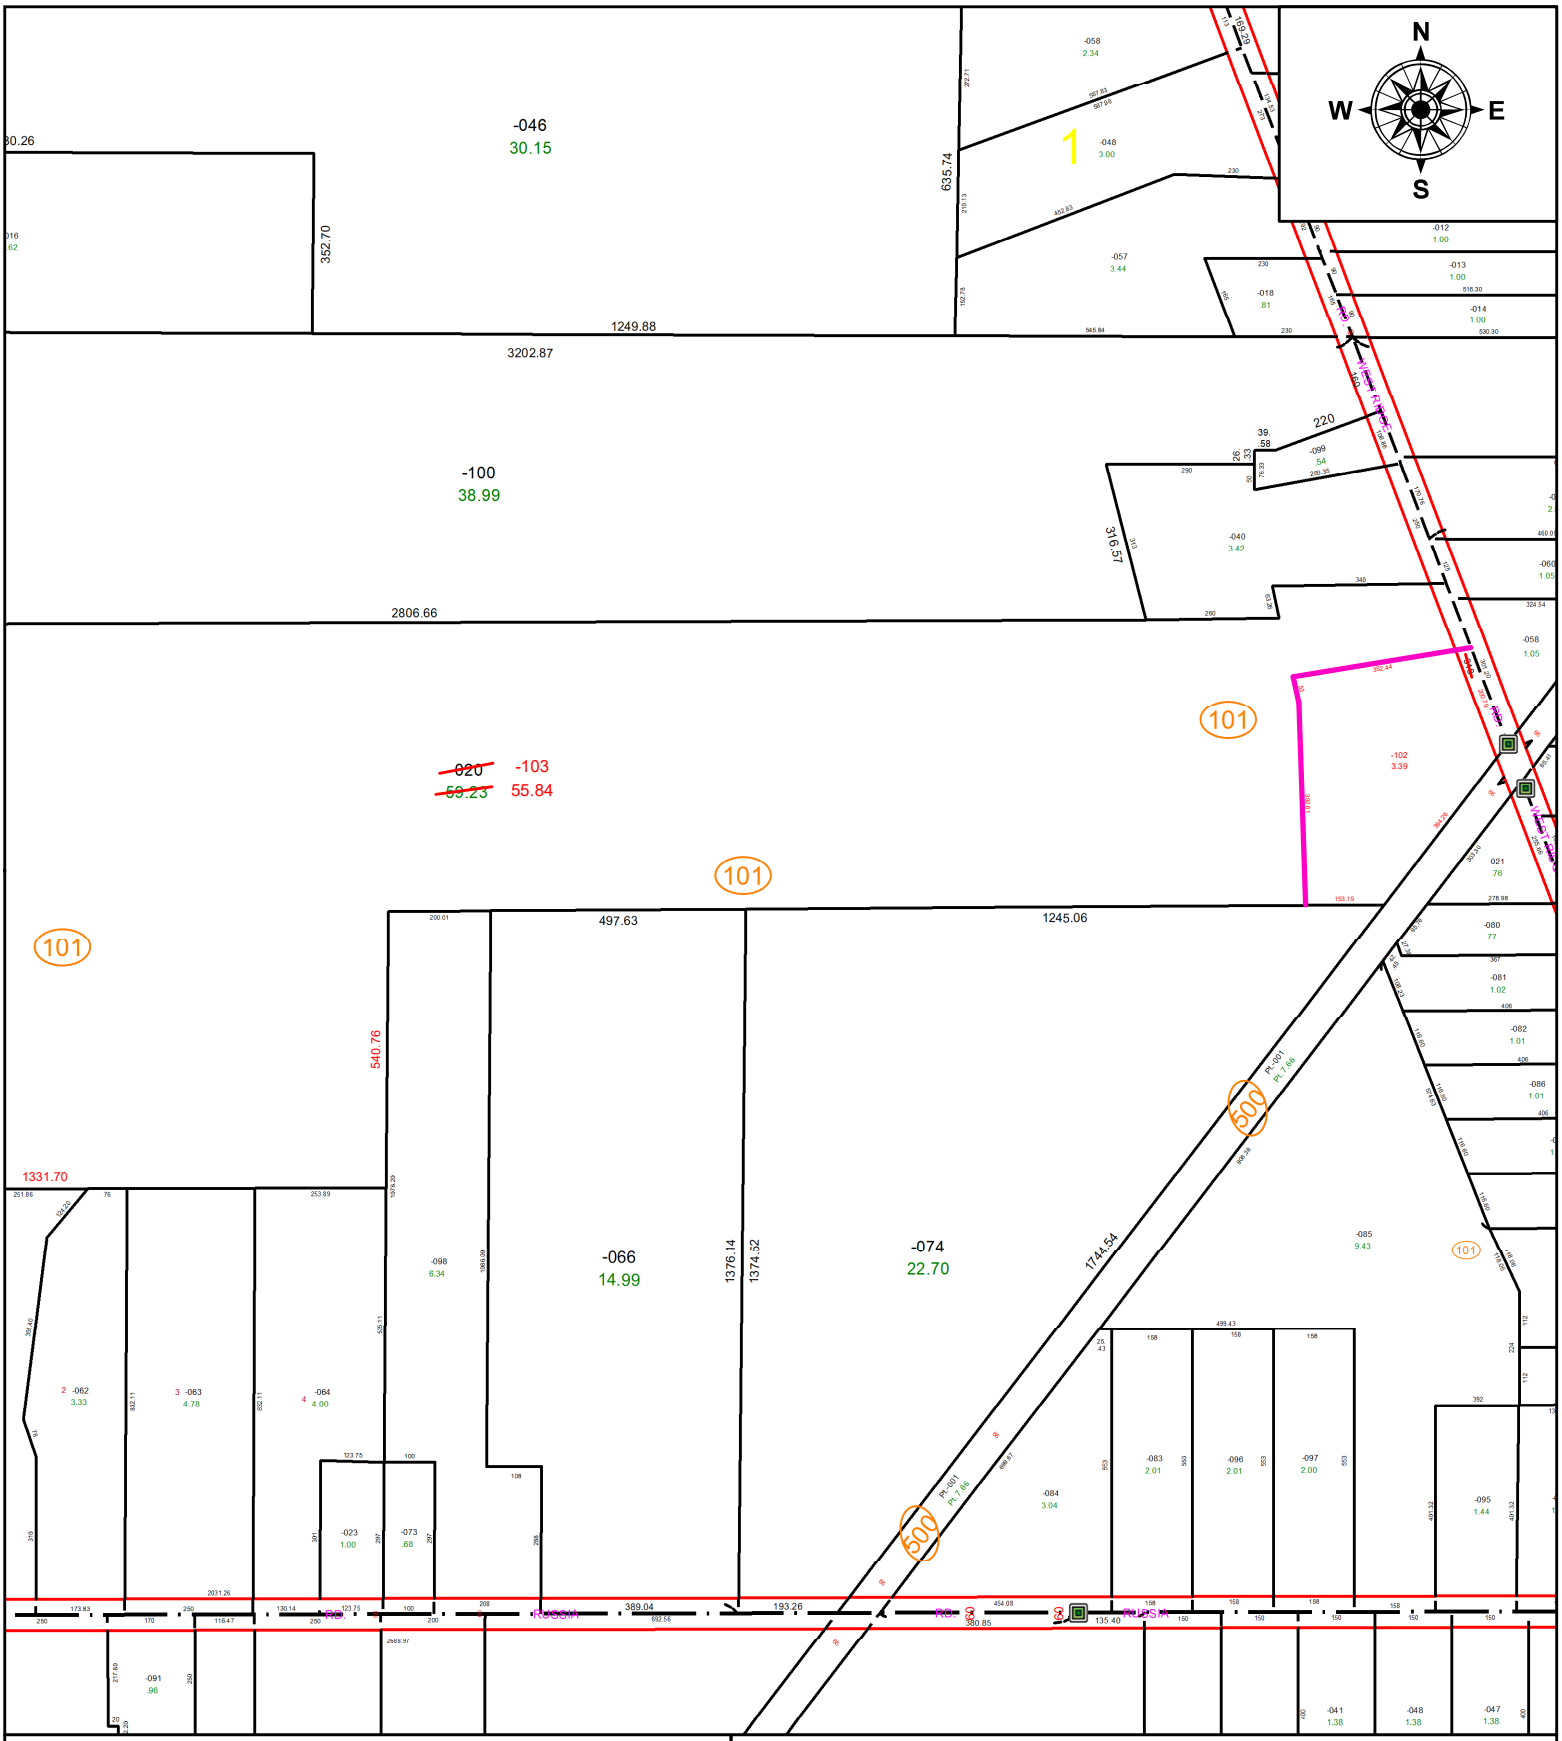

SPLITS/DEEDS PROCESSED

LORAIN COUNTY TAX MAP DEPARTMENT
226 MIDDLE AVE. ELYRIA, OH

SURVEYED BY: JOSHUA RIEDY **SURVEY #:** 50845

CLOSURE: 1:216376

MAP PAGE(S): 10-00-001

APPOVED BY: DMA **DATE:** 3/23/2023

SCALE: 1" = 375' **PRIOR INSTRUMENT:** 2022-0900503