PARENT PARCEL: 03-00-097-106-014, -015, 03-00-098-121-035, & -036

CHILD PARCEL: 03-00-097-106-016 & 03-00-098-121-037 N/A

STARTING POINT: R.O.W. INTERSECTION OF OMAHA AVE & EAST 32ND ST

23-04664

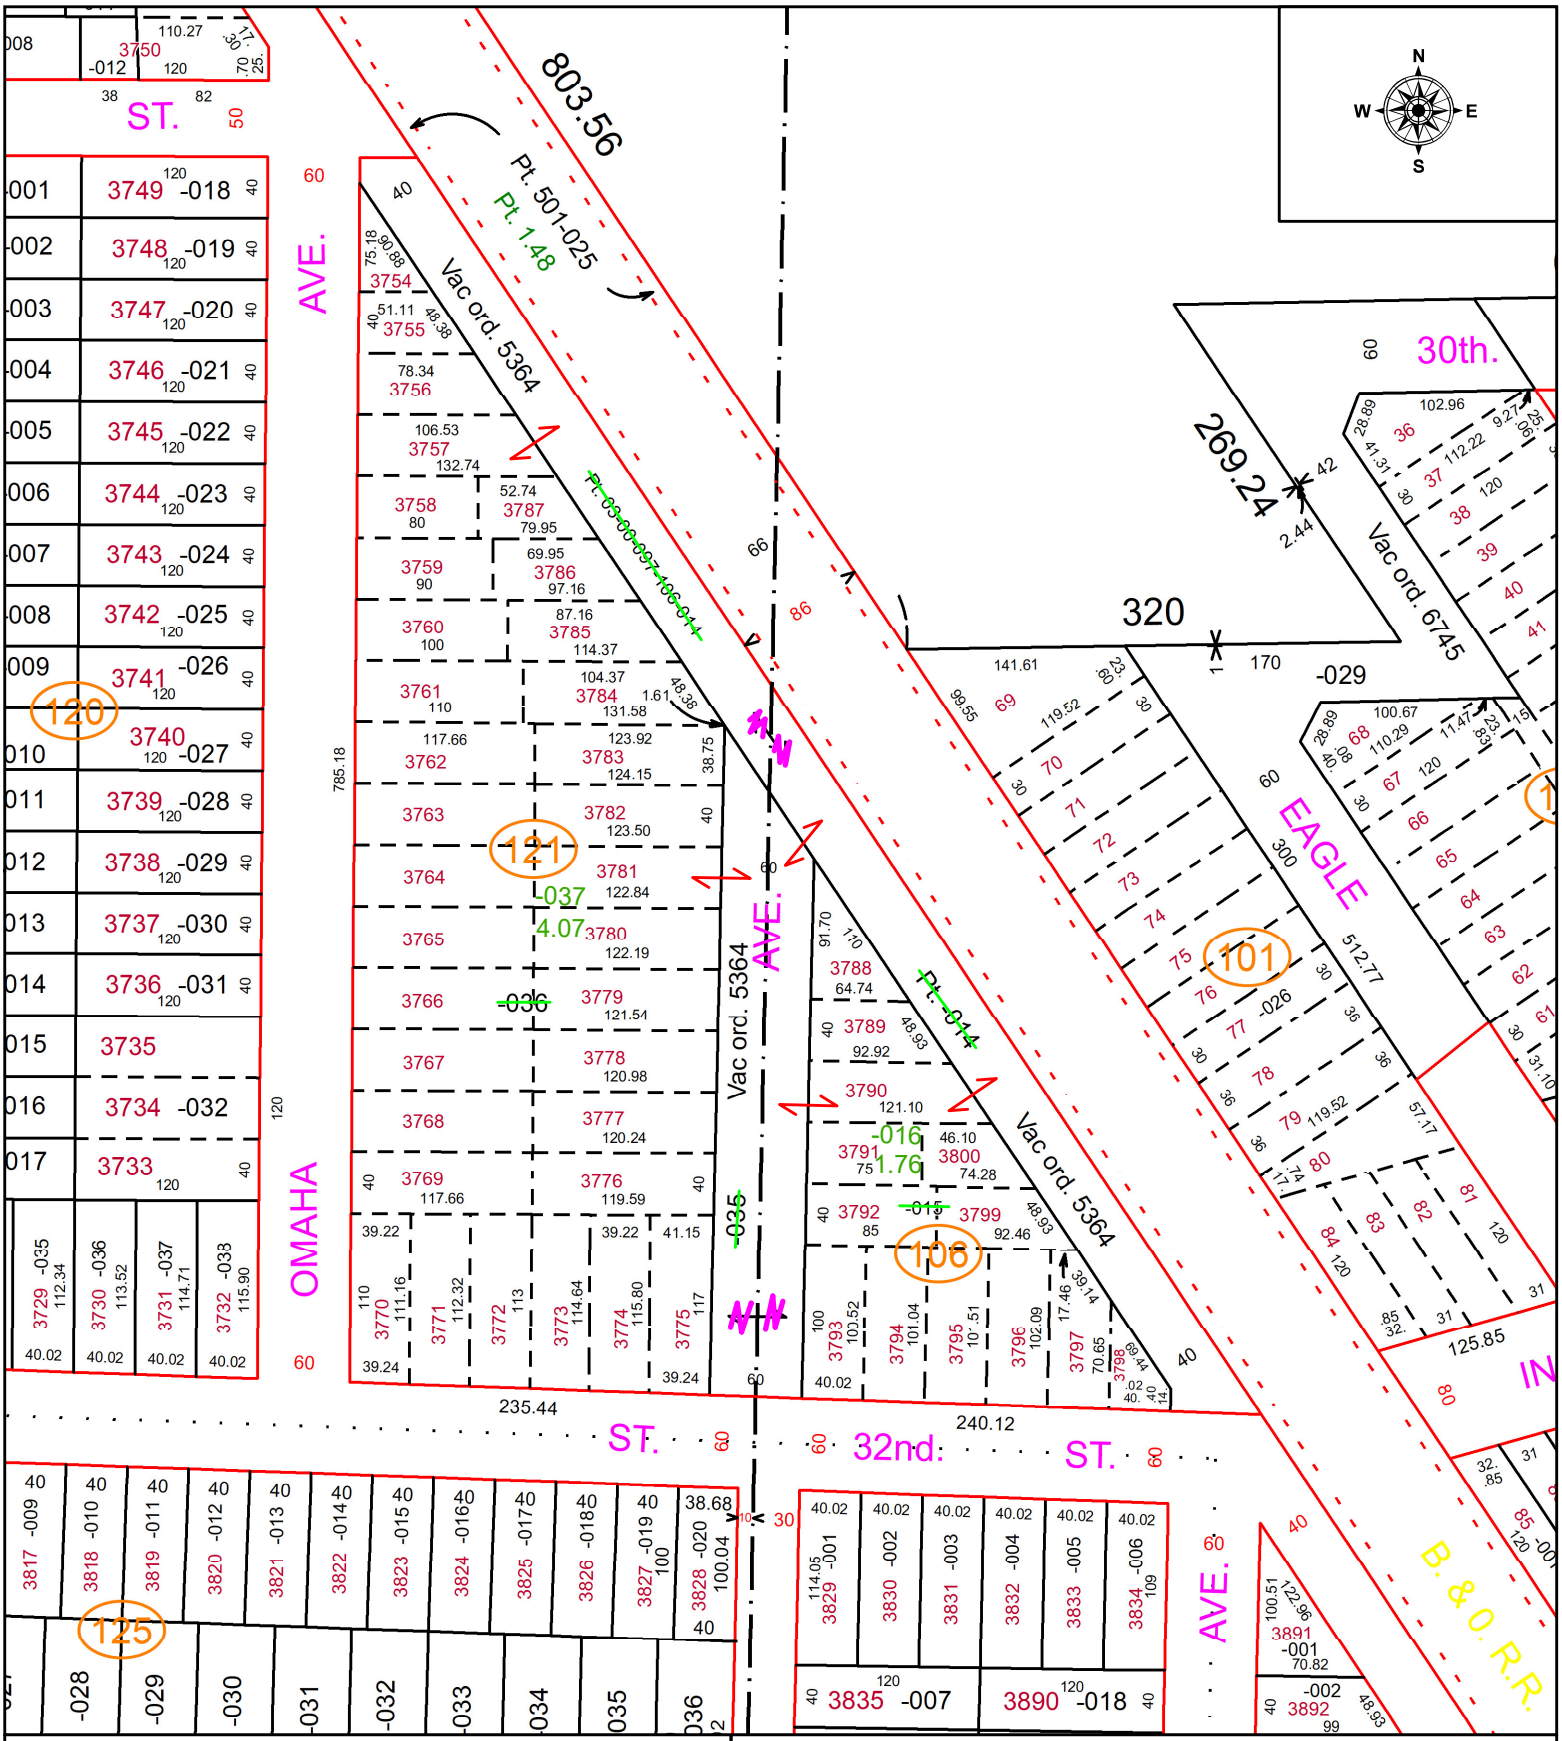

SPLITS/DEEDS PROCESSED

LORAIN COUNTY TAX MAP DEPARTMENT
226 MIDDLE AVE. ELYRIA, OH

SURVEYED BY: WILLIAM WALLACE SURVEY # 50846

CLOSURE: 1: 1310805

MAP PAGE(S): 03-00-097 & 03-00-098

APPOVED BY: WRZ **DATE:** 3/24/2023

SCALE: 1" = 125 **PRIOR INSTRUMENT:** #2012-0442463