PARENT PARCEL: ADD TO DUPLICATE

CHILD PARCEL: 12-00-085-630-002 GAS WELL # 34093201700000

STARTING POINT: NA

21-04666-A

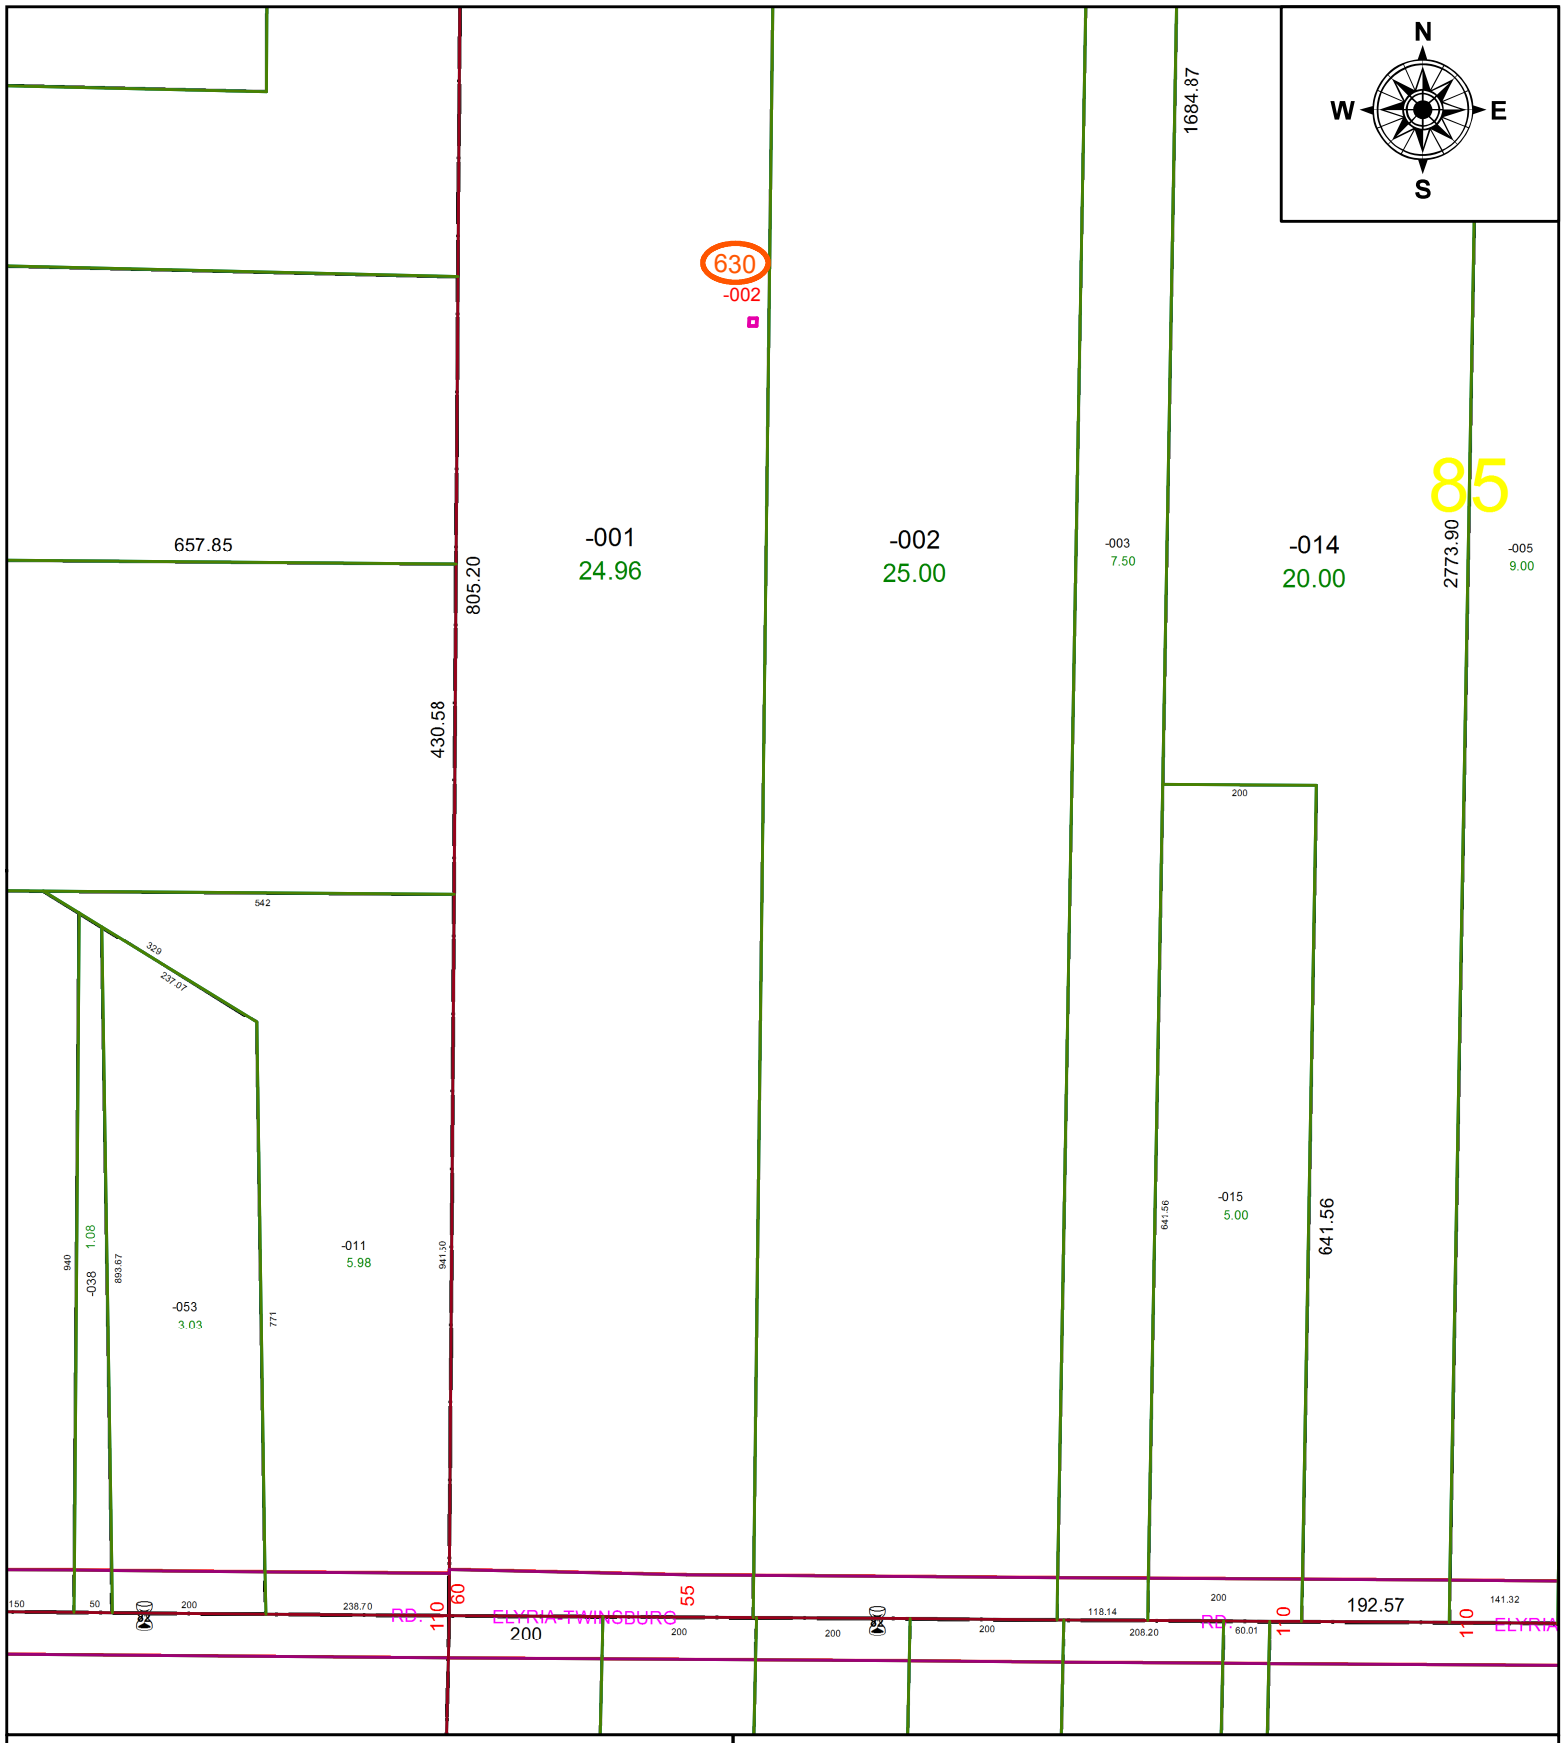

SPLITS/DEEDS PROCESSED

LORAIN COUNTY TAX MAP DEPARTMENT
226 MIDDLE AVE. ELYRIA, OH

SURVEYED BY: NA
CLOSURE: NA
MAP PAGE(S): 12-00-085
APPOVED BY: TJS **DATE:** 9/20/2021
SCALE: 1" = 250' **PRIOR INSTRUMENT:** NA