PARENT PARCEL: 04-00-010-116-032
CHILD PARCEL: MAP CORRECTION ONLY
STARTING POINT: C/L OF STONEY RIDGE AND DETROIT RD

21-04667-D

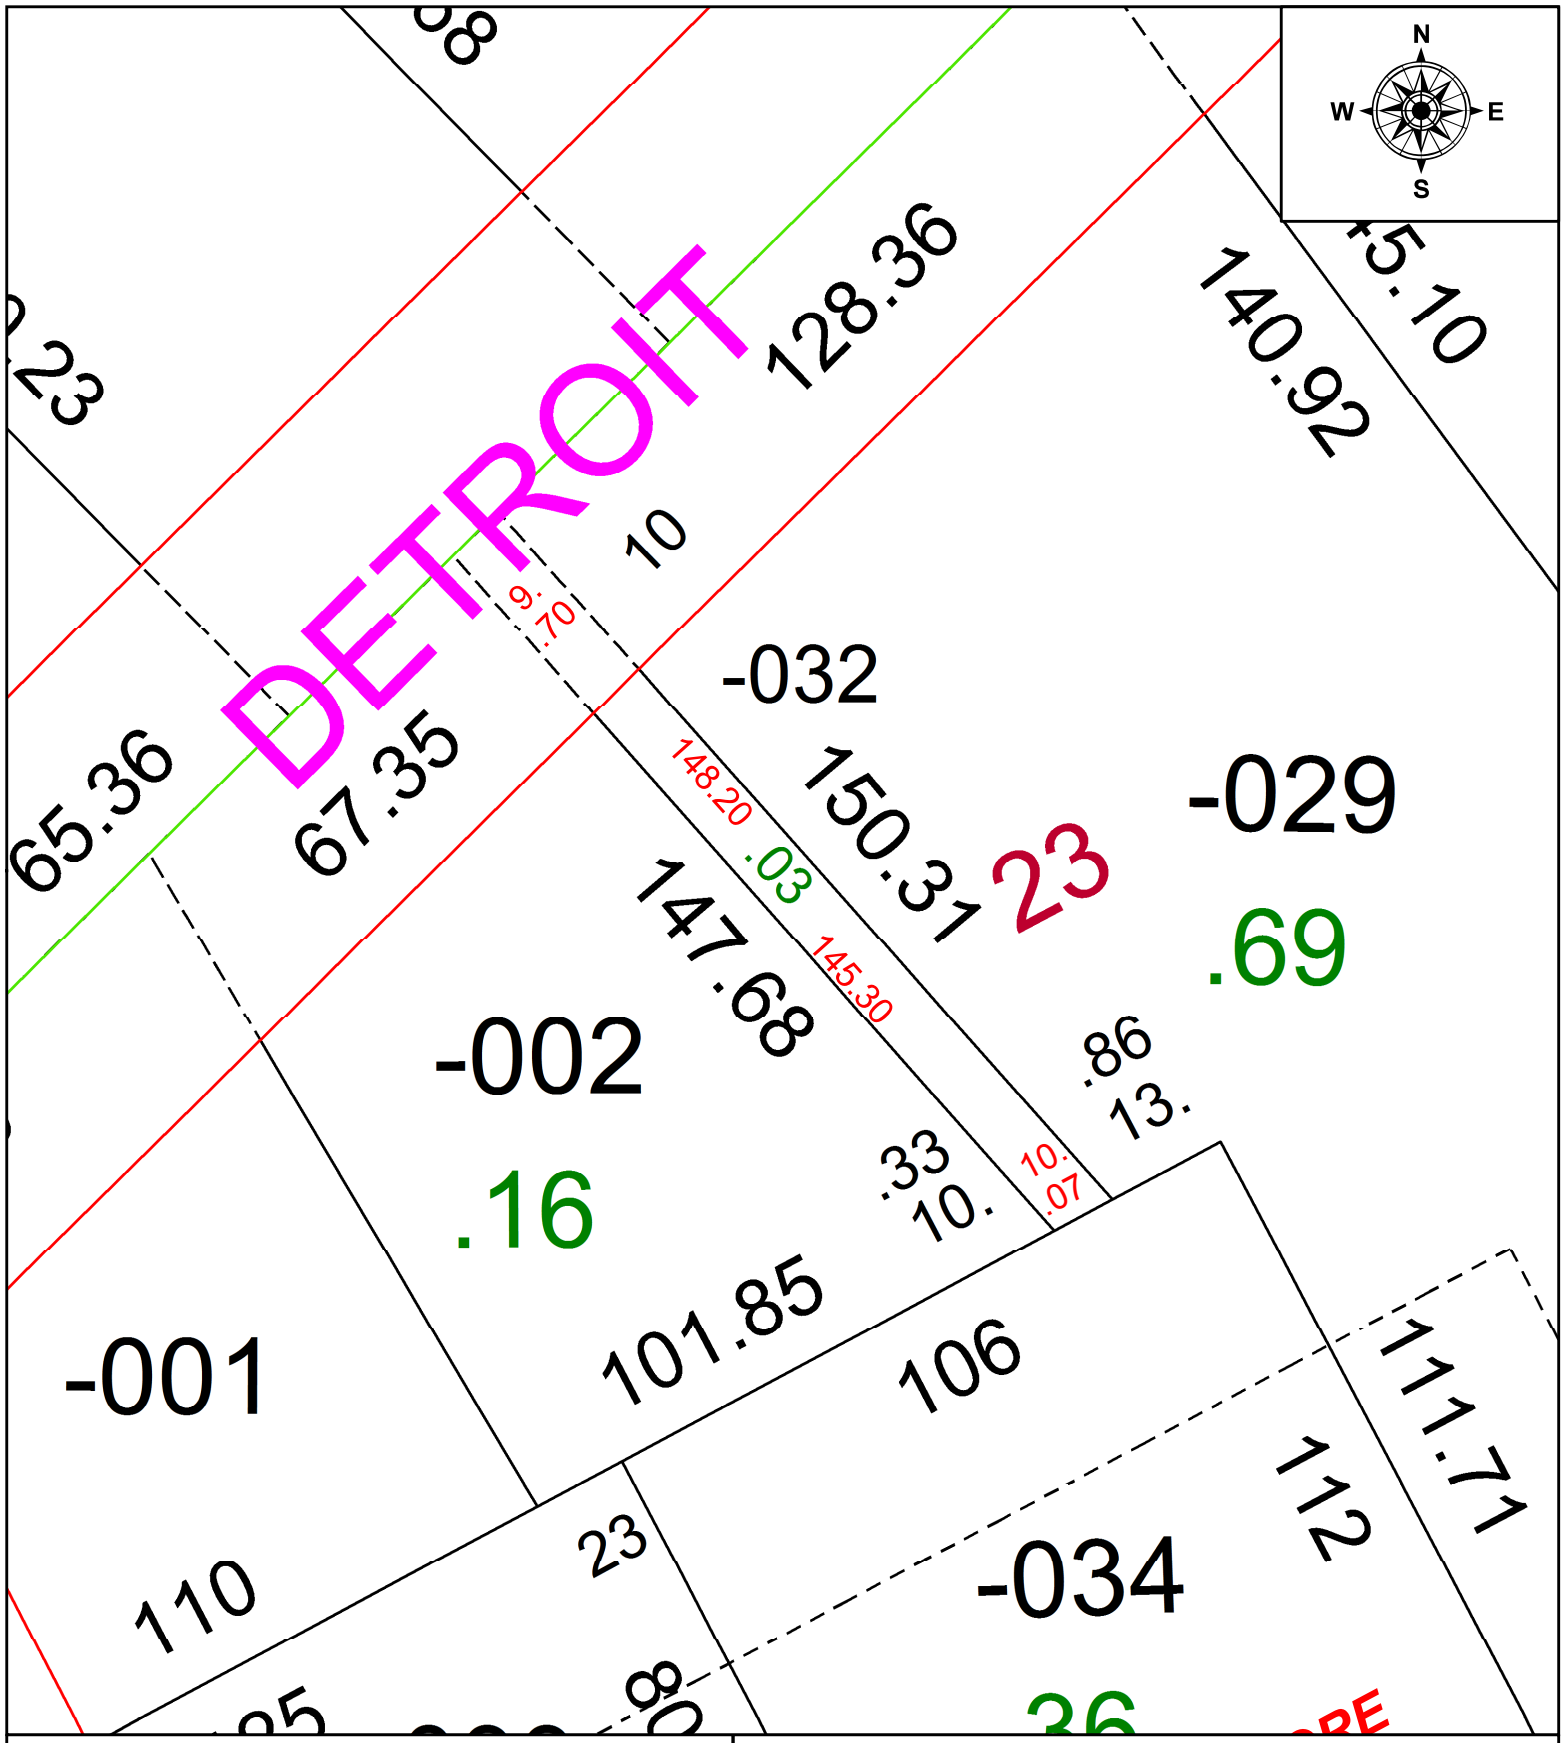

SPLITS/DEEDS PROCESSED
LORAIN COUNTY TAX MAP DEPARTMENT
226 MIDDLE AVE. ELYRIA, OH

SURVEYED BY: THOMAS A. SIMON
CLOSURE: 1: 36259
MAP PAGE(S): 04-00-010-A
APPOVED BY: AC **DATE:** 9/21/2021
SCALE: 1" = 30 **PRIOR INSTRUMENT:** 2021- 0826111