PARENT PARCEL: 01-00-003-105-007 THRU -009
CHILD PARCEL: 01-00-003-105-068
STARTING POINT: N/A

23-04667

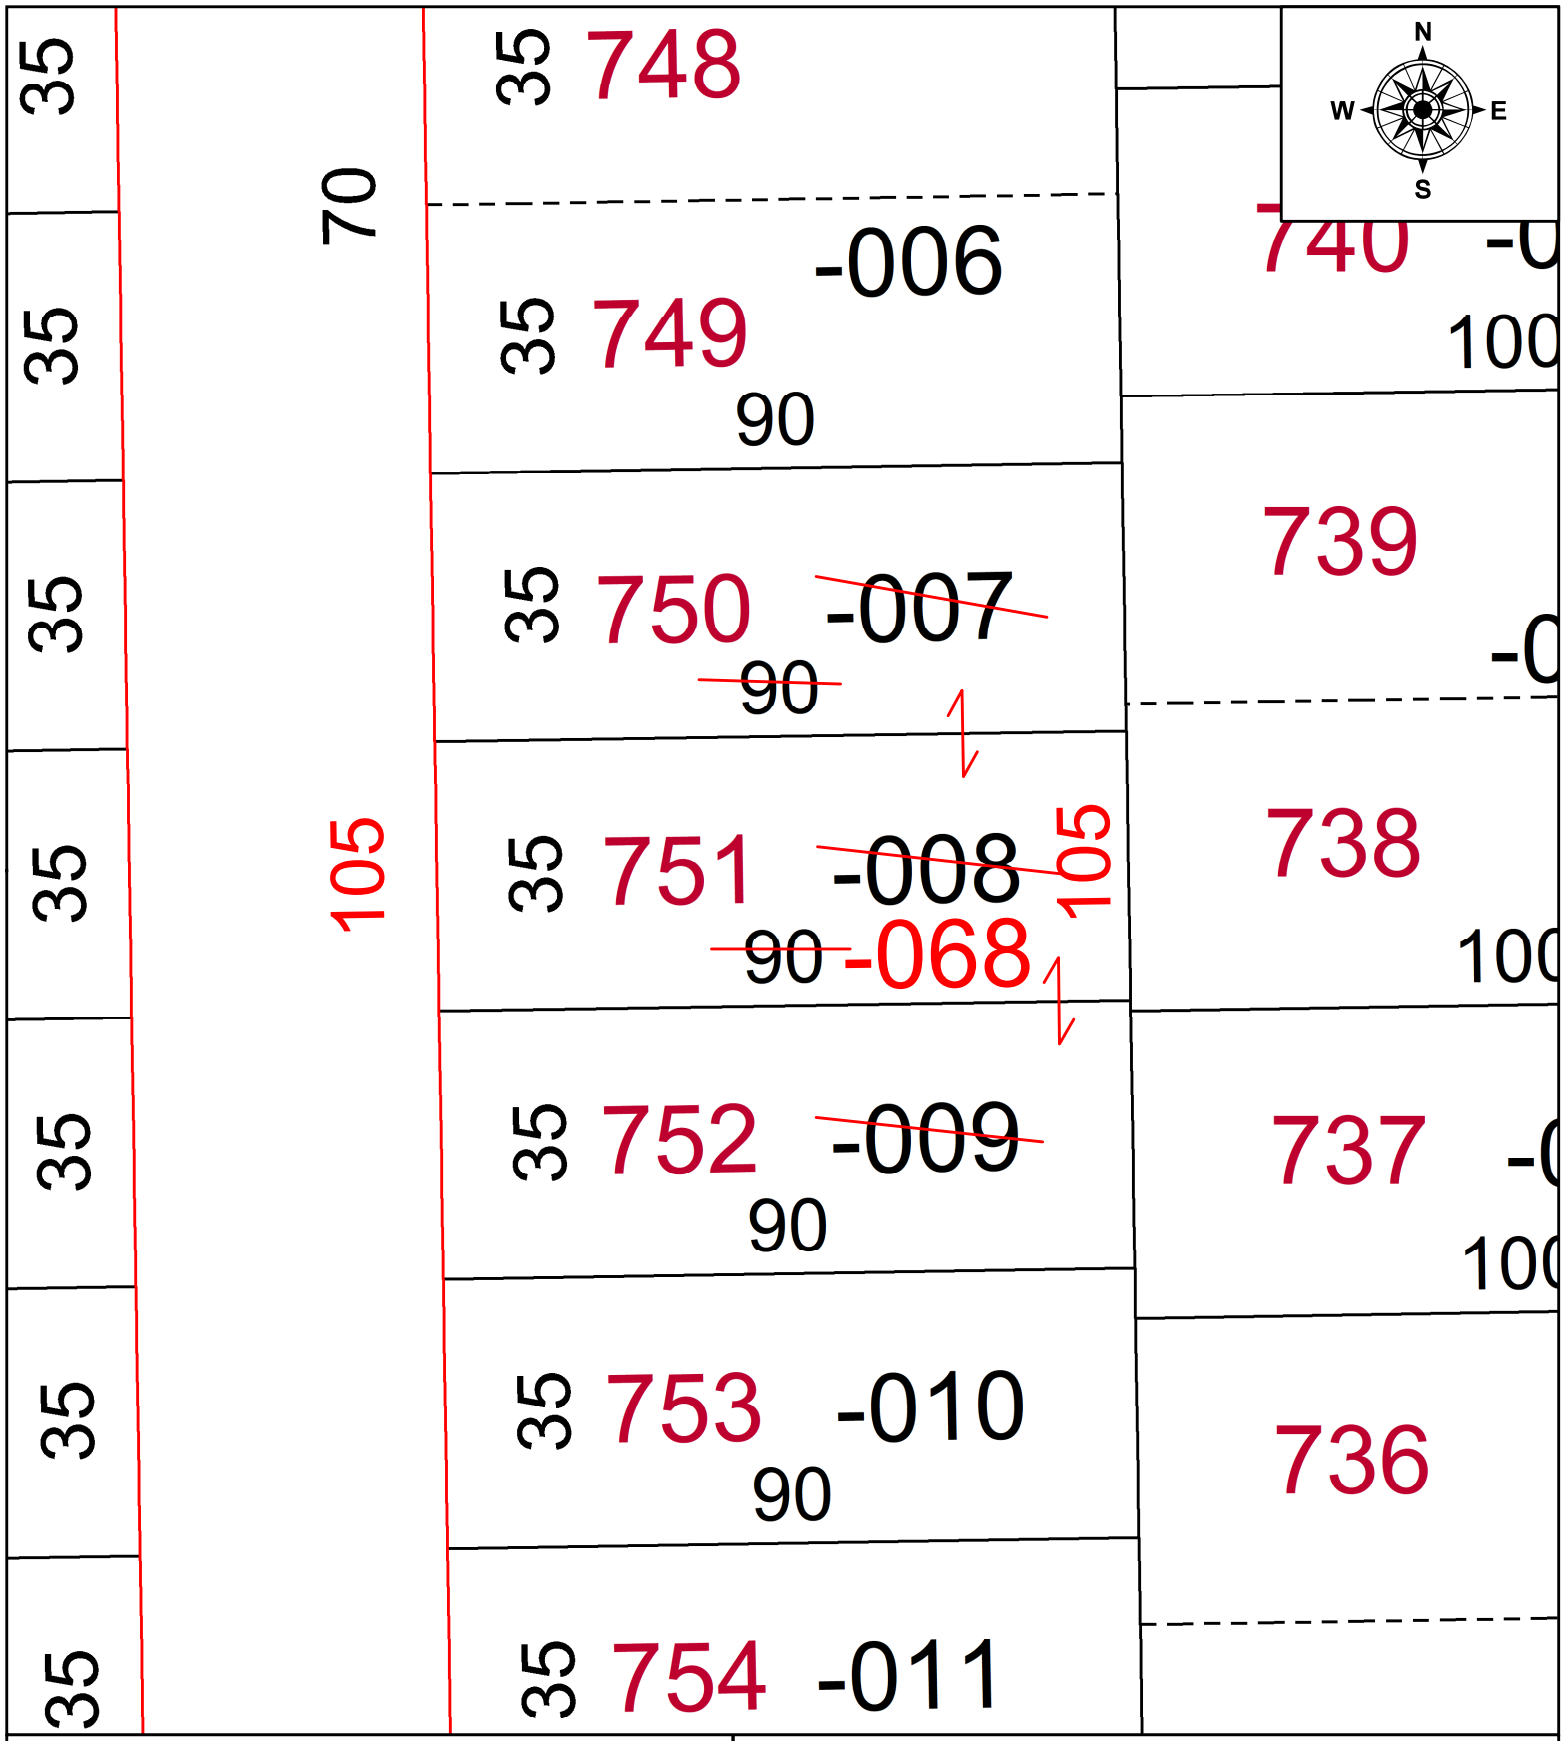

SPLITS/DEEDS PROCESSED
LORAIN COUNTY TAX MAP DEPARTMENT
226 MIDDLE AVE. ELYRIA, OH

SURVEYED BY: N/A **SURVEY #:** N/A
CLOSURE: N/A
MAP PAGE(S): 01-00-003
APPOVED BY: DMA **DATE:** 3/30/2023
SCALE: 1" = 25' **PRIOR INSTRUMENT:** 2005-0065289