PARENT PARCEL: 05-00-017-000-063 & -120

CHILD PARCEL: 05-00-017-000-268

STARTING POINT: E LINE OF CROCKER ST AND SW CORNER OF S/L 383

23-04672

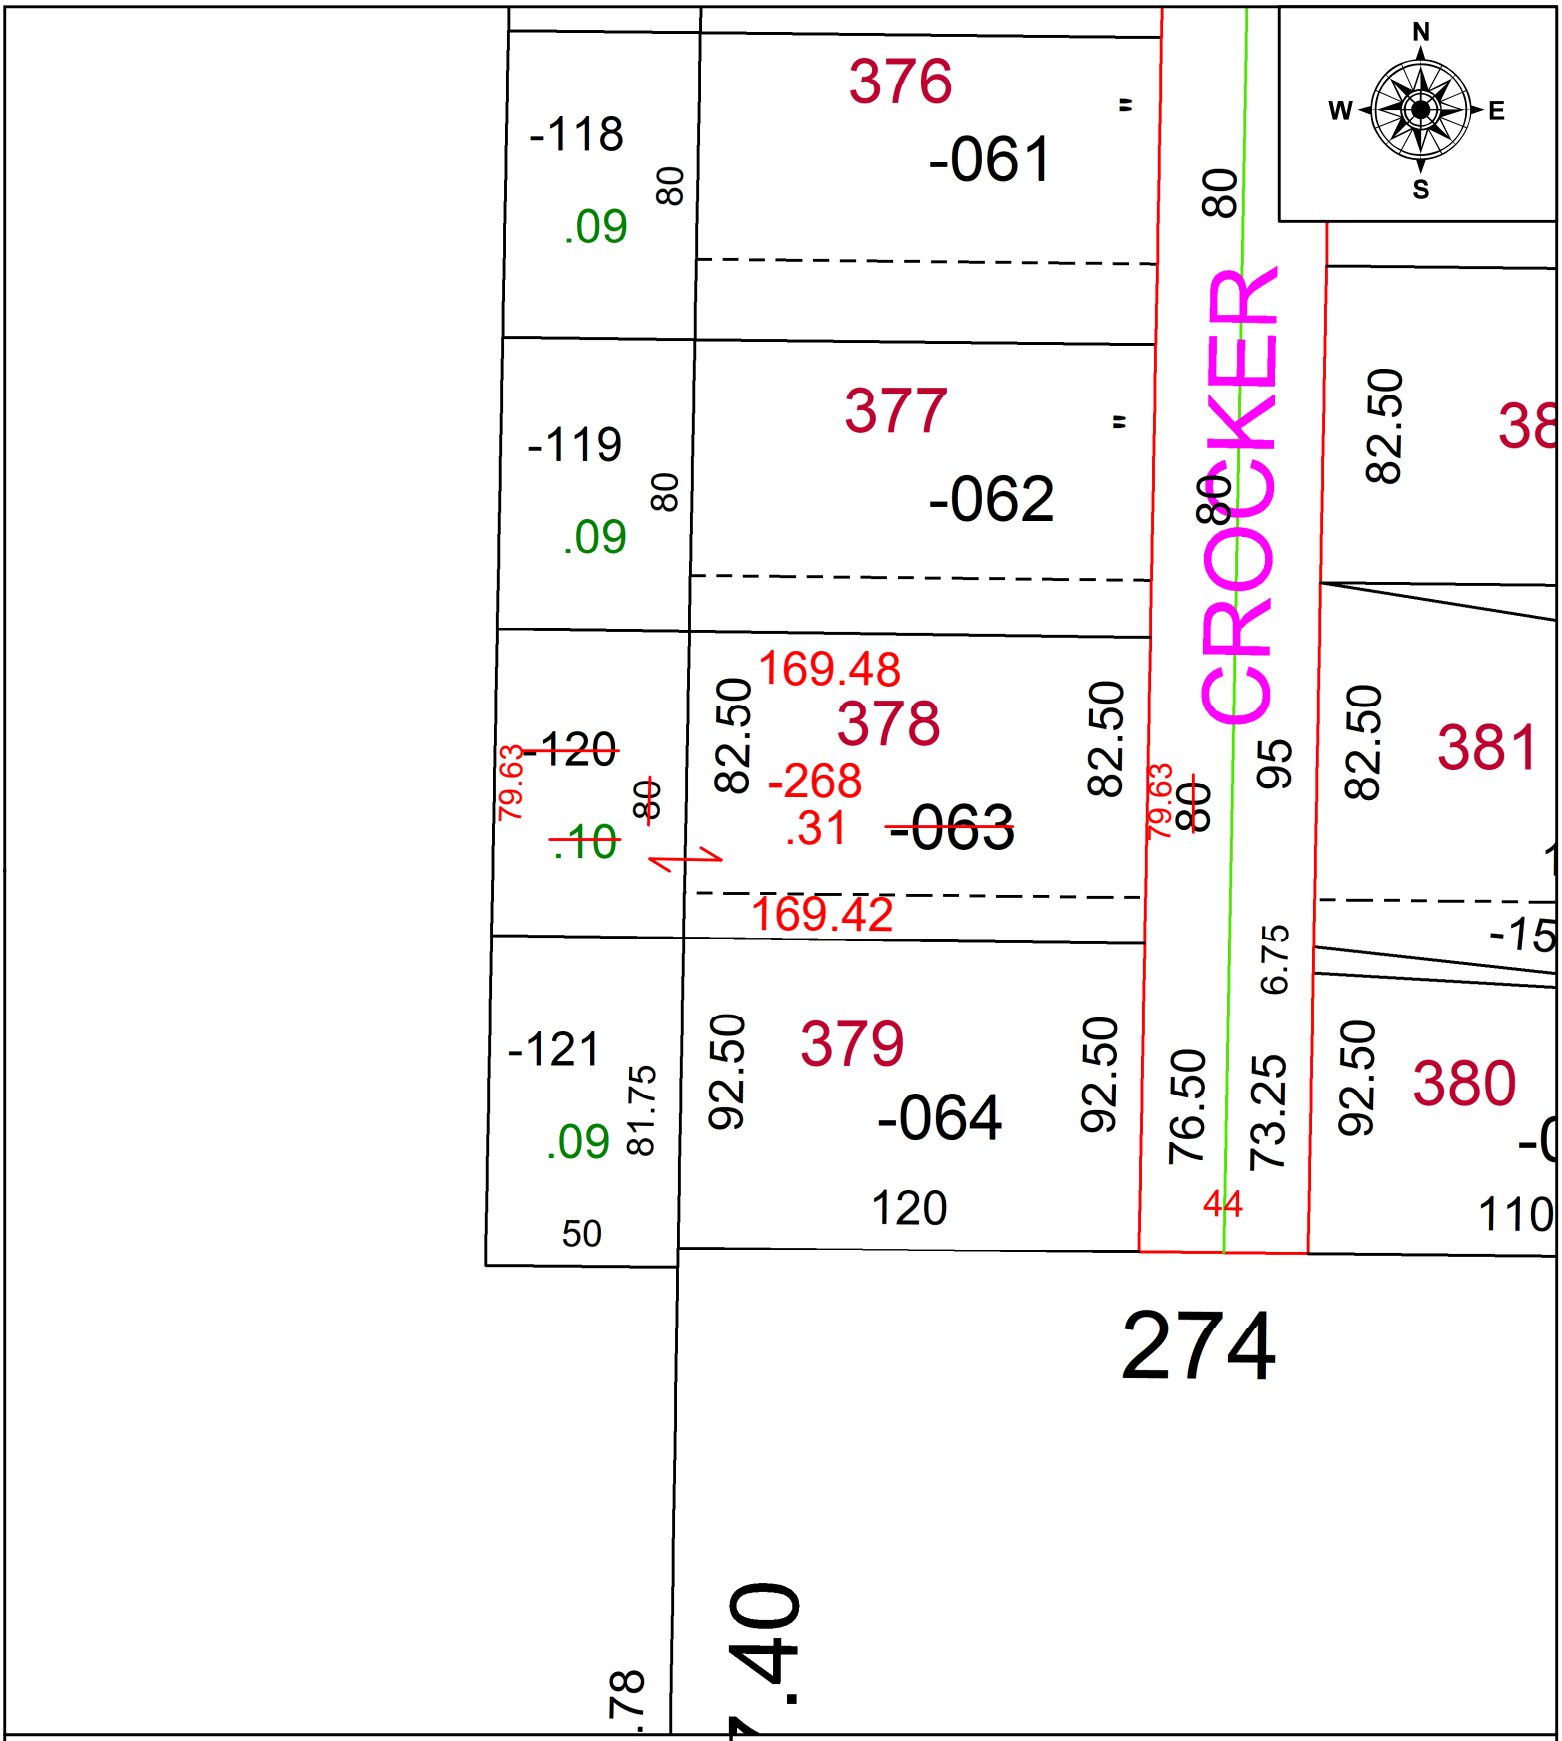

SPLITS/DEEDS PROCESSED

LORAIN COUNTY TAX MAP DEPARTMENT
226 MIDDLE AVE. ELYRIA, OH

SURVEYED BY: TIMOTHY D. HOZALSKI **SURV # 50865**

CLOSURE: 1: 89406

MAP PAGE(S): 05-00-017

APPOVED BY: AC **DATE:** April 17, 2023

SCALE: 1 in = 50 ft **PRIOR INSTRUMENT:** 2021- 0850868