PARENT PARCEL: 06-25-176-105-001

CHILD PARCEL: FRONTAGE & DEPTH TO AC CORR PER SURV BY THOMAS SIMON

STARTING POINT: NW CORNER OF SL 358 OF SPRING VALLEY SUB 4

21-04674-C

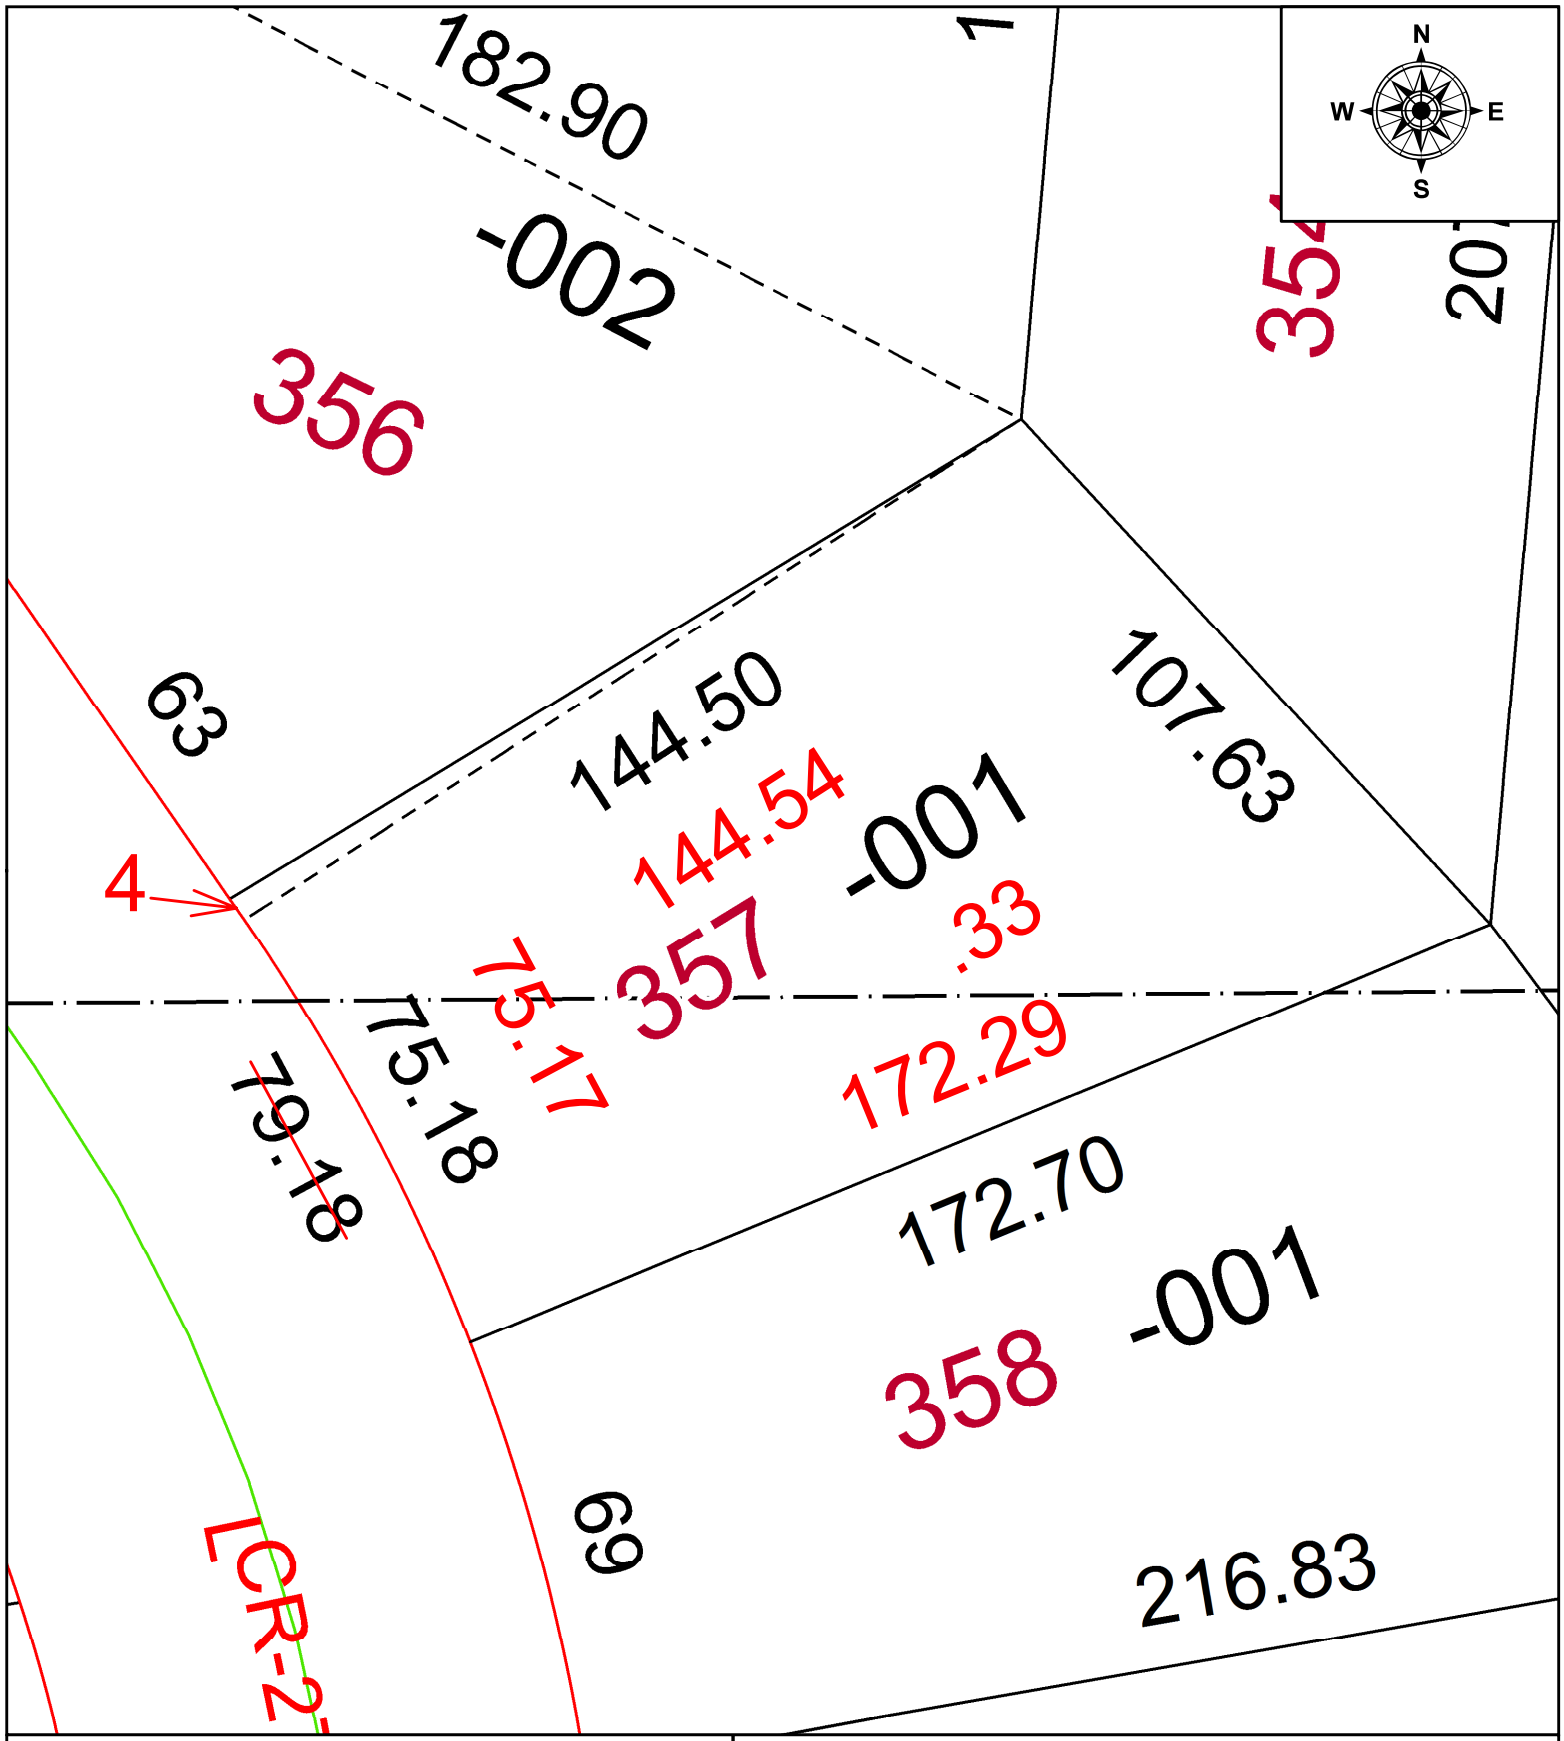

SPLITS/DEEDS PROCESSED

LORAIN COUNTY TAX MAP DEPARTMENT
226 MIDDLE AVE. ELYRIA, OH

SURVEYED BY: THOMAS A. SIMON
CLOSURE: 1: 85116
MAP PAGE(S): 06-25-176
APPOVED BY: AC **DATE:** 9/28/2021
SCALE: 1" = 30 **PRIOR INSTRUMENT:** 2021- 0808908