PARENT PARCEL: 10-00-007-109-012 & -013

CHILD PARCEL: 10-00-007-109-036 N/A

STARTING POINT: SOUTH LINE OF SECTION 7 & SOUTHWEST CORNER OF S/L 3 IN LEROY FORTHOFER SUBDIVISION NO. 1

23-04674

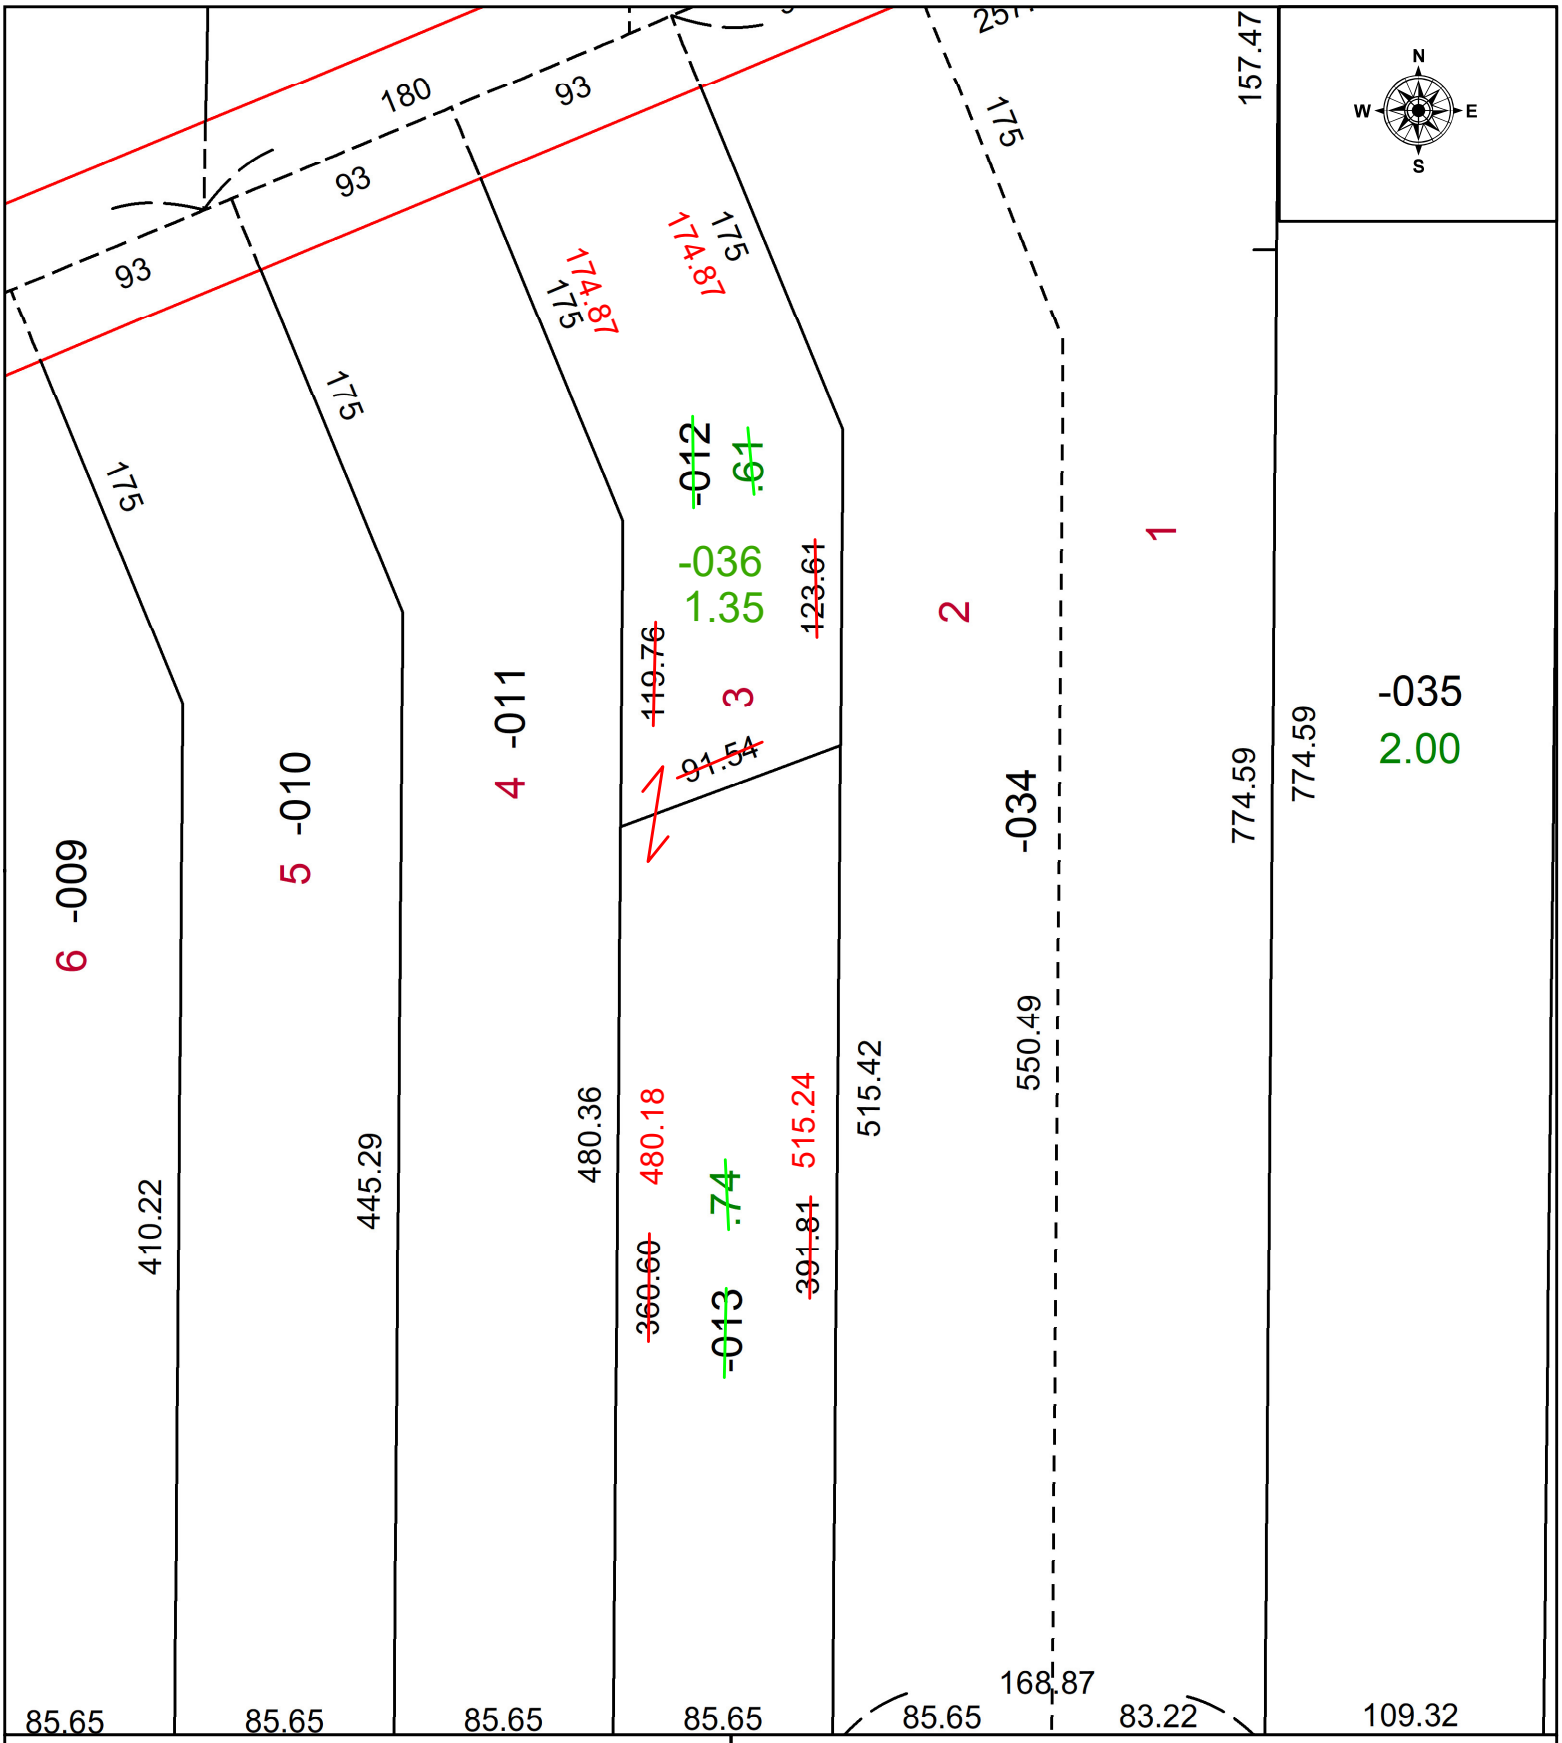

SPLITS/DEEDS PROCESSED

LORAIN COUNTY TAX MAP DEPARTMENT
226 MIDDLE AVE. ELYRIA, OH

SURVEYED BY: TIMOTHY HOZALSKI SURVEY # 50867
CLOSURE: 1: 365462
MAP PAGE(S): 10-00-007
APPOVED BY: WRZ **DATE:** 4/18/2023
SCALE: 1" = 75 **PRIOR INSTRUMENT:** #2021-0800008