PARENT PARCEL: 07-00-047-000-105

CHILD PARCEL: AC CORR PER SURV BY N.R. HURA

STARTING POINT: NE CORNER OF SL 8 RECORDED IN VOL 47 PG 40

21-04675-A

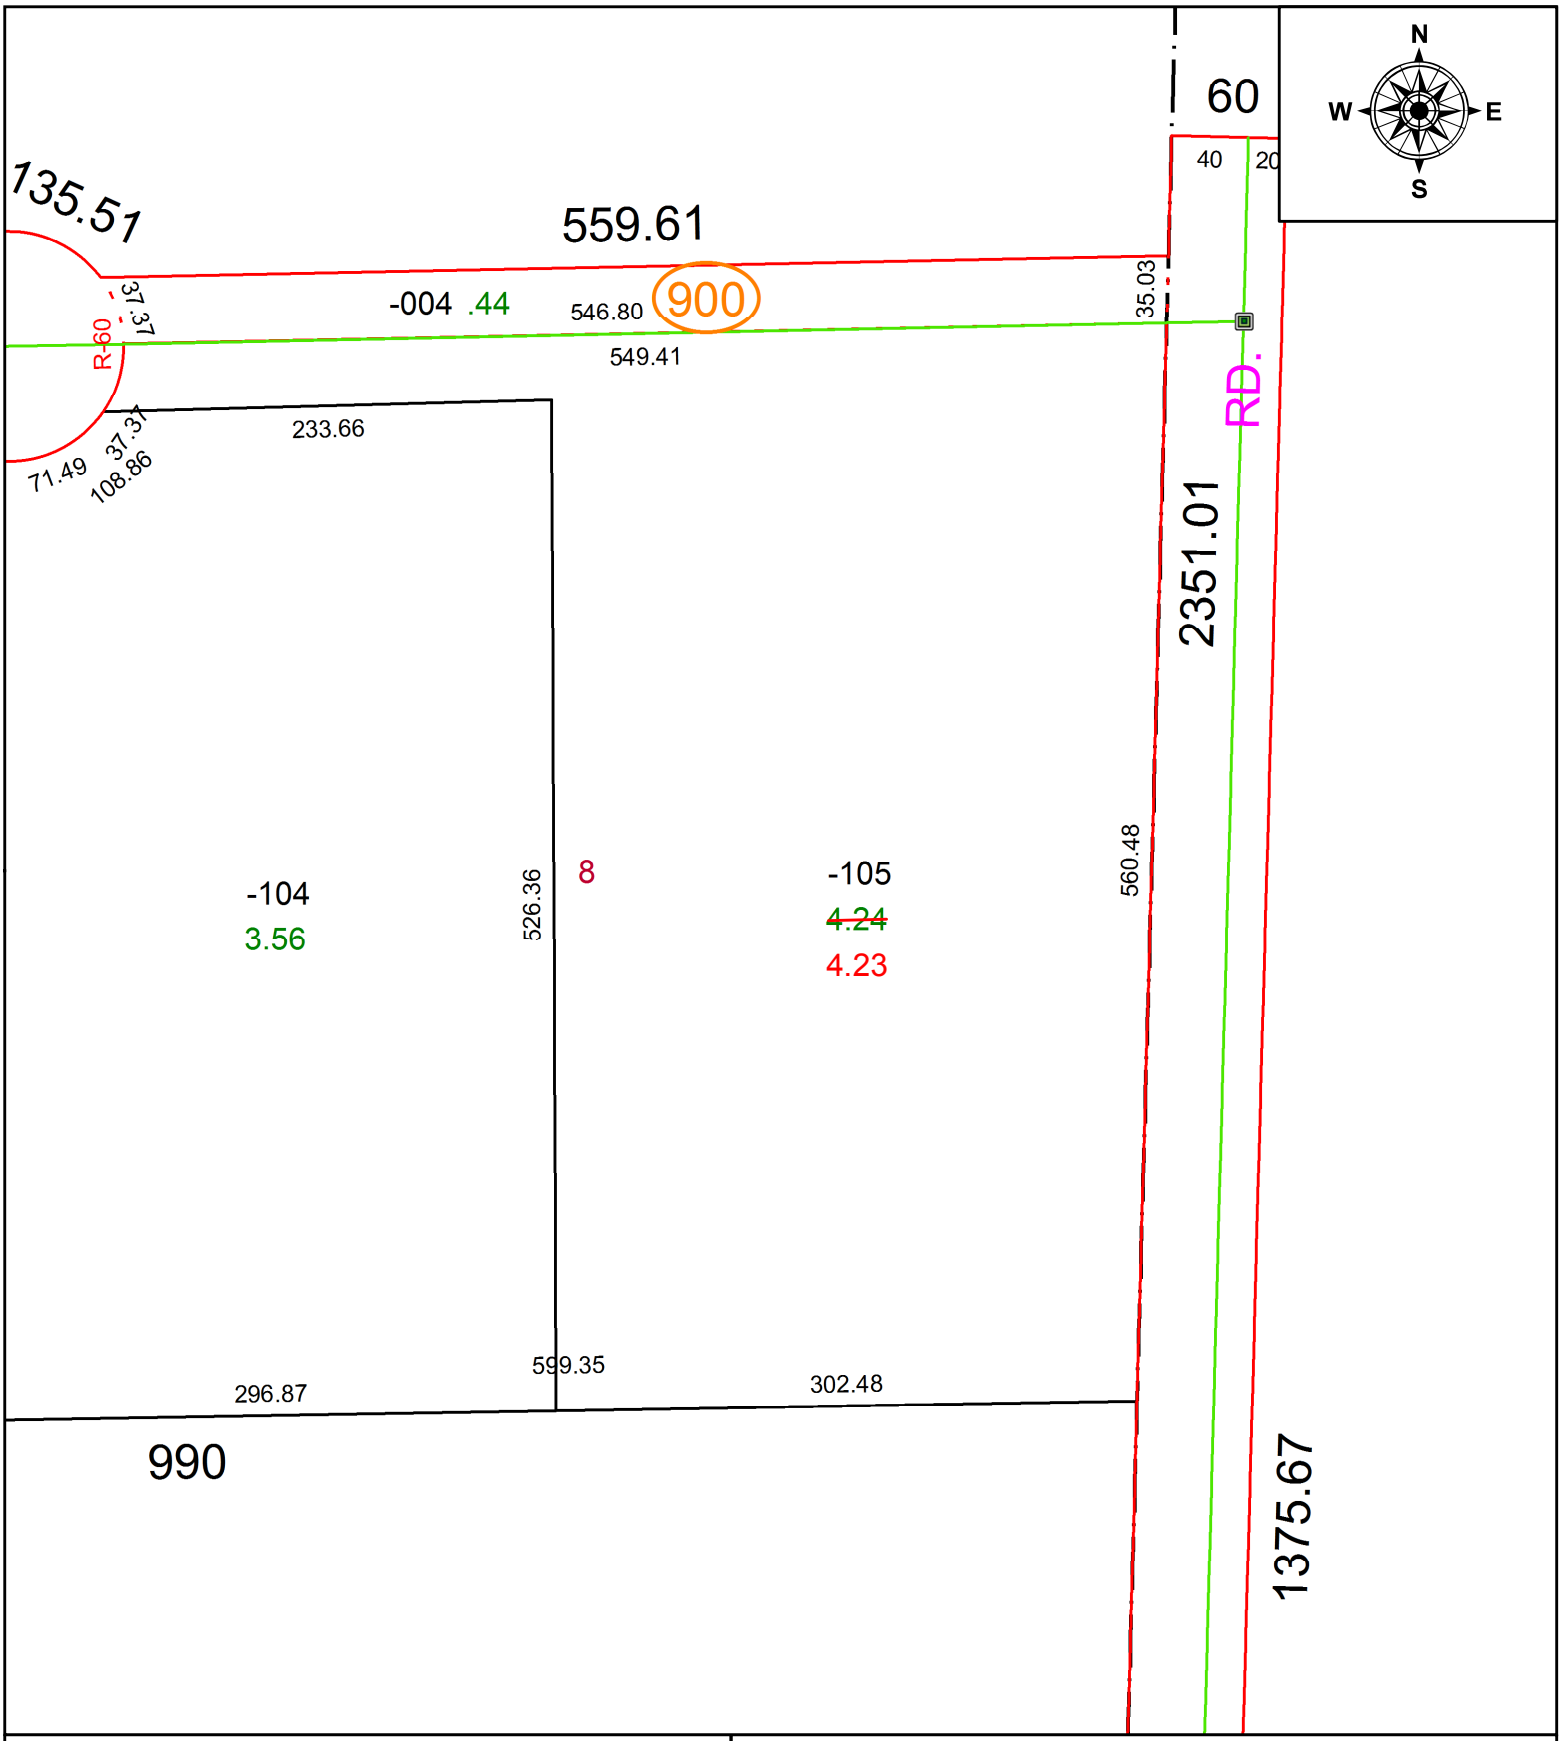

SPLITS/DEEDS PROCESSED

LORAIN COUNTY TAX MAP DEPARTMENT
226 MIDDLE AVE. ELYRIA, OH

SURVEYED BY: N.R. HURA
CLOSURE: N/A
MAP PAGE(S): 07-00-047-B
APPOVED BY: AC **DATE:** 9/30/2021
SCALE: 1" = 100 **PRIOR INSTRUMENT:** 1999- 0658945