PARENT PARCEL: 10-00-013-000-259 & -260

CHILD PARCEL: 10-00-013-000-261

STARTING POINT: I.P. MON. BOX, CL OF BUTTERNUT RIDGE RD. & CL OF MIDDLE AVE.

23-04676

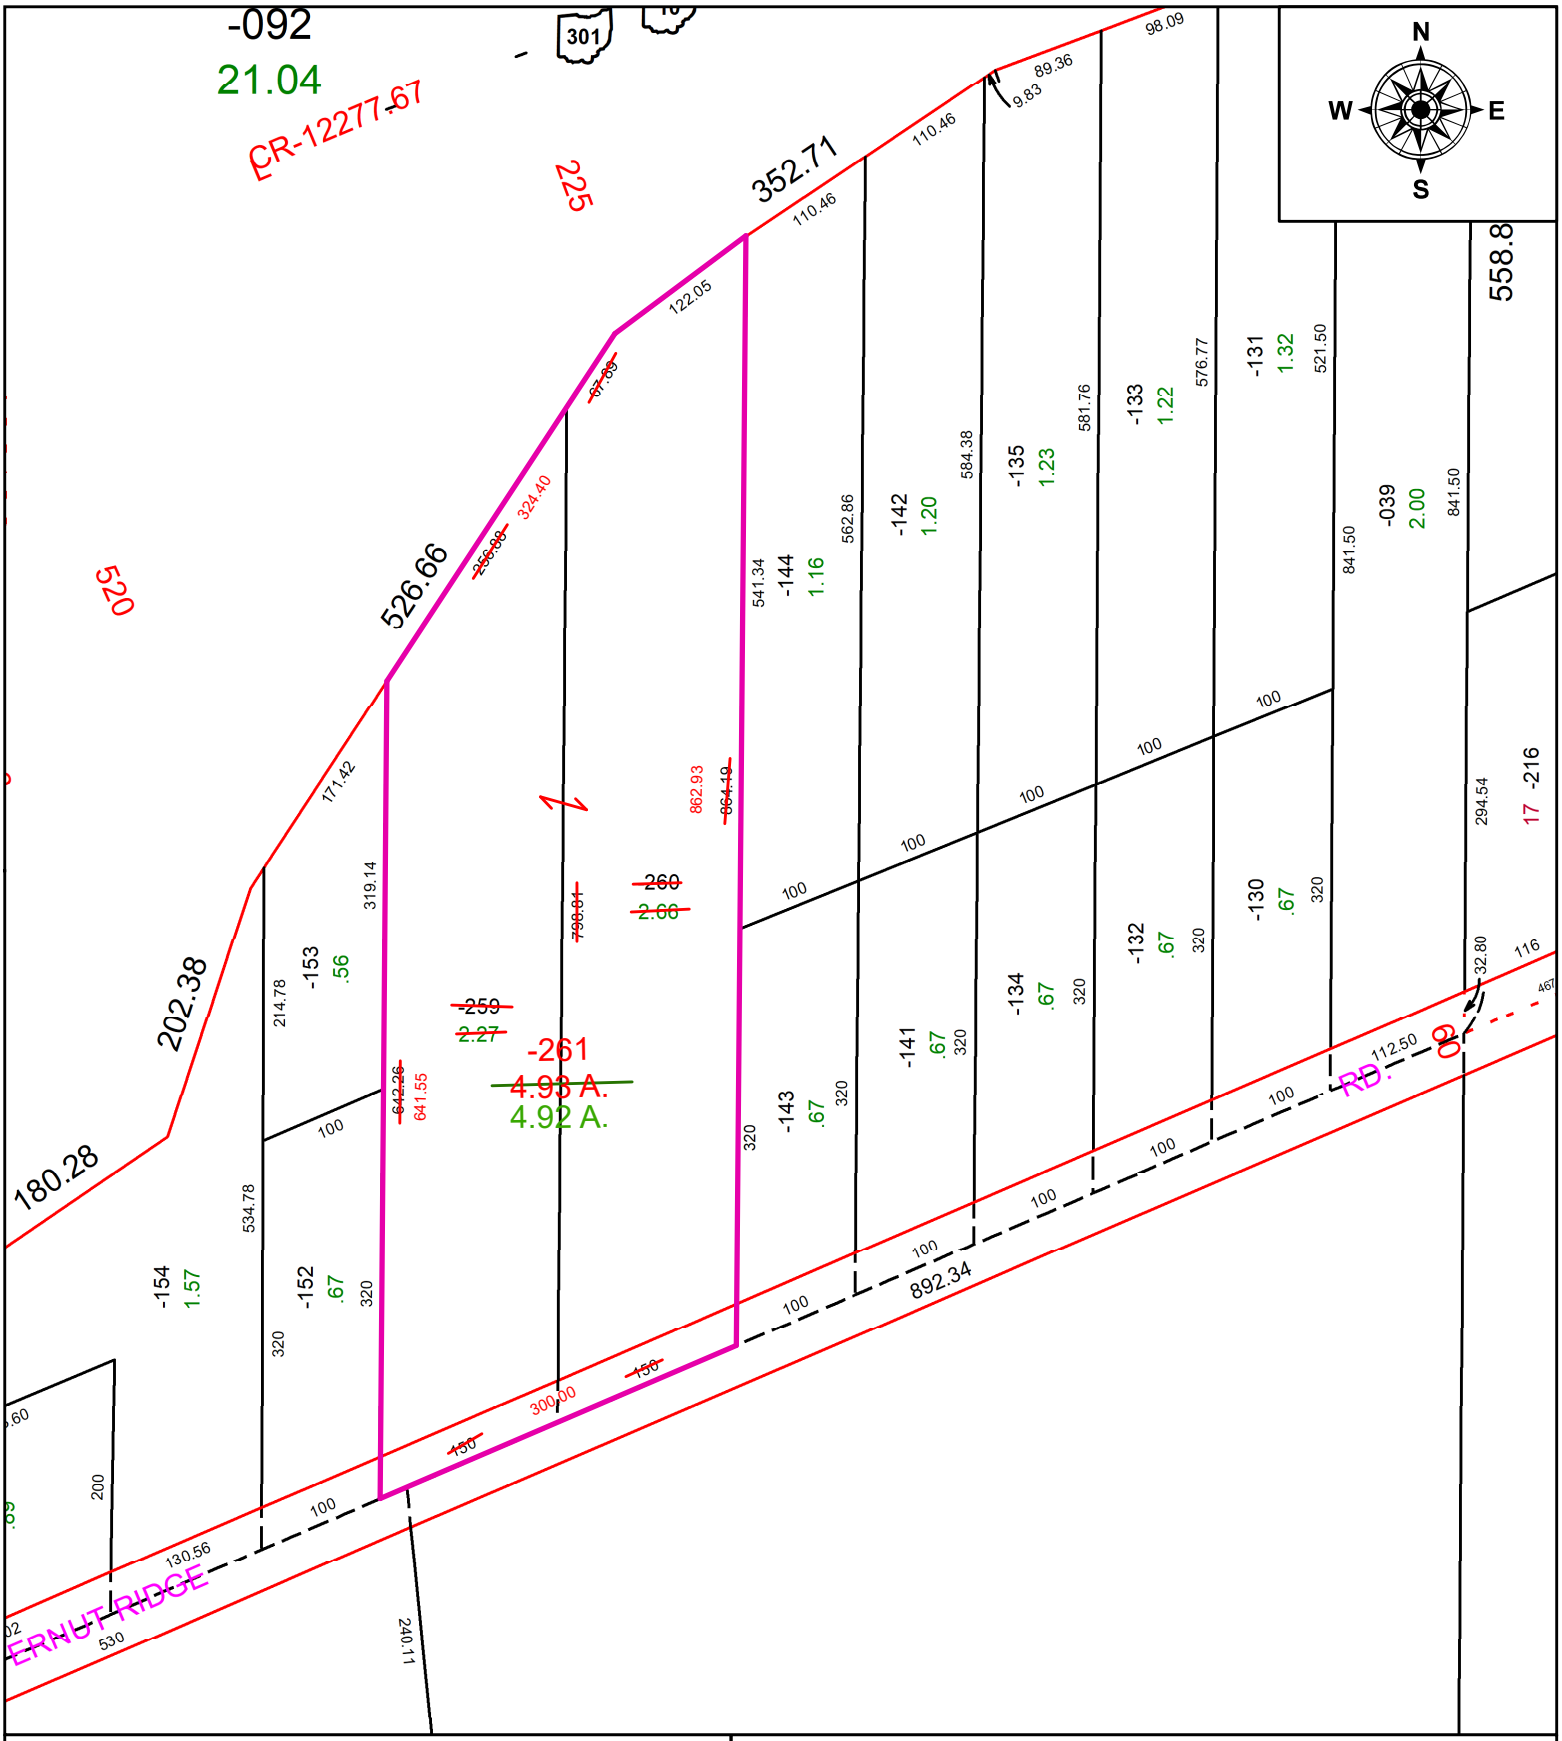

SPLITS/DEEDS PROCESSED

LORAIN COUNTY TAX MAP DEPARTMENT
226 MIDDLE AVE. ELYRIA, OH

SURVEYED BY: BRIAN SIEBENTHAL
CLOSURE: 1:219658
MAP PAGE(S): 10-00-013
APPOVED BY: TJS **DATE:** 4/20/2023
SCALE: 1" = 150' **PRIOR INSTRUMENT:** 2017-0645635