PARENT PARCEL: 07-00-039-000-036, -037, & -054

CHILD PARCEL: 07-00-039-000-094 & -095

STARTING POINT: I.P. FD., CL OF CENTER RIDGE RD. & CL OF RACE RD.

23-04680

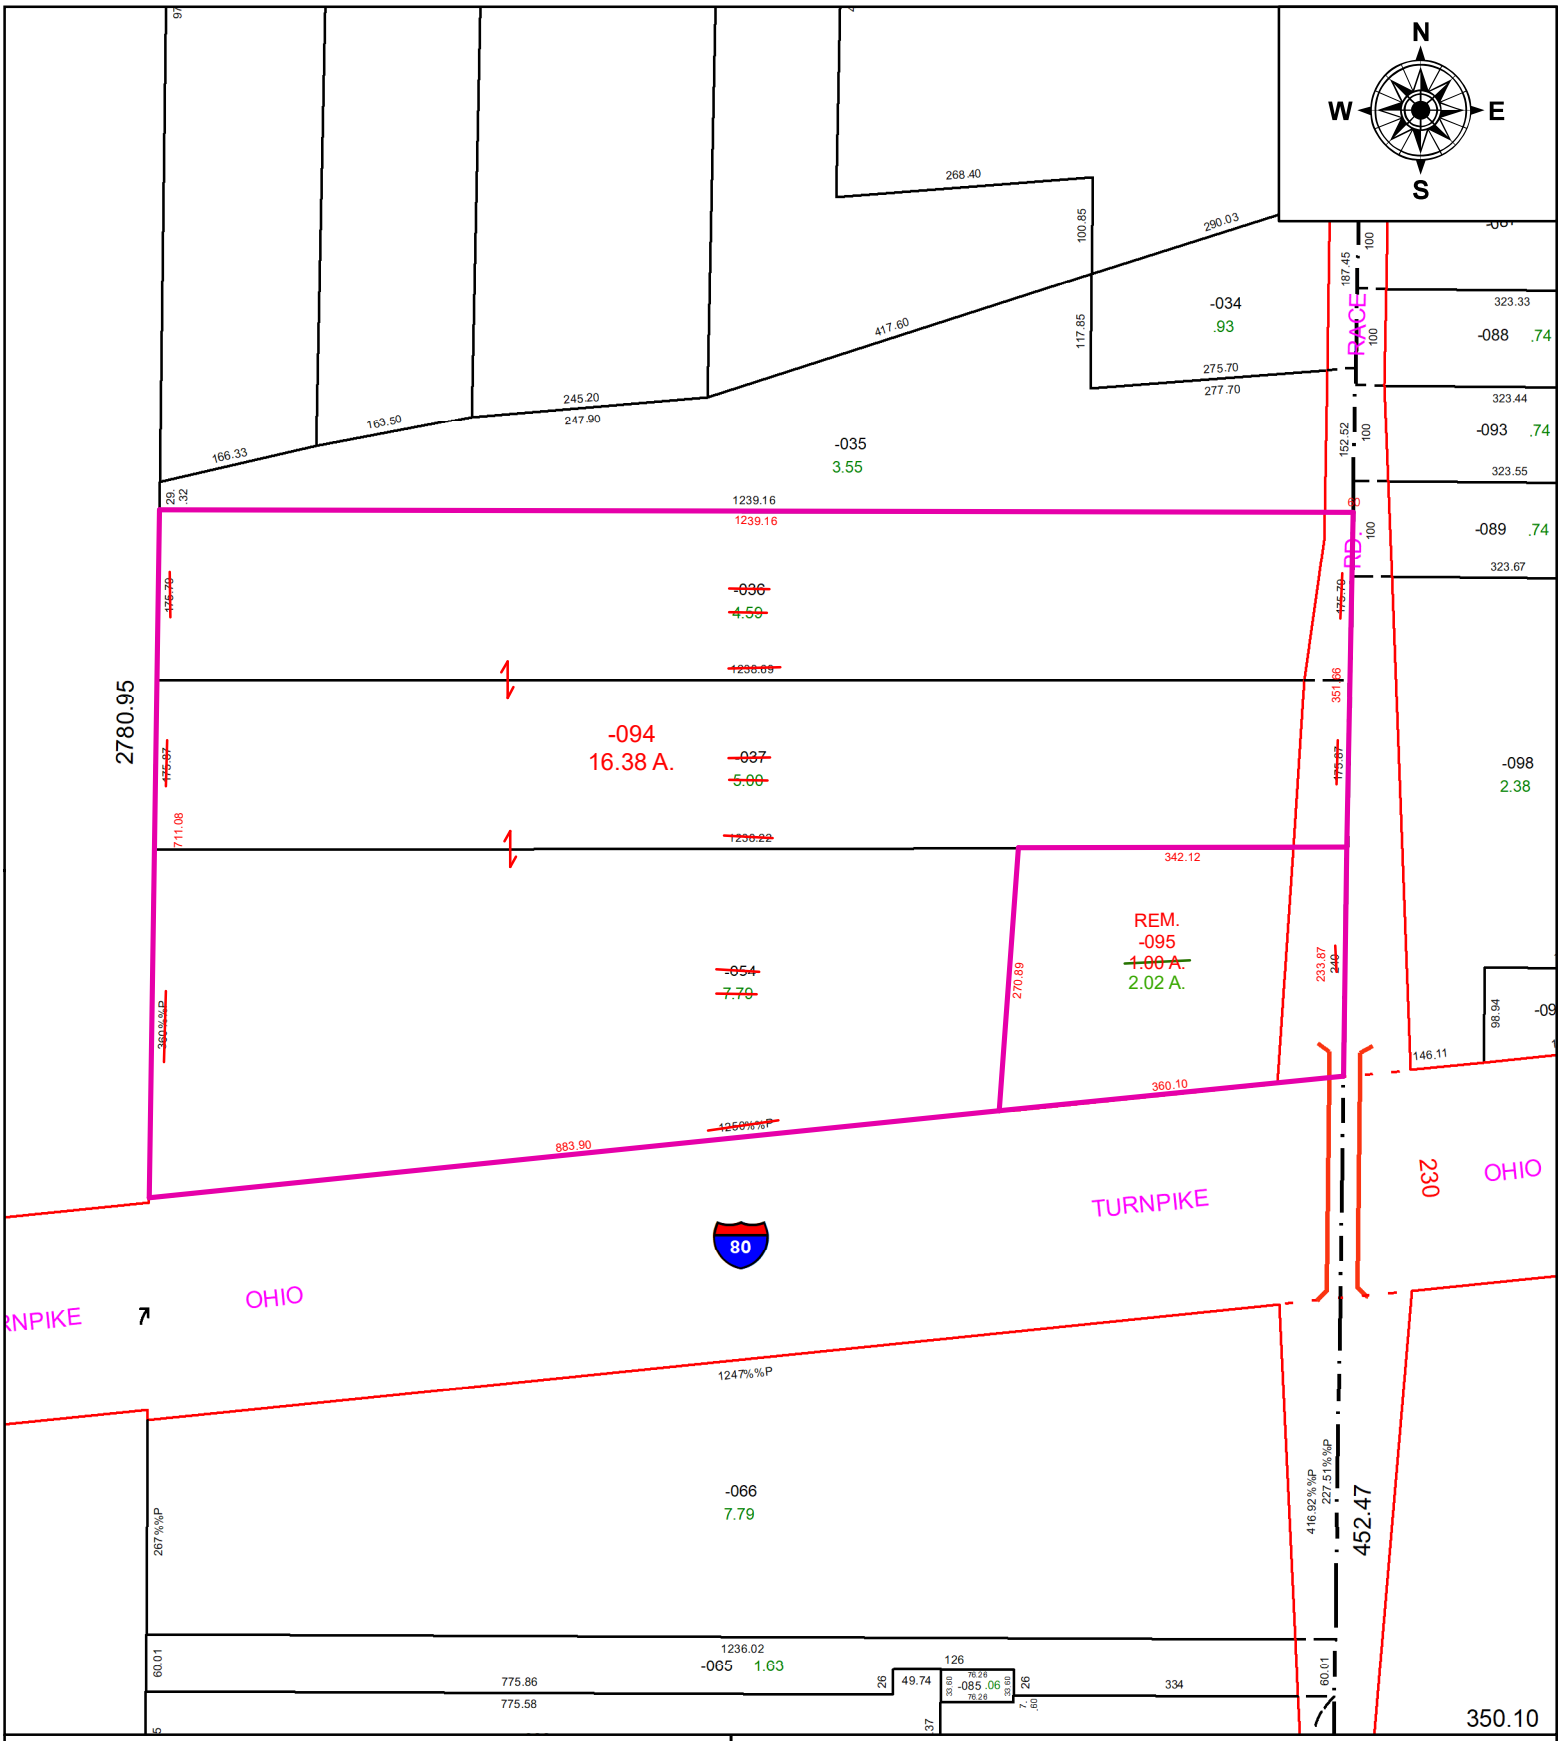

SPLITS/DEEDS PROCESSED

LORAIN COUNTY TAX MAP DEPARTMENT
226 MIDDLE AVE. ELYRIA, OH

SURVEYED BY: WILFREDO BARBOSA
CLOSURE: 1:129349
MAP PAGE(S): 07-00-039
APPOVED BY: TJS **DATE:** 4/25/2023
SCALE: 1" = 200' **PRIOR INSTRUMENT:** DV 1241/242, OR 1149/534