PARENT PARCEL: 15-00-099-101-006, -188, -189, -191

CHILD PARCEL: 15-00-099-101-245

STARTING POINT: INTERSECTION OF C/LS OF DIAGONAL RD & WEBSTER RD

23-04682

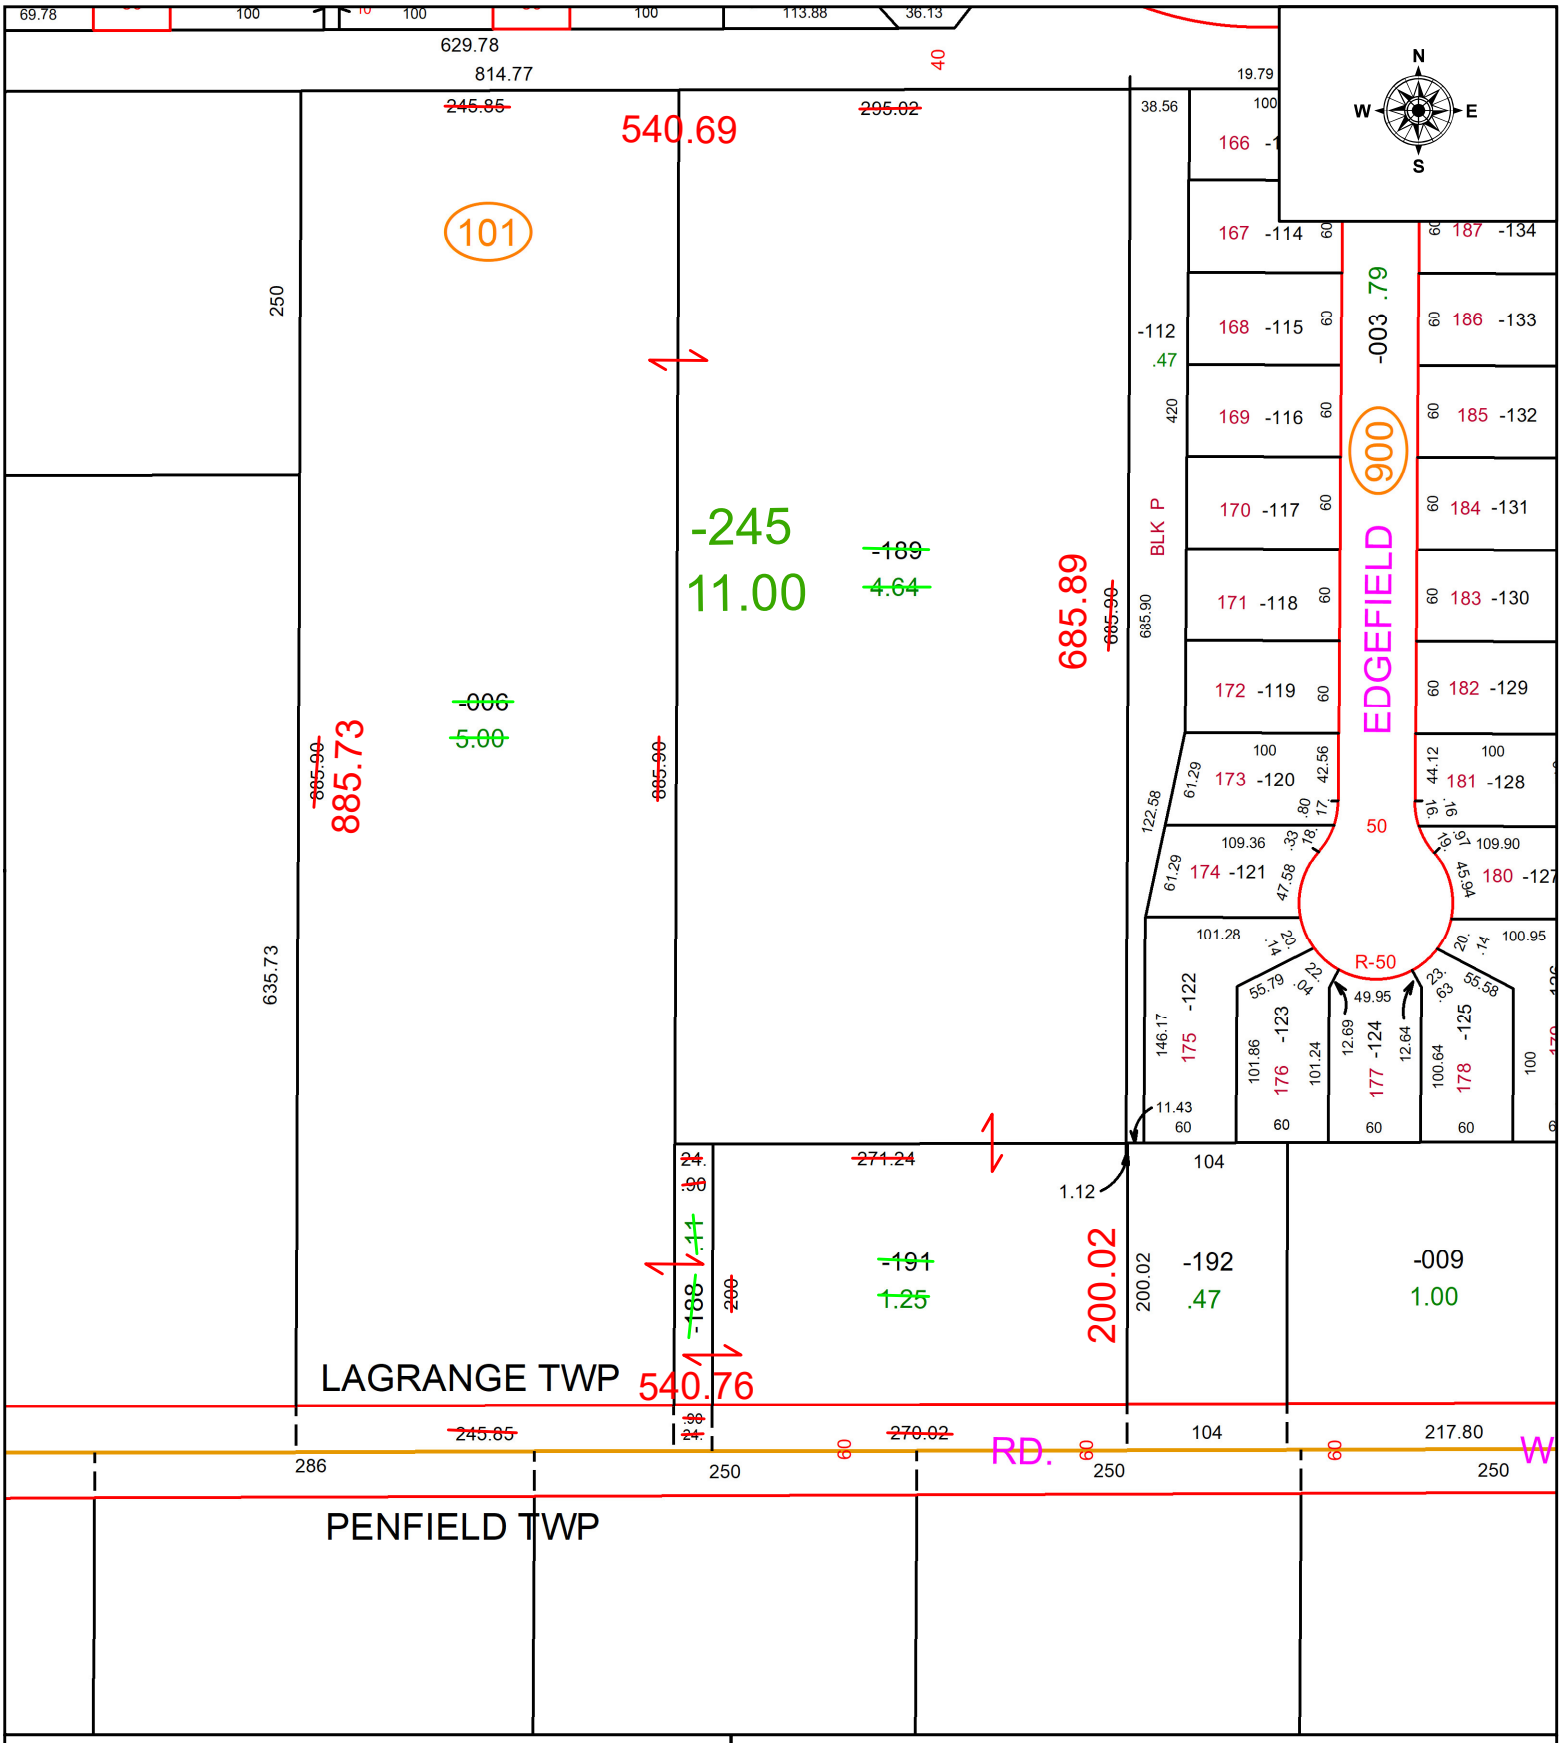

SPLITS/DEEDS PROCESSED

LORAIN COUNTY TAX MAP DEPARTMENT
226 MIDDLE AVE. ELYRIA, OH

SURVEYED BY: RICHARD FREDRICKSON — SURVEY # 50875

CLOSURE: 1: 341743

MAP PAGE(S): 15-00-099

APPOVED BY: WRZ **DATE:** 4/26/2023

SCALE: 1" = 125 **PRIOR INSTRUMENT:** #2020-0784340