PARENT PARCEL: 02-01-003-150-017

CHILD PARCEL: 02-01-003-150-018 & -019

STARTING POINT: SOUTHEASTERLY CORNER OF S/L 8 IN CHAMBERLAIN'S FIRST ADDITION

23-04684

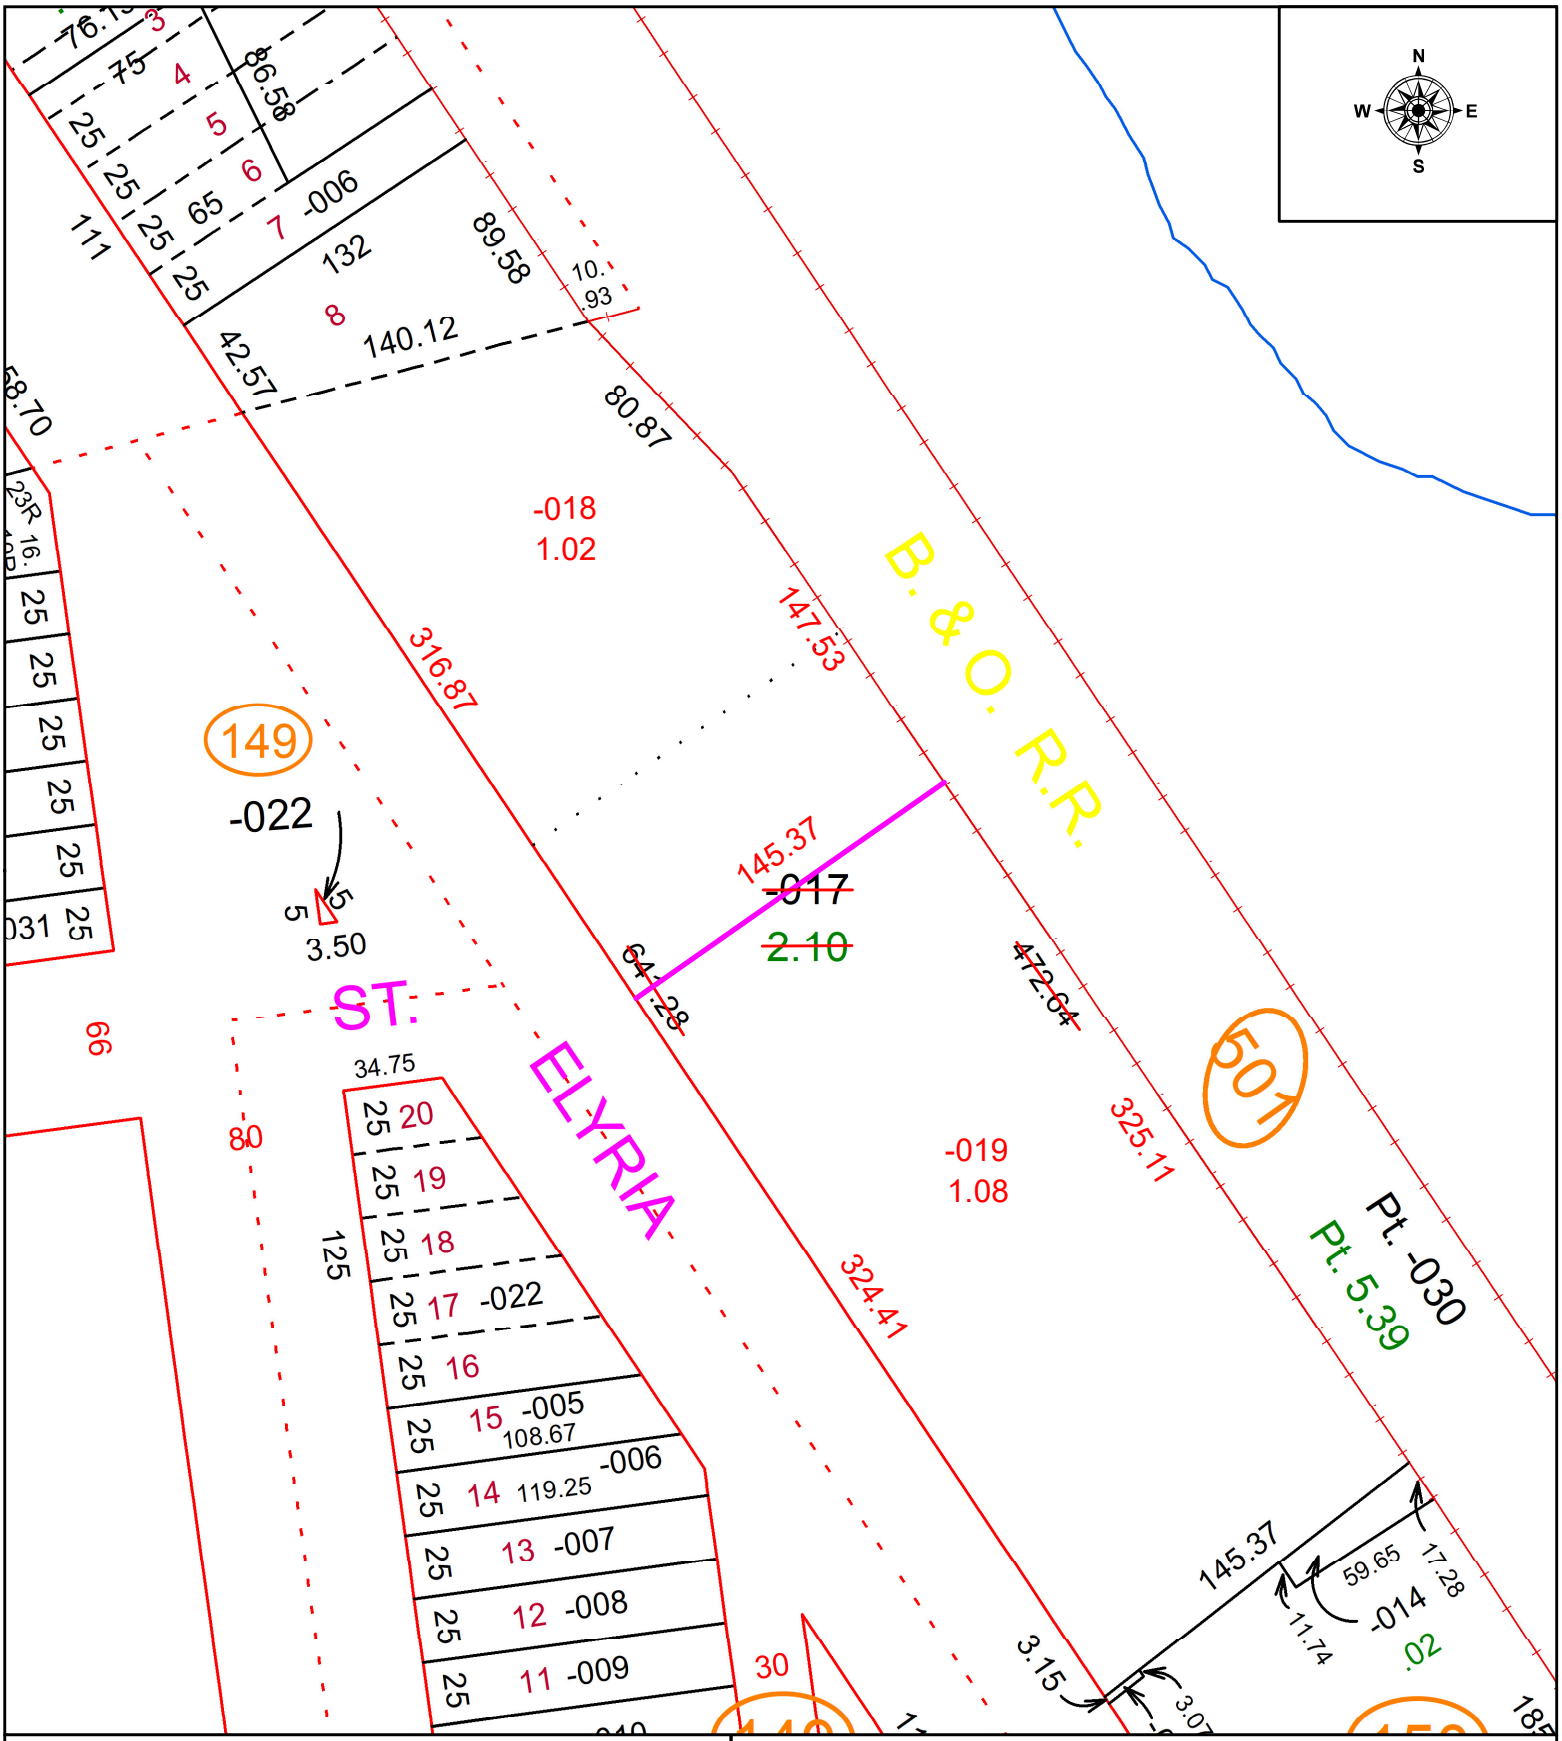

SPLITS/DEEDS PROCESSED

LORAIN COUNTY TAX MAP DEPARTMENT
226 MIDDLE AVE. ELYRIA, OH

SURVEYED BY: TIMOTHY DURR SURVEY # 50880

CLOSURE: 1: 371077

MAP PAGE(S): 02-01-003

APPOVED BY: WRZ **DATE:** 5/3/2023

SCALE: 1" = 75 **PRIOR INSTRUMENT:** #2023-0902872