PARENT PARCEL: 02-01-006-113-029

CHILD PARCEL: NEW SURVEY--PRIOR DIMENSION DISCREPANCY

STARTING POINT: CL OF 7TH ST. & EAST LINE OF SUBLOT 64

21-04686-C

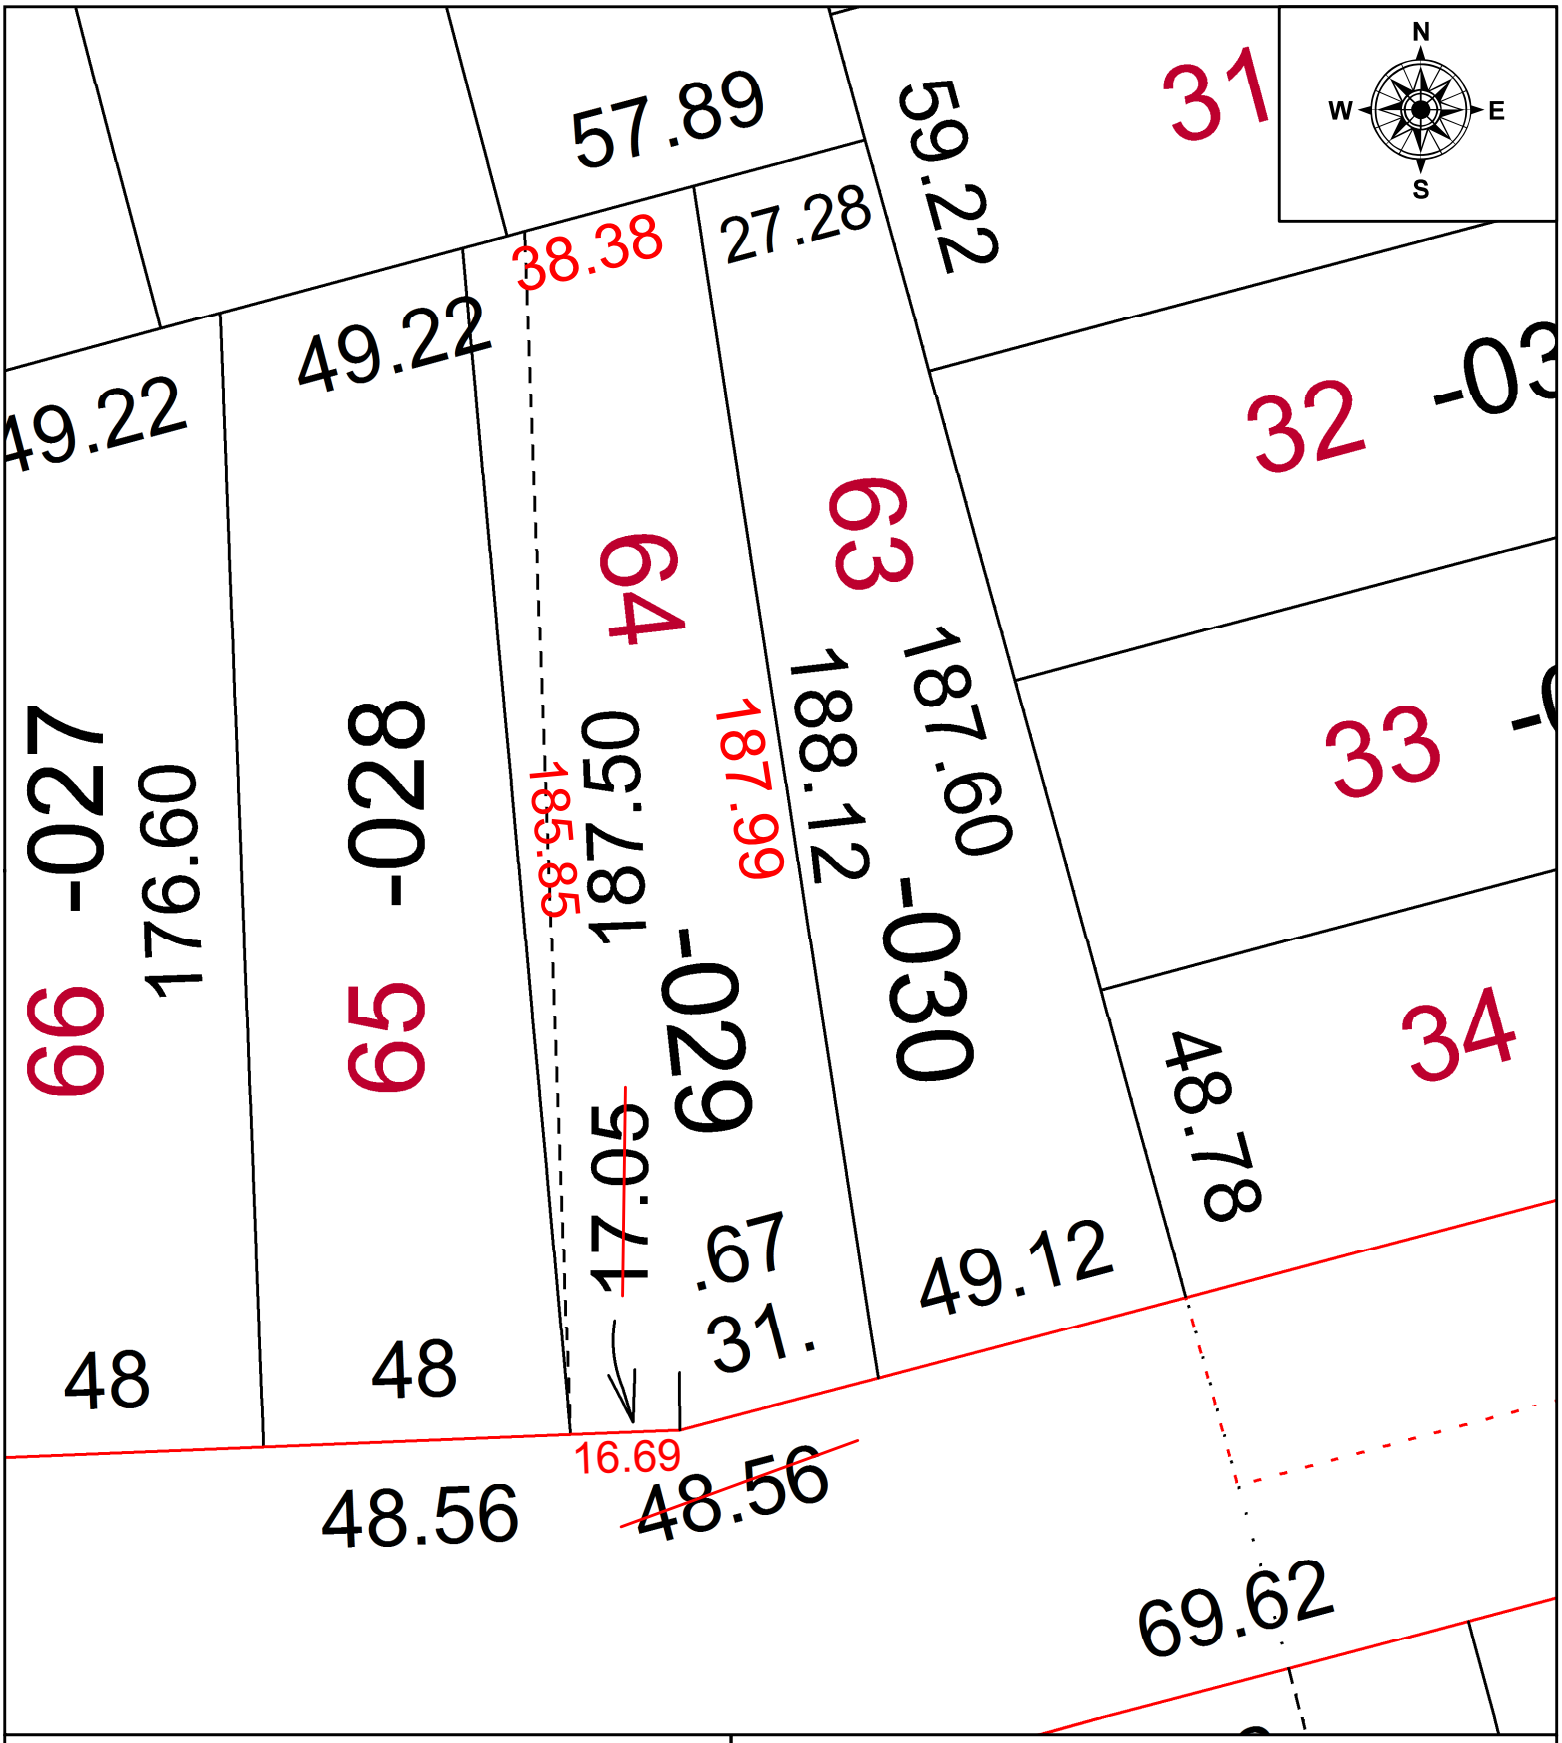

SPLITS/DEEDS PROCESSED

LORAIN COUNTY TAX MAP DEPARTMENT
226 MIDDLE AVE. ELYRIA, OH

SURVEYED BY: PATRICK McGANNON
CLOSURE: 1: 73263
MAP PAGE(S): 02-01-006
APPOVED BY: DMA **DATE:** 10/15/2021
SCALE: 1" = 40' **PRIOR INSTRUMENT:** 20200794200