PARENT PARCEL: 05-00-041-110-060
CHILD PARCEL: 05-00-041-110-065 & -066
STARTING POINT: AC CORR PER SURV BY AMY M. KELLY

23-04686

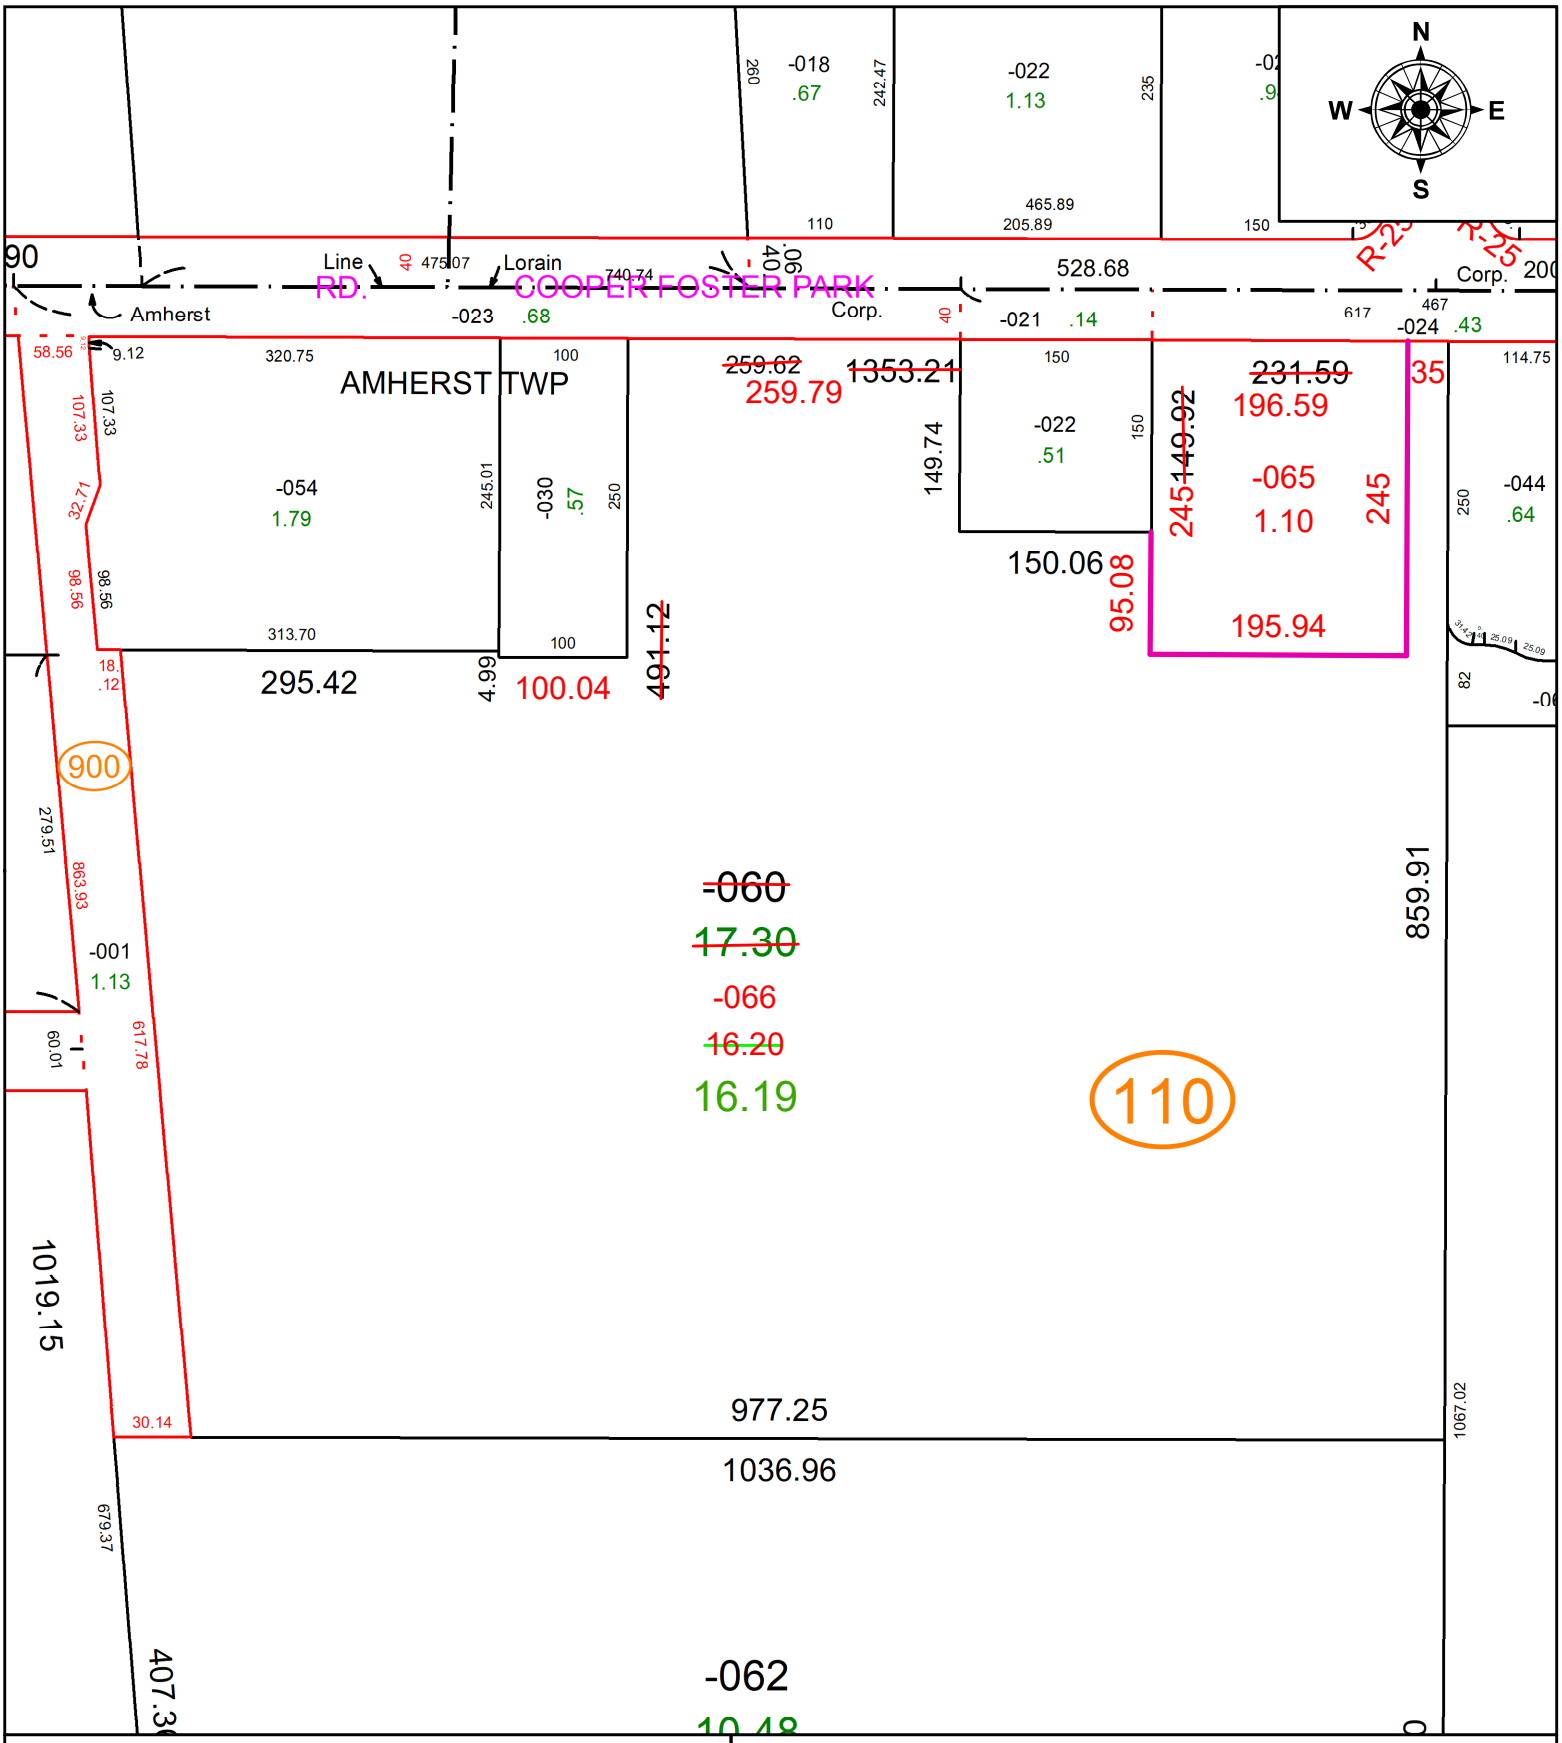

SPLITS/DEEDS PROCESSED
LORAIN COUNTY TAX MAP DEPARTMENT
226 MIDDLE AVE. ELYRIA, OH

SURVEYED BY: AMY M. KELLY **SURV # 50881**
CLOSURE: 1: 1074125
MAP PAGE(S): 05-00-041
APPOVED BY: AC **DATE:** May 04, 2023
SCALE: 1 in = 150 ft **PRIOR INSTRUMENT:** 2021- 0850996