PARENT PARCEL: 03-00-109-128-006
CHILD PARCEL: XX-XX-XXX-XXX-XXX
STARTING POINT: S.E. CORNER OF SUBLOT 27 IN RIDGEWOOD ALLOTMENT P.V 7 PG. 5

21-04688-C

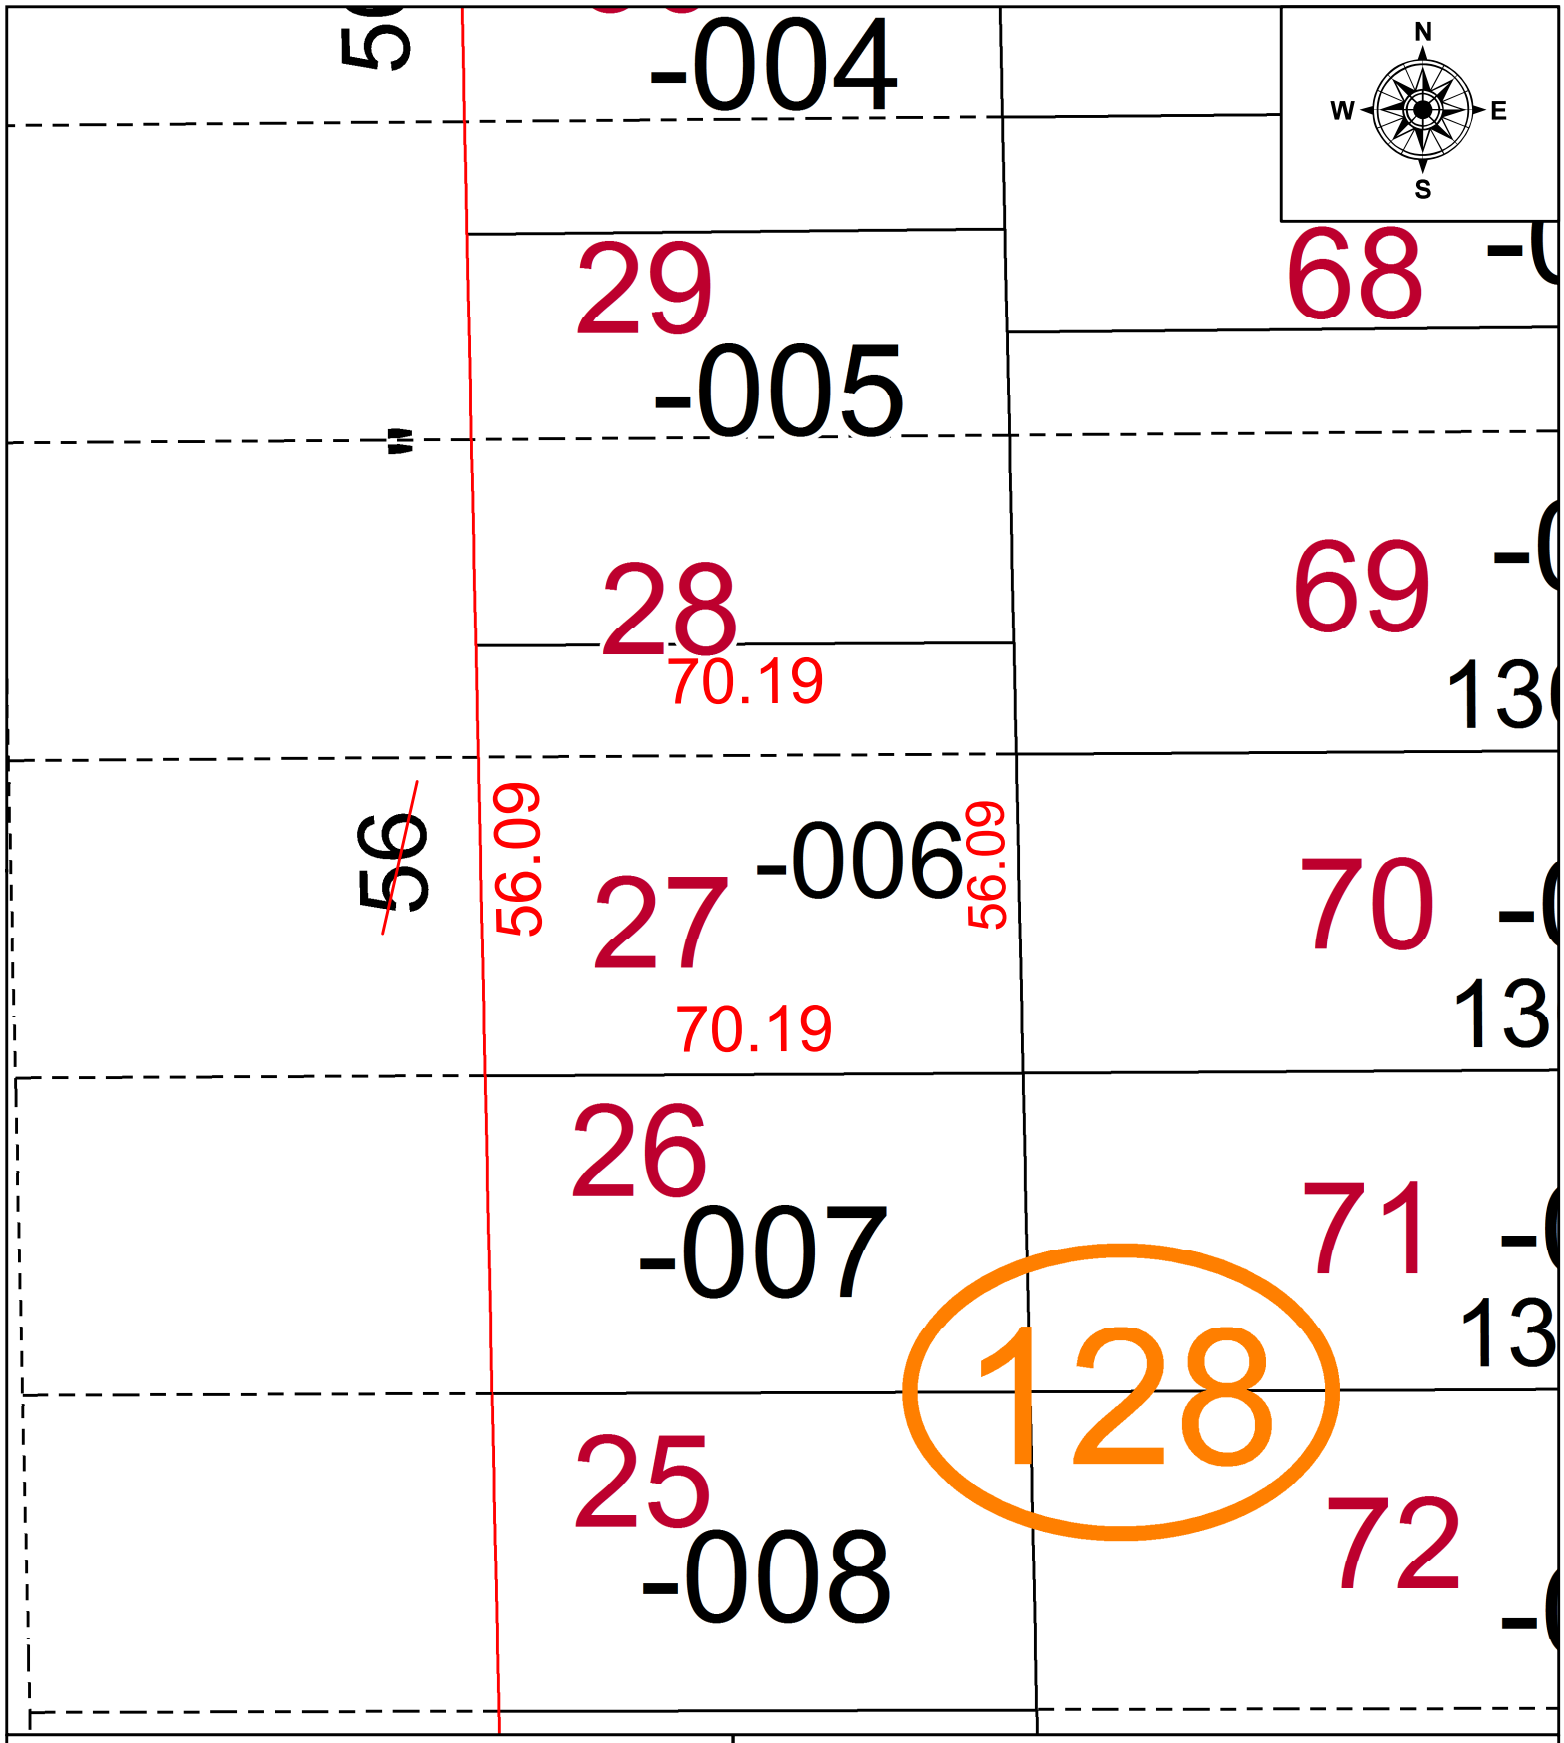

SPLITS/DEEDS PROCESSED
LORAIN COUNTY TAX MAP DEPARTMENT
226 MIDDLE AVE. ELYRIA, OH

SURVEYED BY: THOMAS SIMON
CLOSURE: 1: -2147483648
MAP PAGE(S): 03-00-109
APPOVED BY: DMA **DATE:** 10/18/2021
SCALE: 1" = 25' **PRIOR INSTRUMENT:** 20160573814