PARENT PARCEL: 08-13-012-000-009 & -011

CHILD PARCEL: 08-13-012-000-013

STARTING POINT: AC CORR PER SURV BY TIMOTHY D. HOZALSKI

23-04688

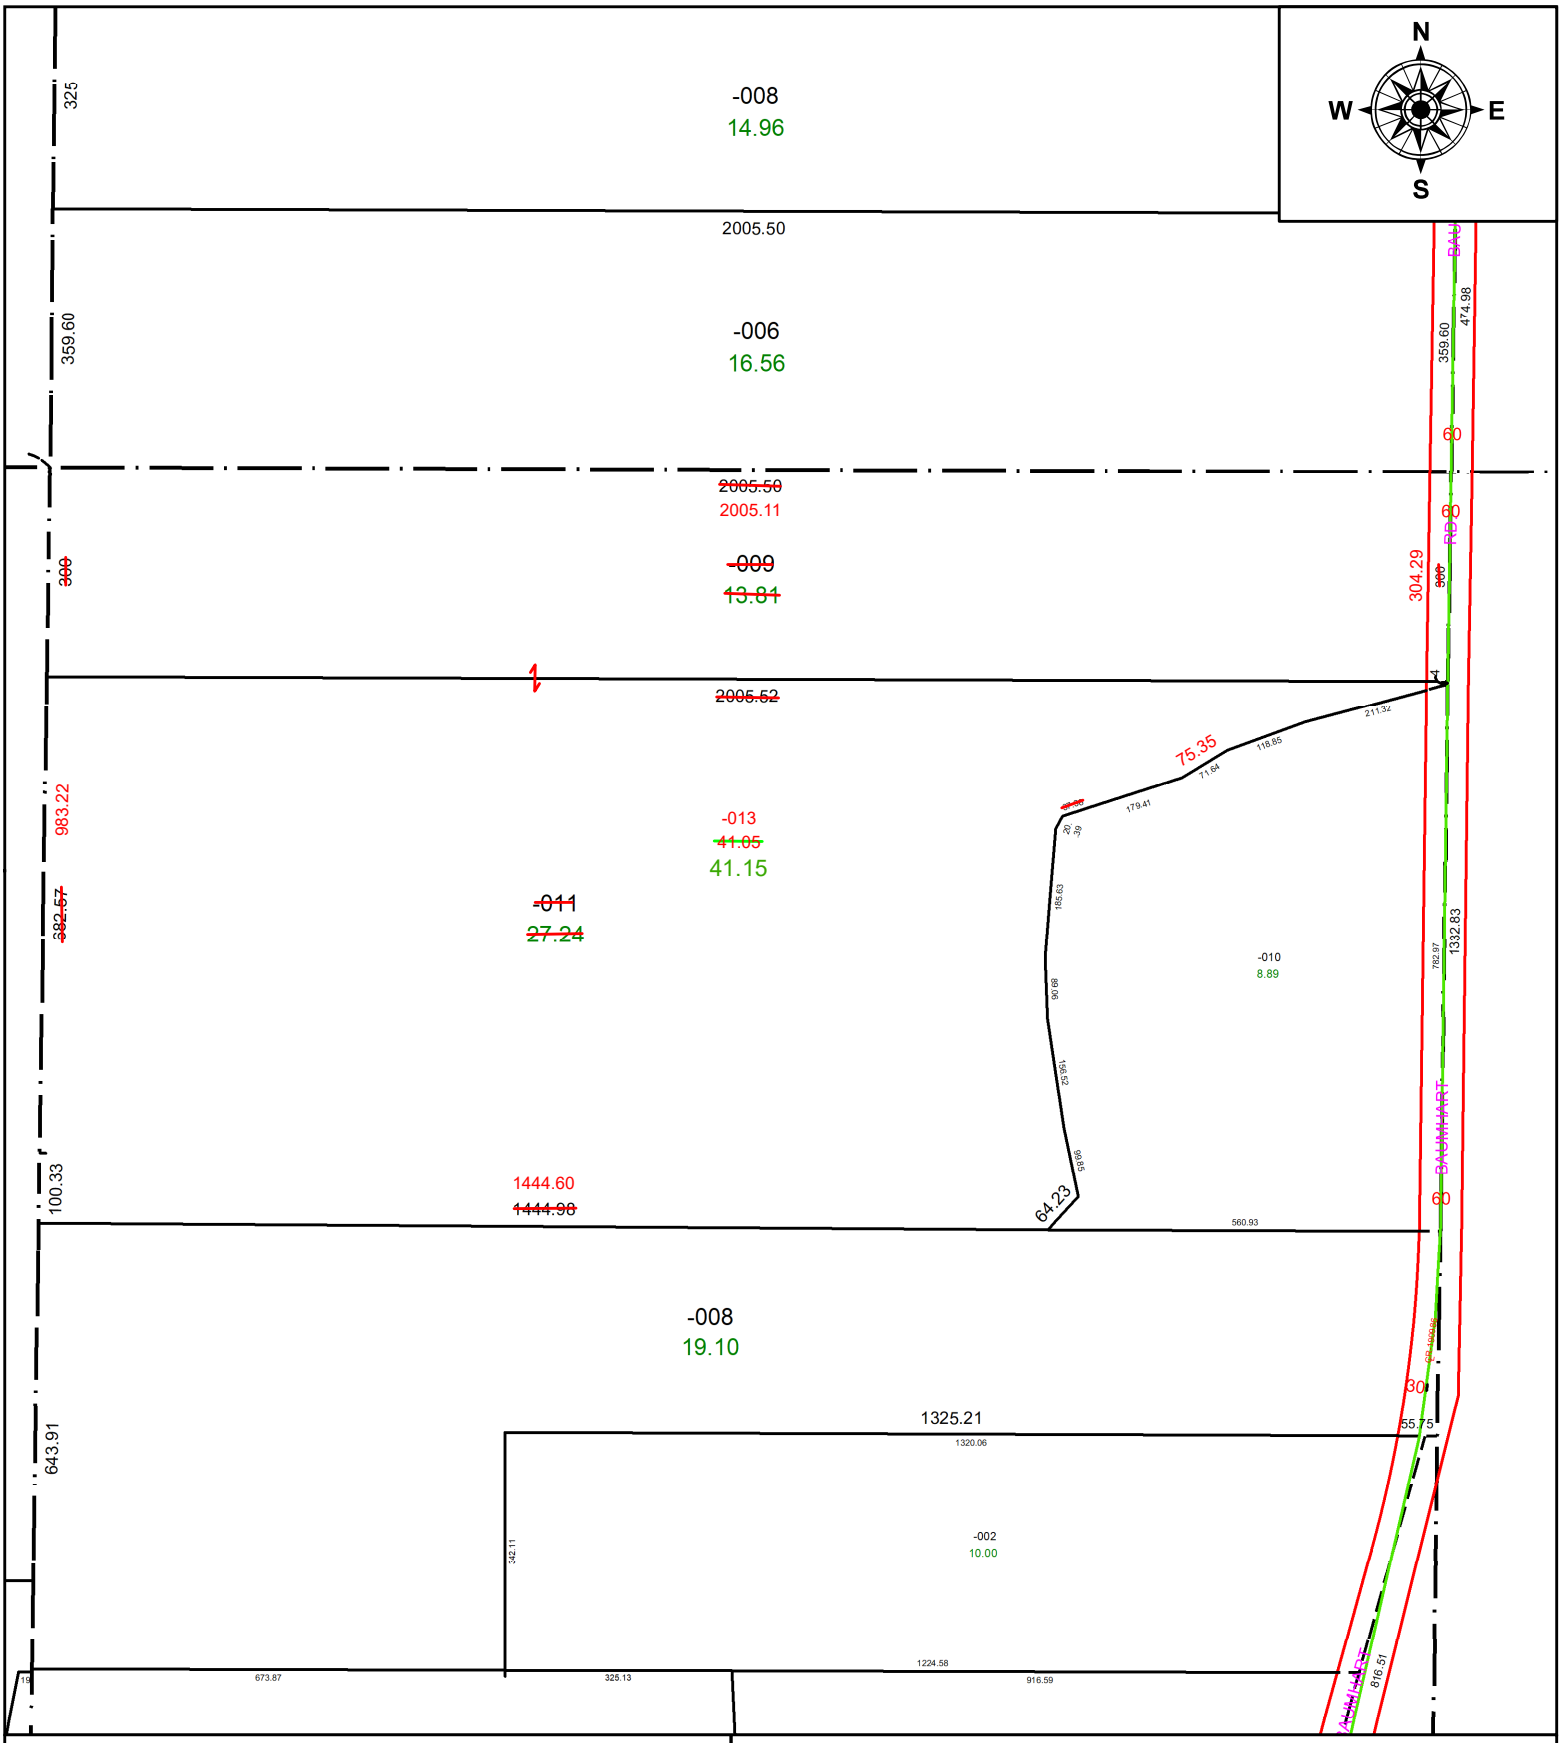

SPLITS/DEEDS PROCESSED

LORAIN COUNTY TAX MAP DEPARTMENT
226 MIDDLE AVE. ELYRIA, OH

SURVEYED BY: TIMOTHY D. HOZALSKI **SURV # 50883**

CLOSURE: 1: 4747785

MAP PAGE(S): 08-13-012

APPOVED BY: AC **DATE:** May 09, 2023

SCALE: 1 in = 275 ft **PRIOR INSTRUMENT:** 2022- 0899526