PARENT PARCEL: ADD TO DUP PER DEED VOL 803 PG 540

CHILD PARCEL: 06-25-007-000-275

STARTING POINT: SE CORNER OF LANDS OF THE GRANTOR

21-04690-C

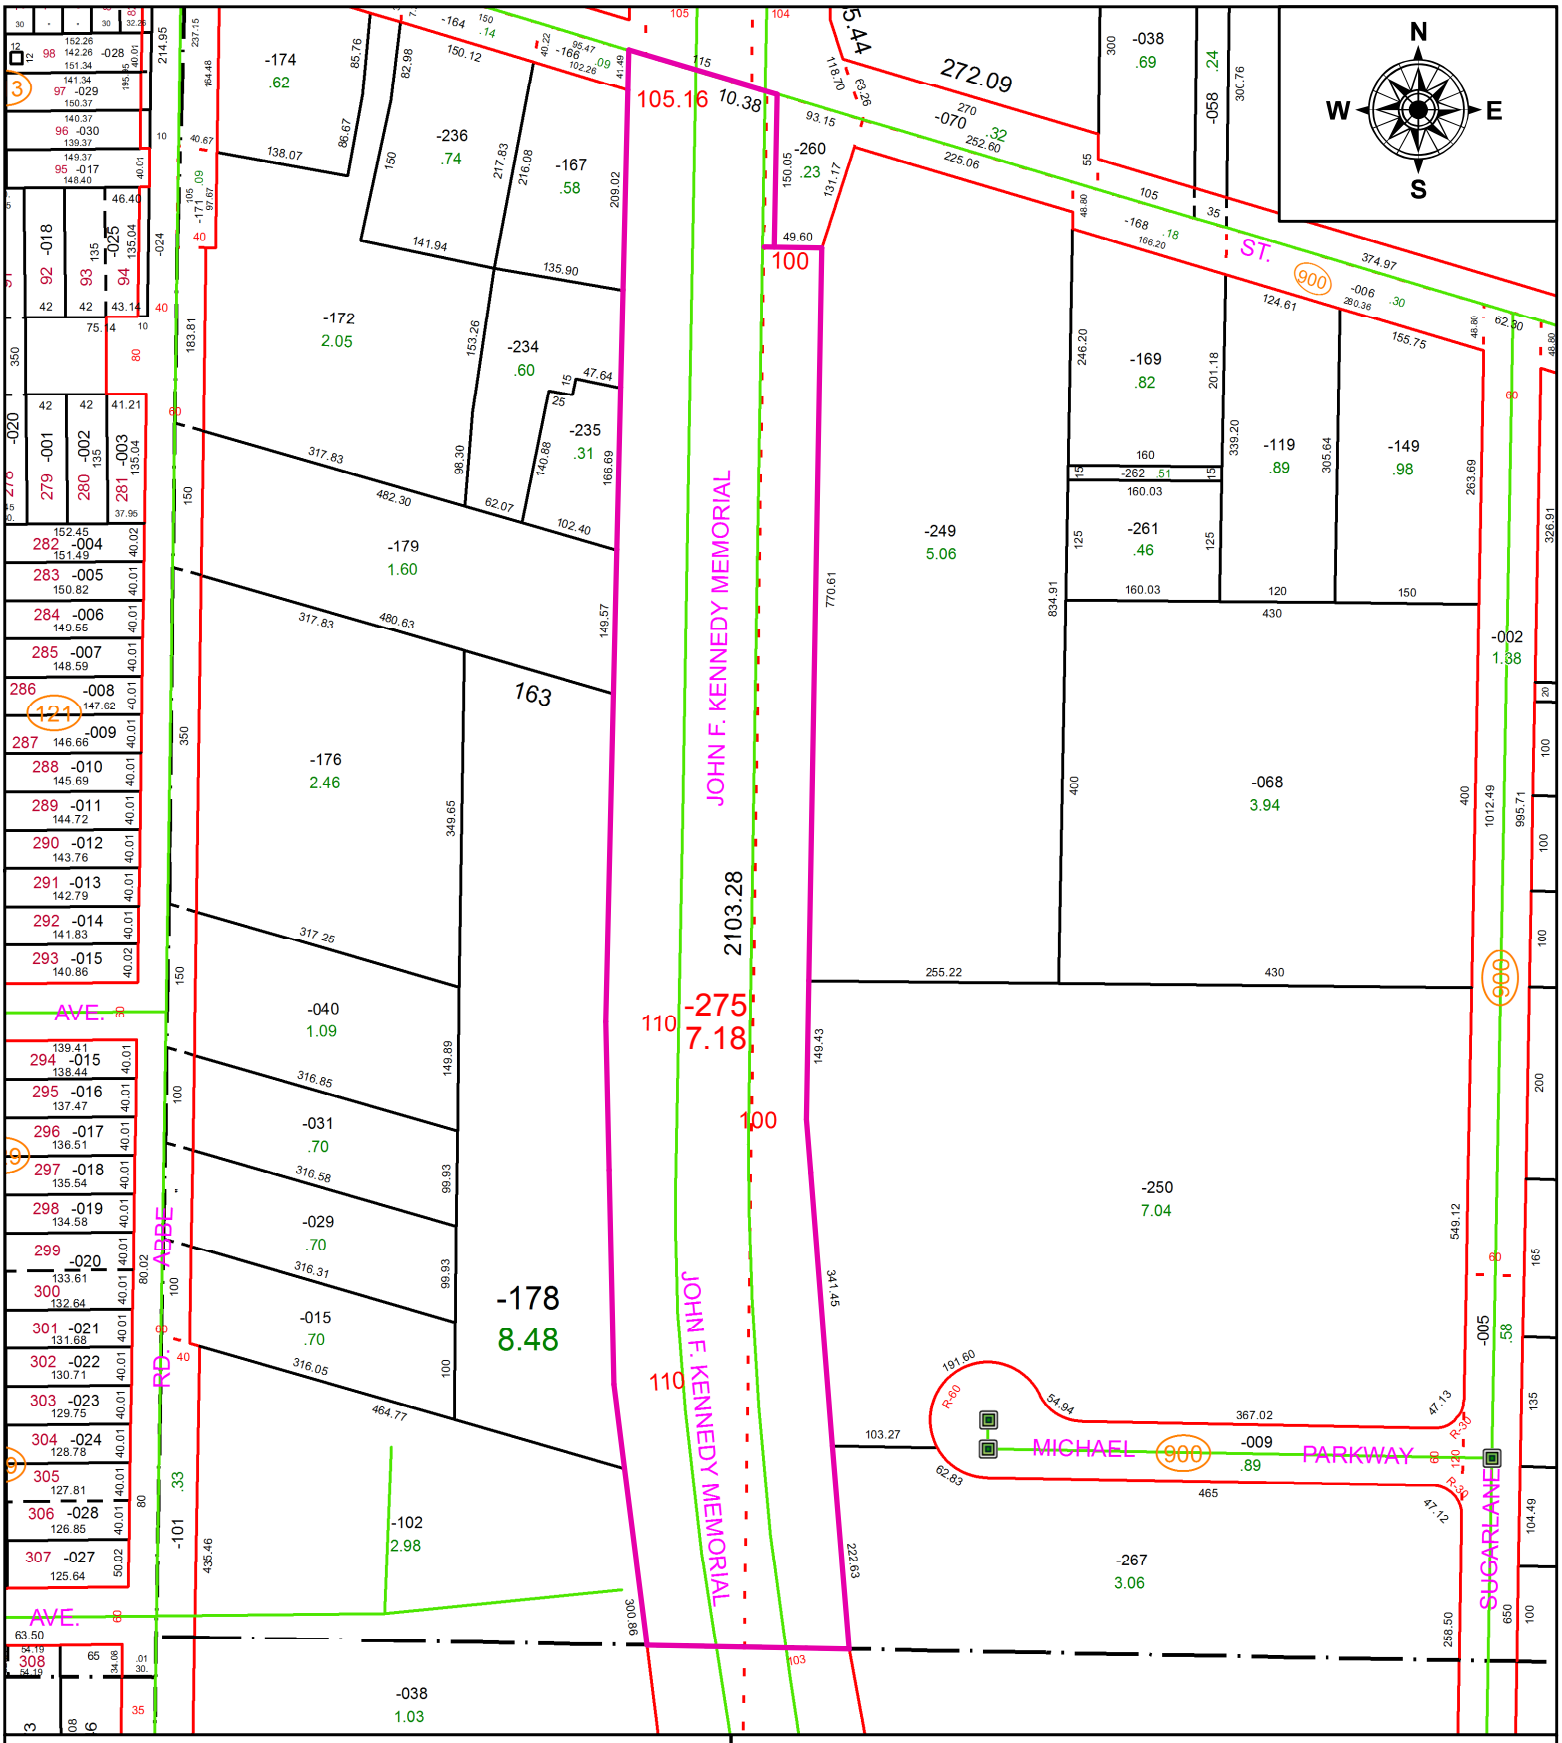

SPLITS/DEEDS PROCESSED

LORAIN COUNTY TAX MAP DEPARTMENT
226 MIDDLE AVE. ELYRIA, OH

SURVEYED BY: N/A
CLOSURE: N/A
MAP PAGE(S): 06-125
APPOVED BY: AC **DATE:** 10/18/2021
SCALE: 1" = 200 **PRIOR INSTRUMENT:** VOL 400 PG 396