PARENT PARCEL: 12-00-015-000-053

CHILD PARCEL: AC. CORR. PER SURVEY

STARTING POINT: CL OF ROYALTON RD. & N.E CORNER OF AUDREY & JOHN PALMER

21-04697-A

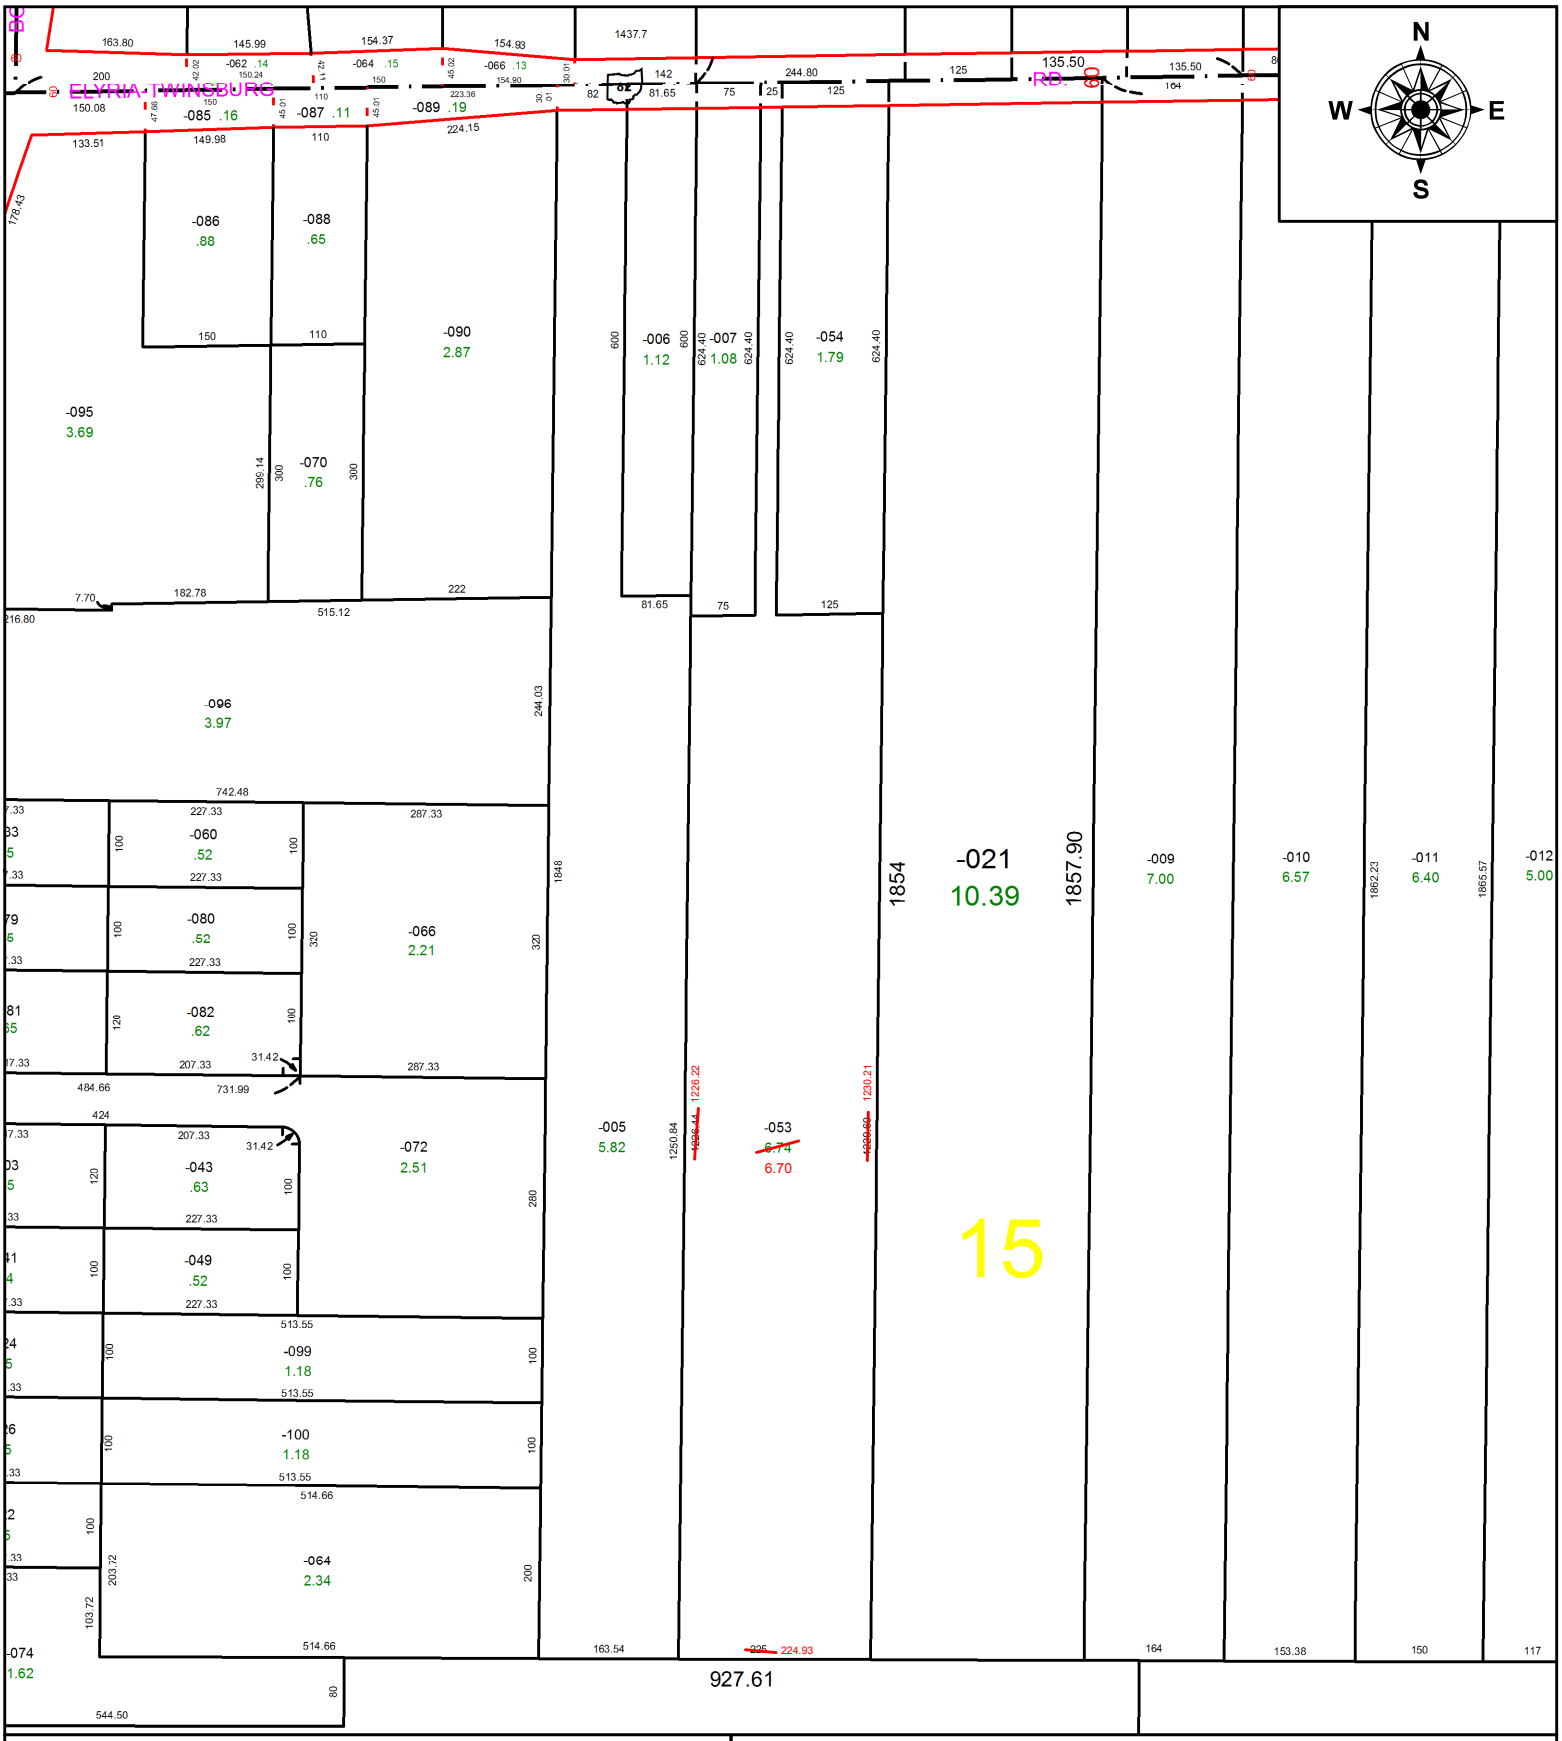

SPLITS/DEEDS PROCESSED

LORAIN COUNTY TAX MAP DEPARTMENT
226 MIDDLE AVE. ELYRIA, OH

SURVEYED BY: GEORGE HOFMANN
CLOSURE: 1: 1174829
MAP PAGE(S): 12-00-015
APPOVED BY: DMA **DATE:** 10/21/2021
SCALE: 1" = 225' **PRIOR INSTRUMENT:** 20170614740