PARENT PARCEL: 16-00-094-000-027
CHILD PARCEL: 16-00-094-000-028 & -029
STARTING POINT: SOUTHEAST CORNER OF ORIGINAL LOT 94

23-04697

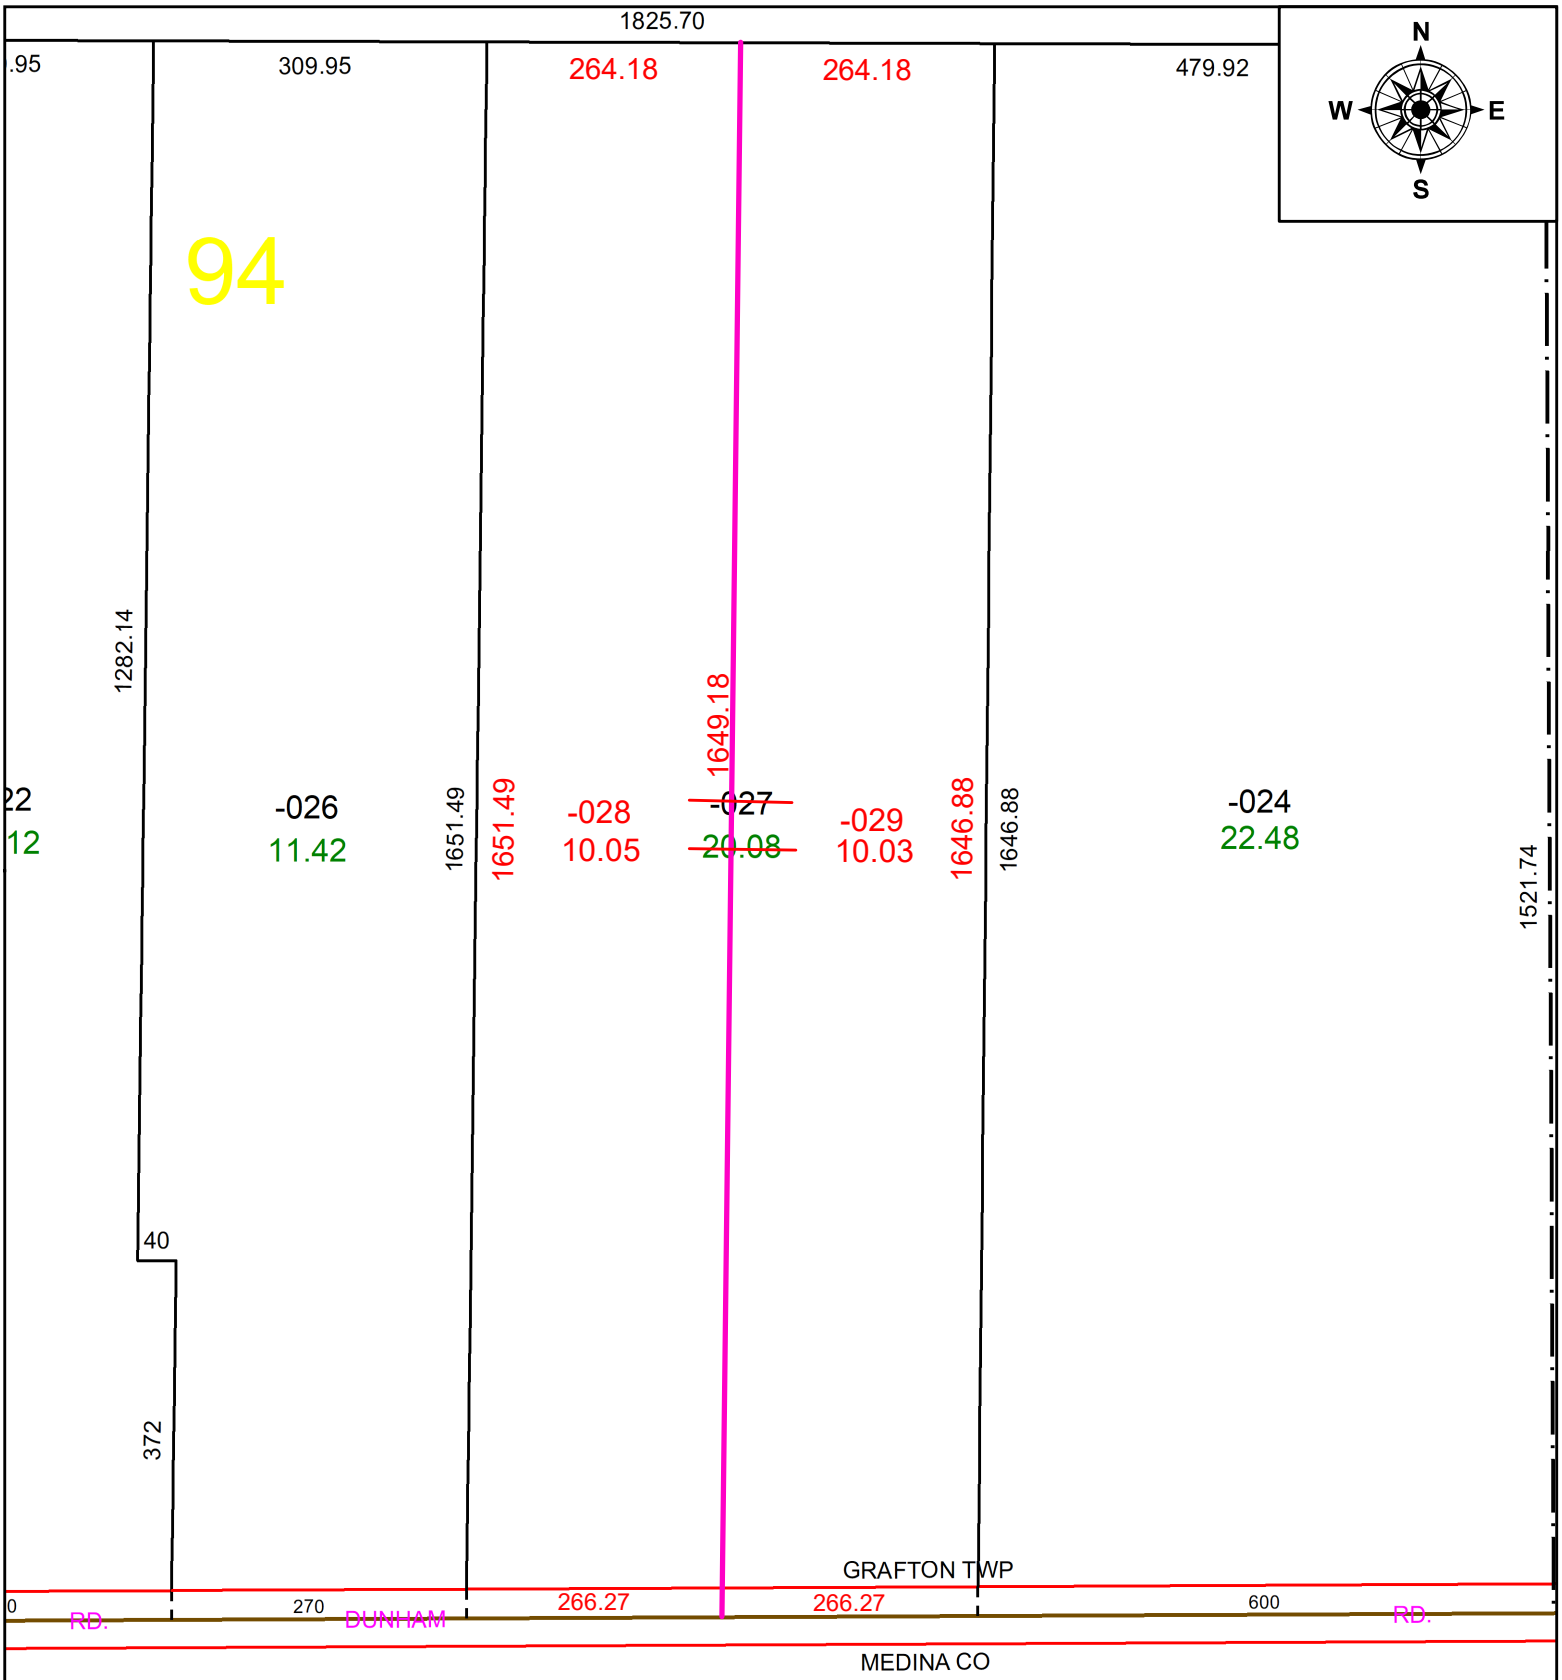

SPLITS/DEEDS PROCESSED
LORAIN COUNTY TAX MAP DEPARTMENT
226 MIDDLE AVE. ELYRIA, OH

SURVEYED BY: DOUGLAS S. JEWEL **SURVEY #:** 50898
CLOSURE: 1: 282,963
MAP PAGE(S): 16-00-094
APPOVED BY: SP **DATE:** 5/18/2023
SCALE: 1" = 200' **PRIOR INSTRUMENT:** 2011-0364852