PARENT PARCEL: 02-00-051-141-011, -012, -013, -014, -015, -016, -017

CHILD PARCEL: 02-00-051-141-045

STARTING POINT: COMBINATION PER DEED

23-04703

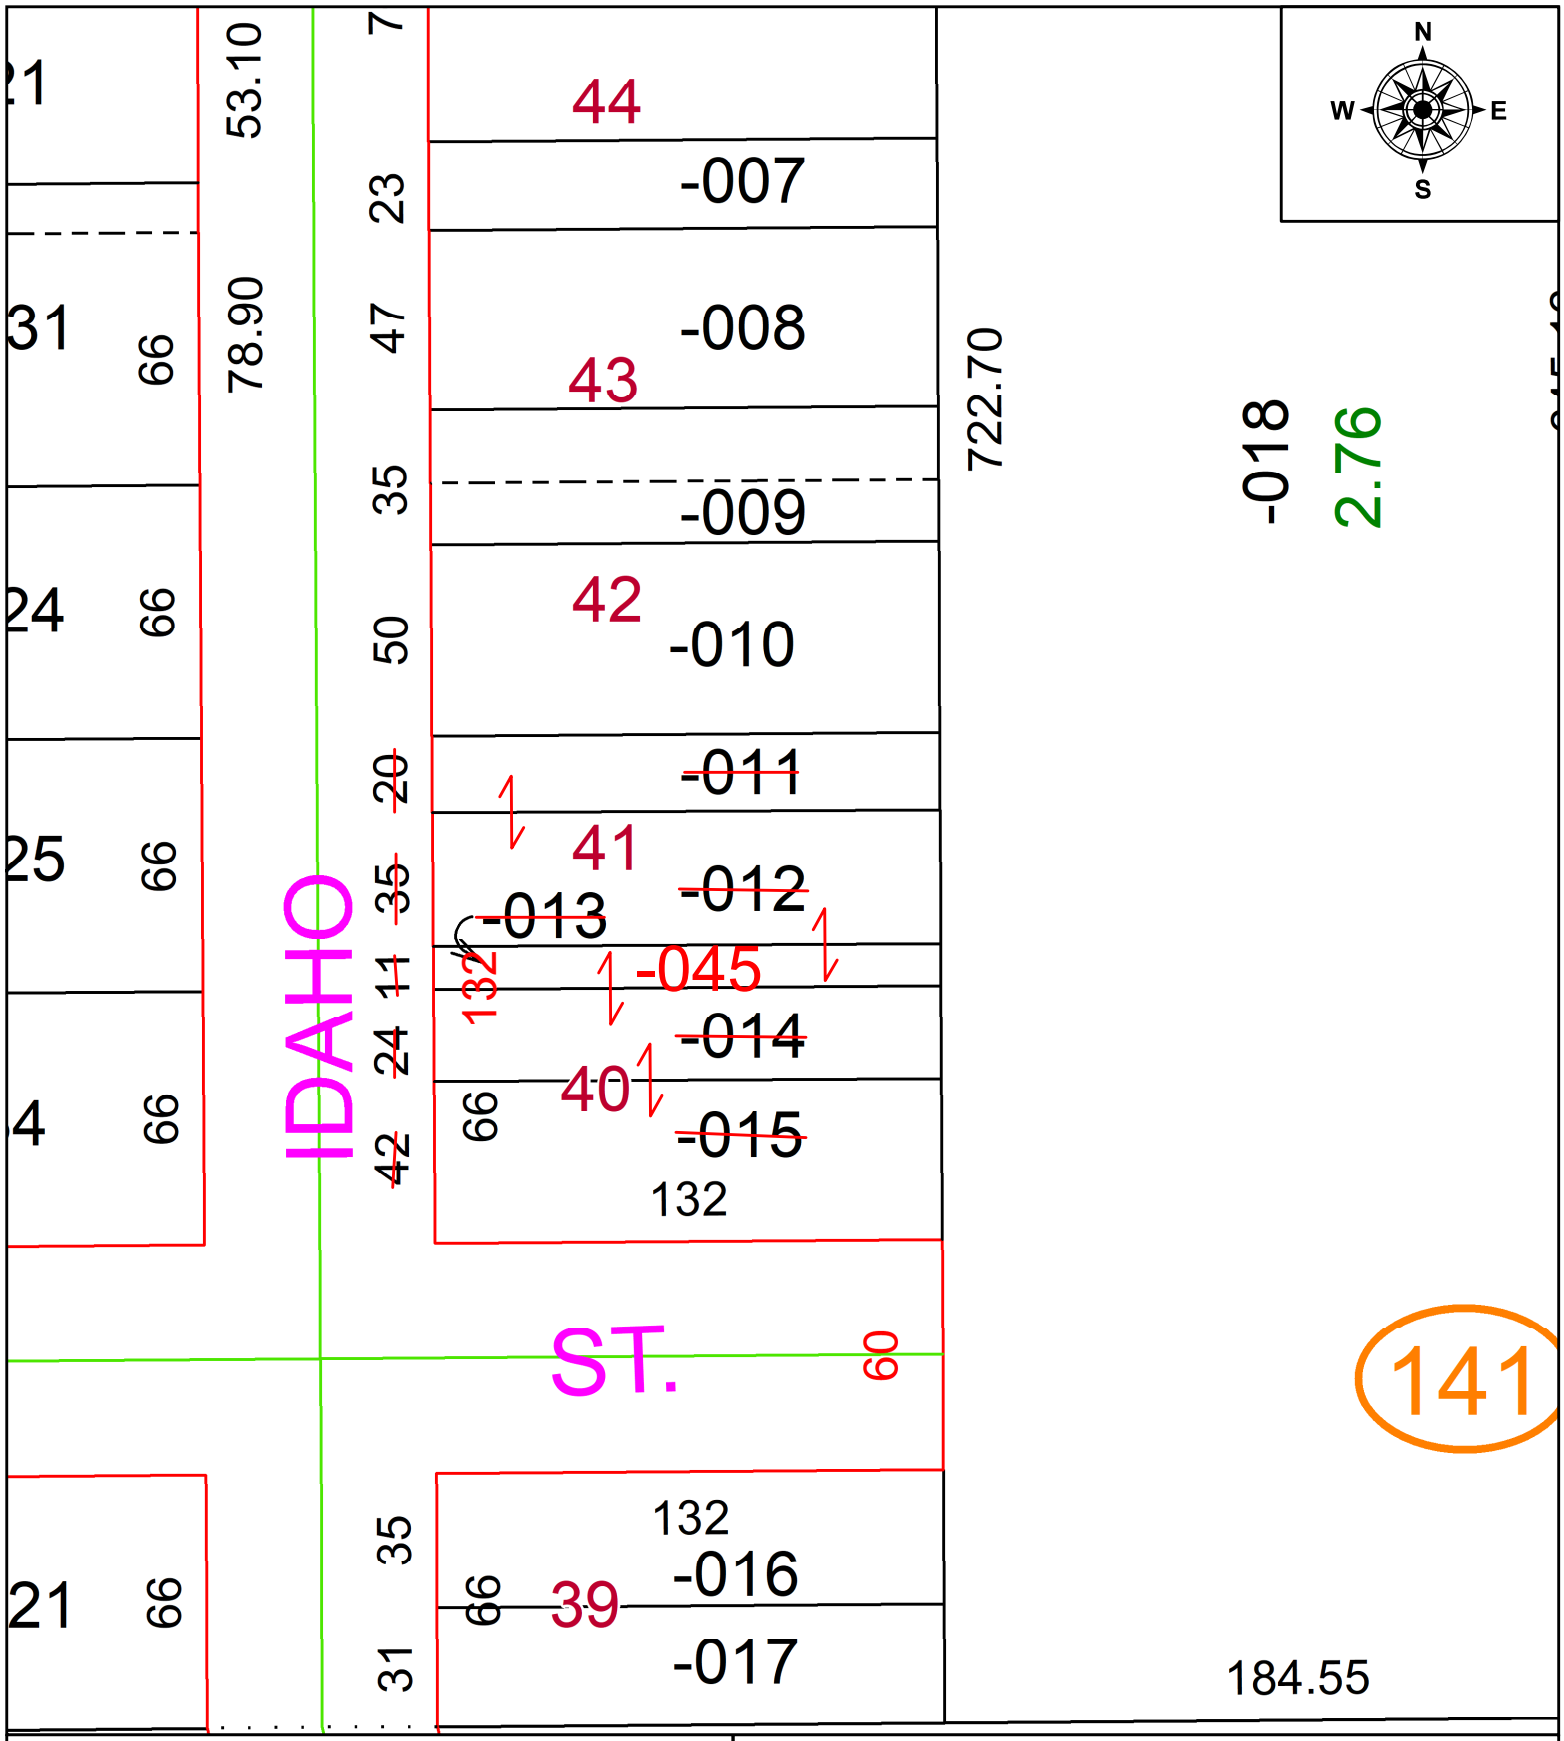

SPLITS/DEEDS PROCESSED

LORAIN COUNTY TAX MAP DEPARTMENT
226 MIDDLE AVE. ELYRIA, OH

SURVEYED BY: N/A **SURV # N/A**

CLOSURE: N/A

MAP PAGE(S): 02-00-051

APPOVED BY: AC **DATE:** May 31, 2023

SCALE: 1 in = 50 ft **PRIOR INSTRUMENT:** 2017- 0649045