PARENT PARCEL: 09-00-031-000-005

CHILD PARCEL: 09-00-031-000-022 & -023

STARTING POINT: S LINE OF LOT NO. 31 **AC CORR PER PRIOR DEED 2013- 0468354**

21-04704-C

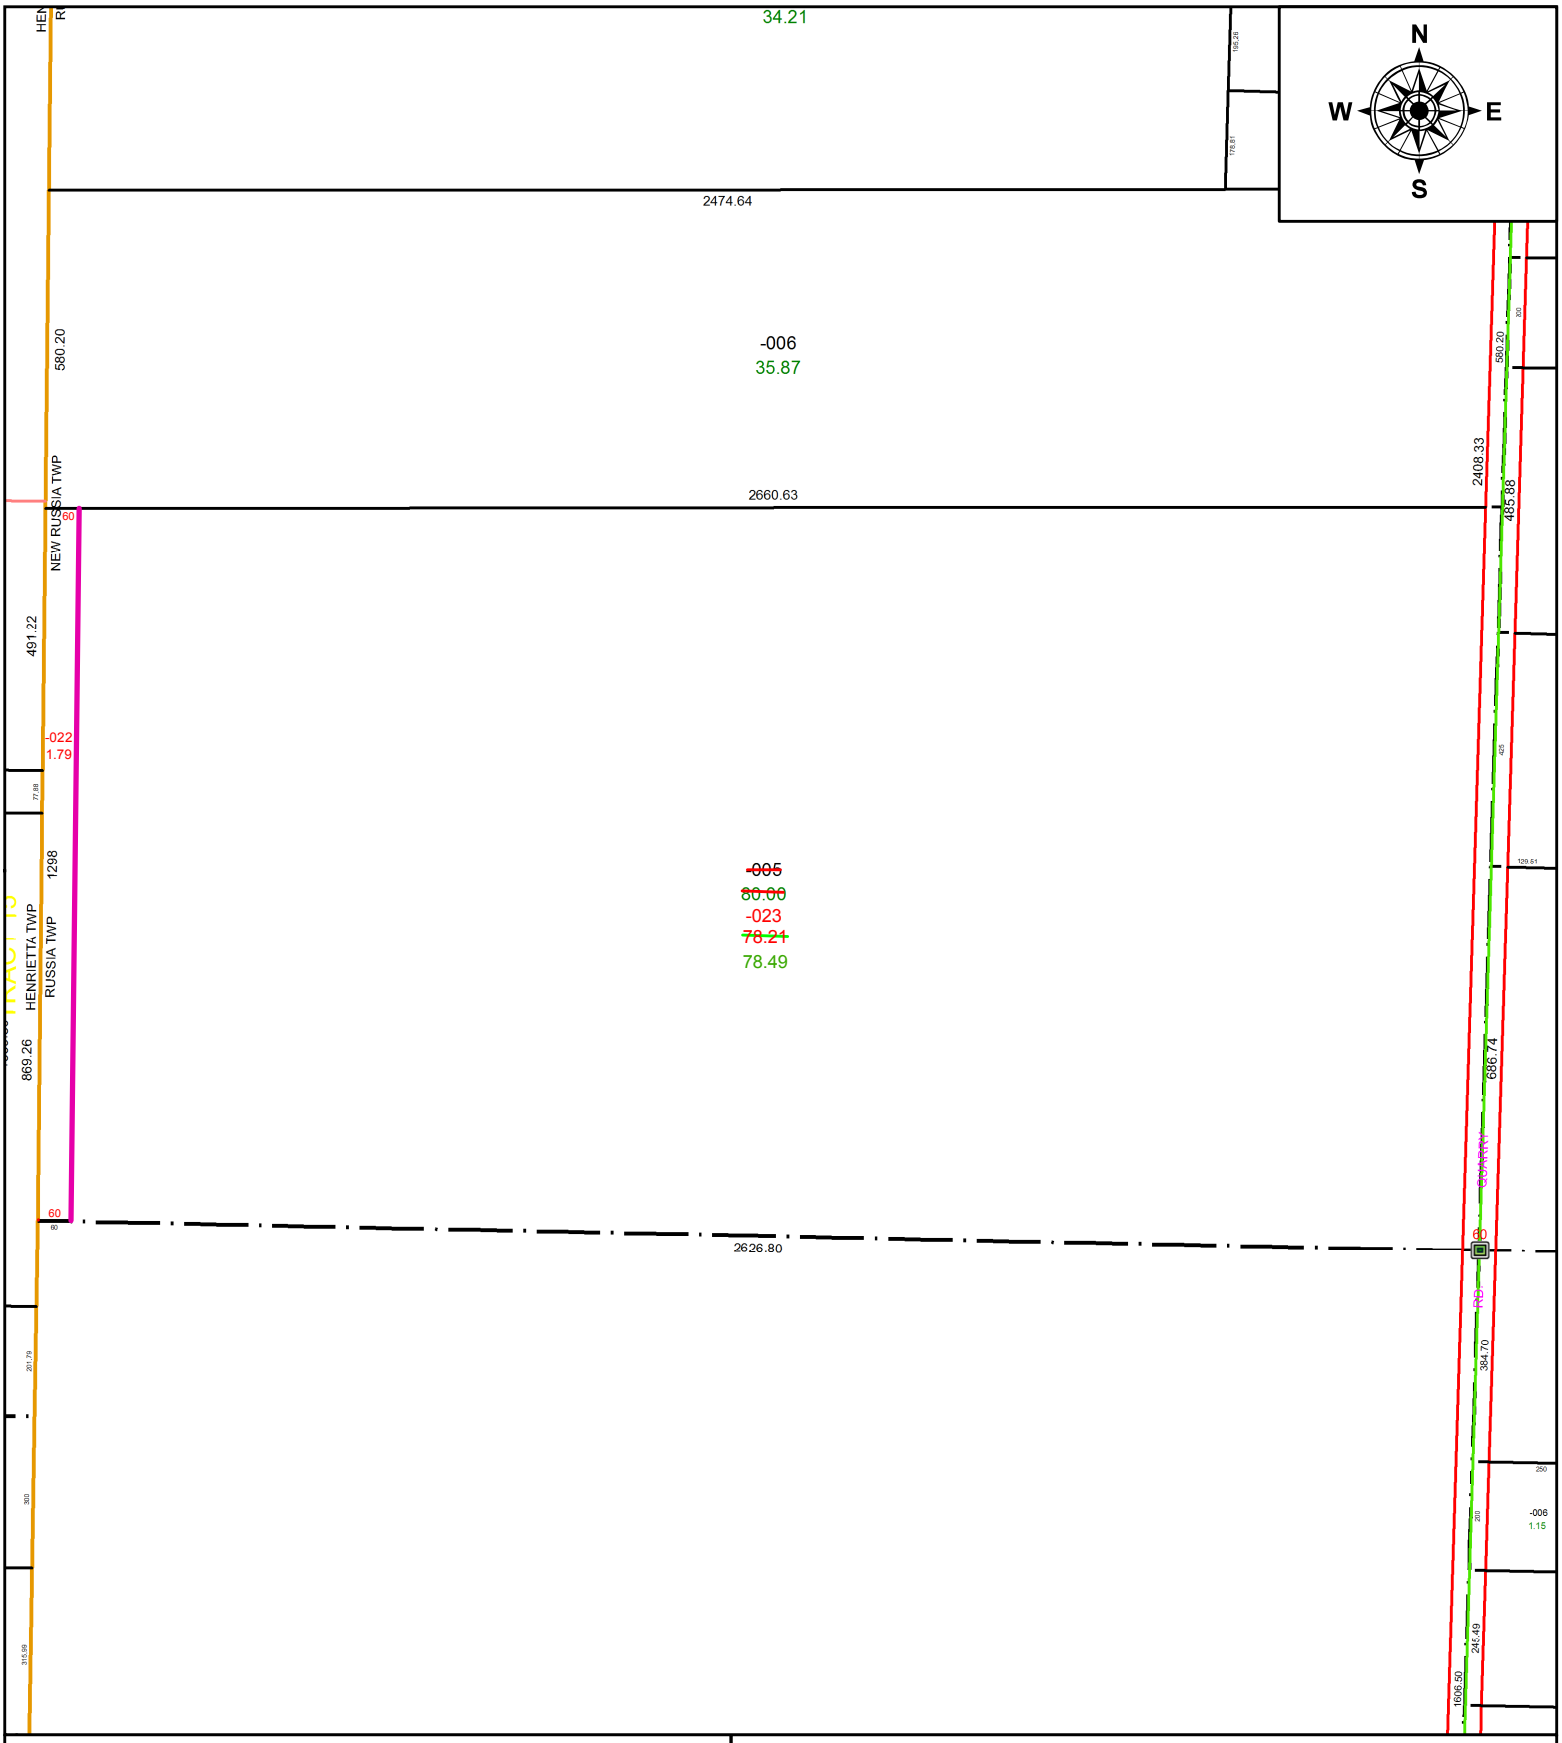

SPLITS/DEEDS PROCESSED

LORAIN COUNTY TAX MAP DEPARTMENT
226 MIDDLE AVE. ELYRIA, OH

SURVEYED BY: N/A
CLOSURE: N/A
MAP PAGE(S): 09-00-031-A, B
APPOVED BY: AC **DATE:** 10/26/2021
SCALE: 1" = 350 **PRIOR INSTRUMENT:** 2013- 0468354