PARENT PARCEL: 09-00-011-000-020

CHILD PARCEL: 09-00-011-000-035, -036, -037, -038

STARTING POINT: THE CENTERLINE INTERSECTION OF RUSSIA AND QUARRY RD

23-04710

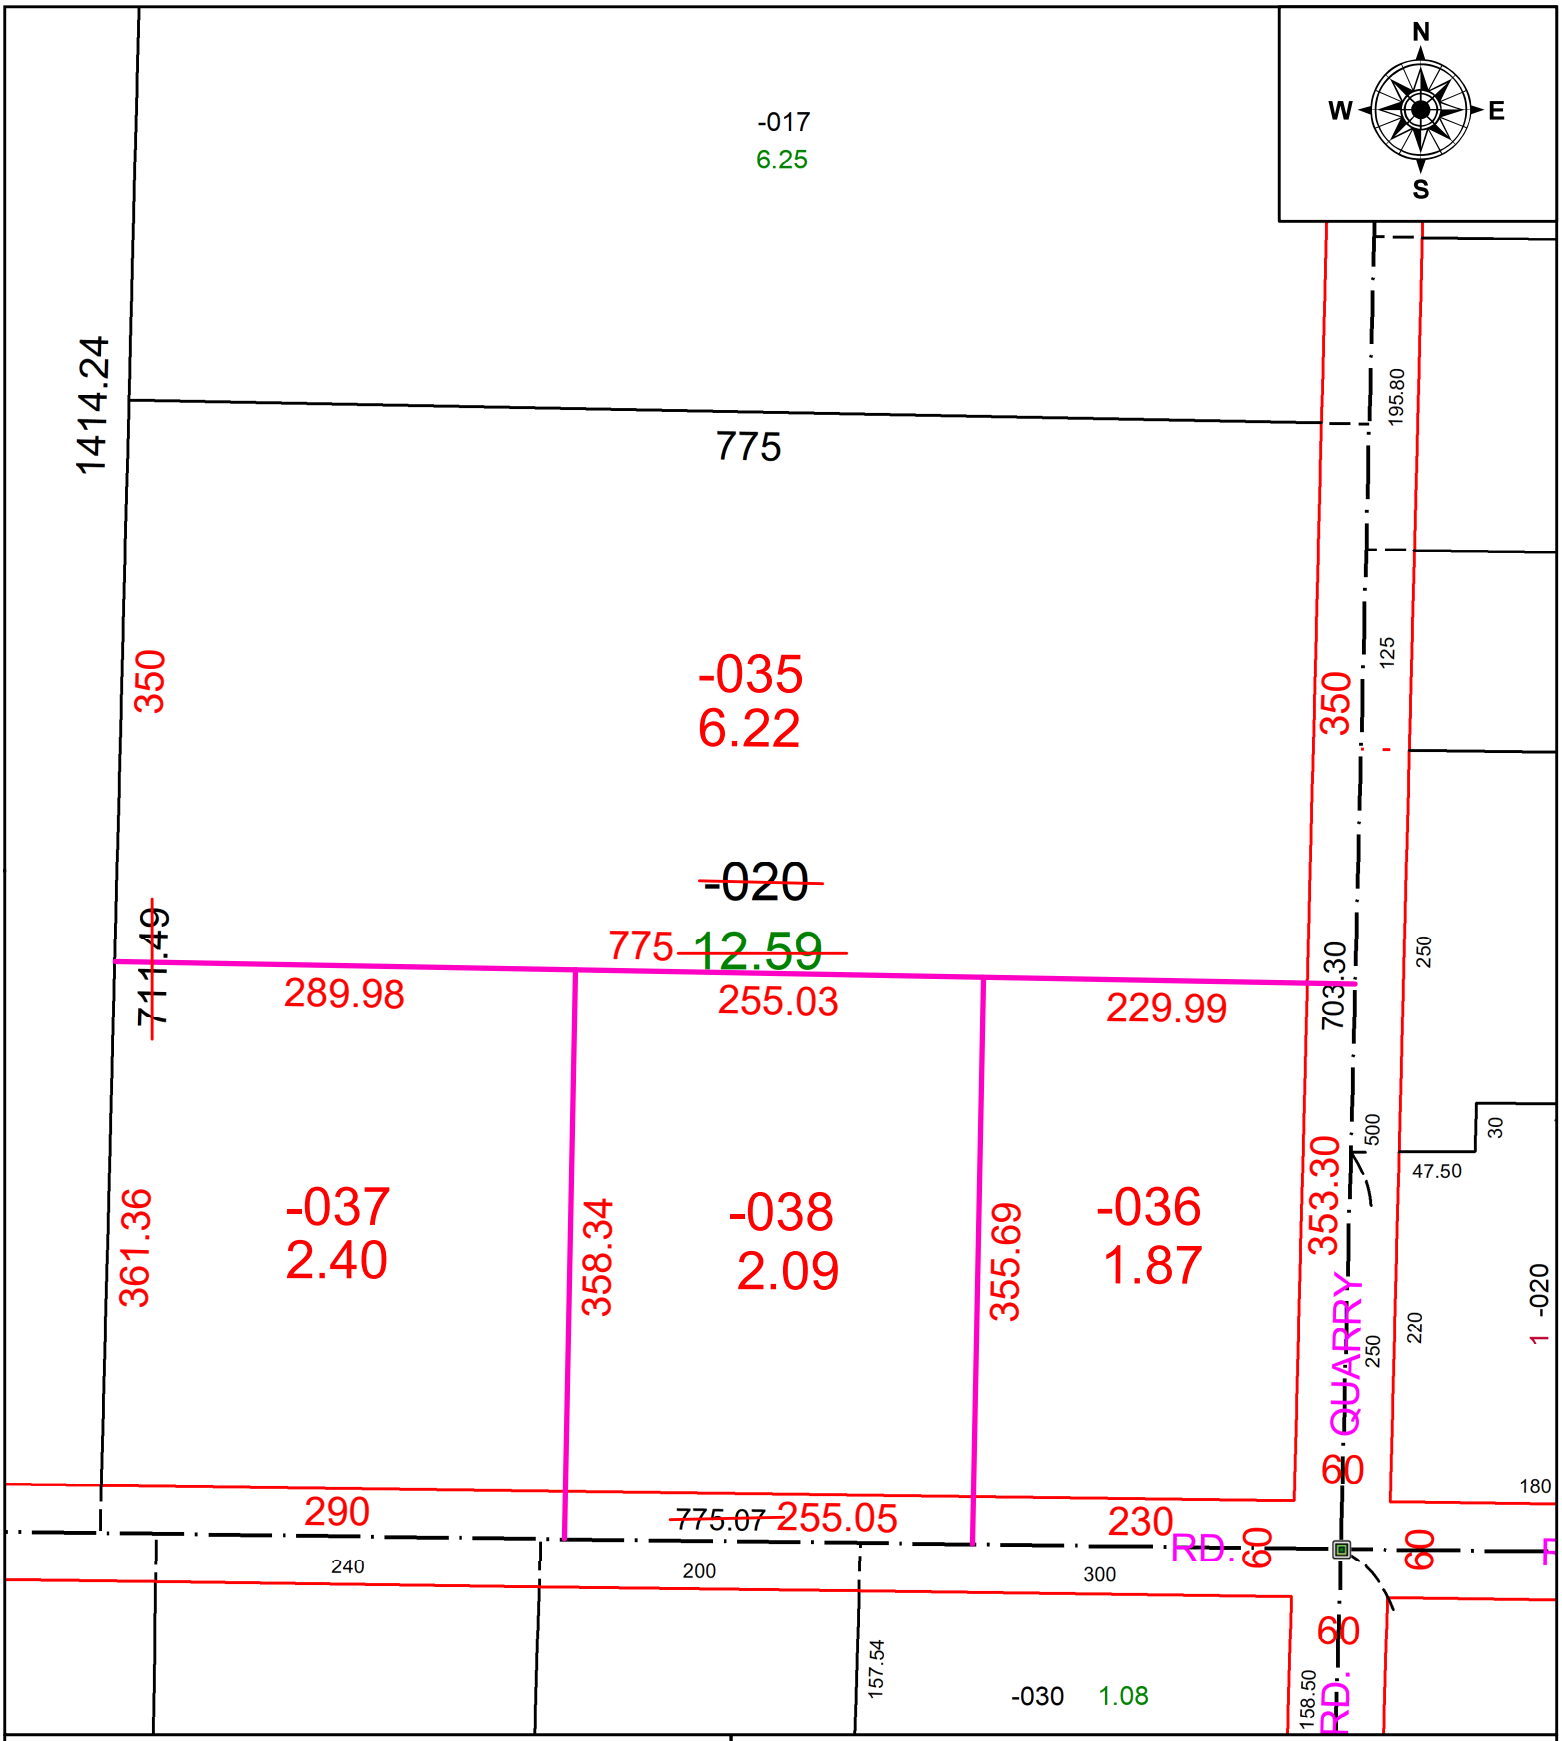

SPLITS/DEEDS PROCESSED

LORAIN COUNTY TAX MAP DEPARTMENT
226 MIDDLE AVE. ELYRIA, OH

SURVEYED BY: THOMAS A. SIMON **SURVEY #:** 50916
CLOSURE: 1: 299,949
MAP PAGE(S): 09-00-011
APPOVED BY: SP **DATE:** 6/12/2023
SCALE: 1" = 120' **PRIOR INSTRUMENT:** 2011-0368363