PARENT PARCEL: 09-00-036-000-012

CHILD PARCEL: N/A ACREAGE CORRECTION PER SURVEYOR

STARTING POINT: SOUTHWESTERLY CORNER OF O.L. 36 & C/L OF SR 58

21-04712-A

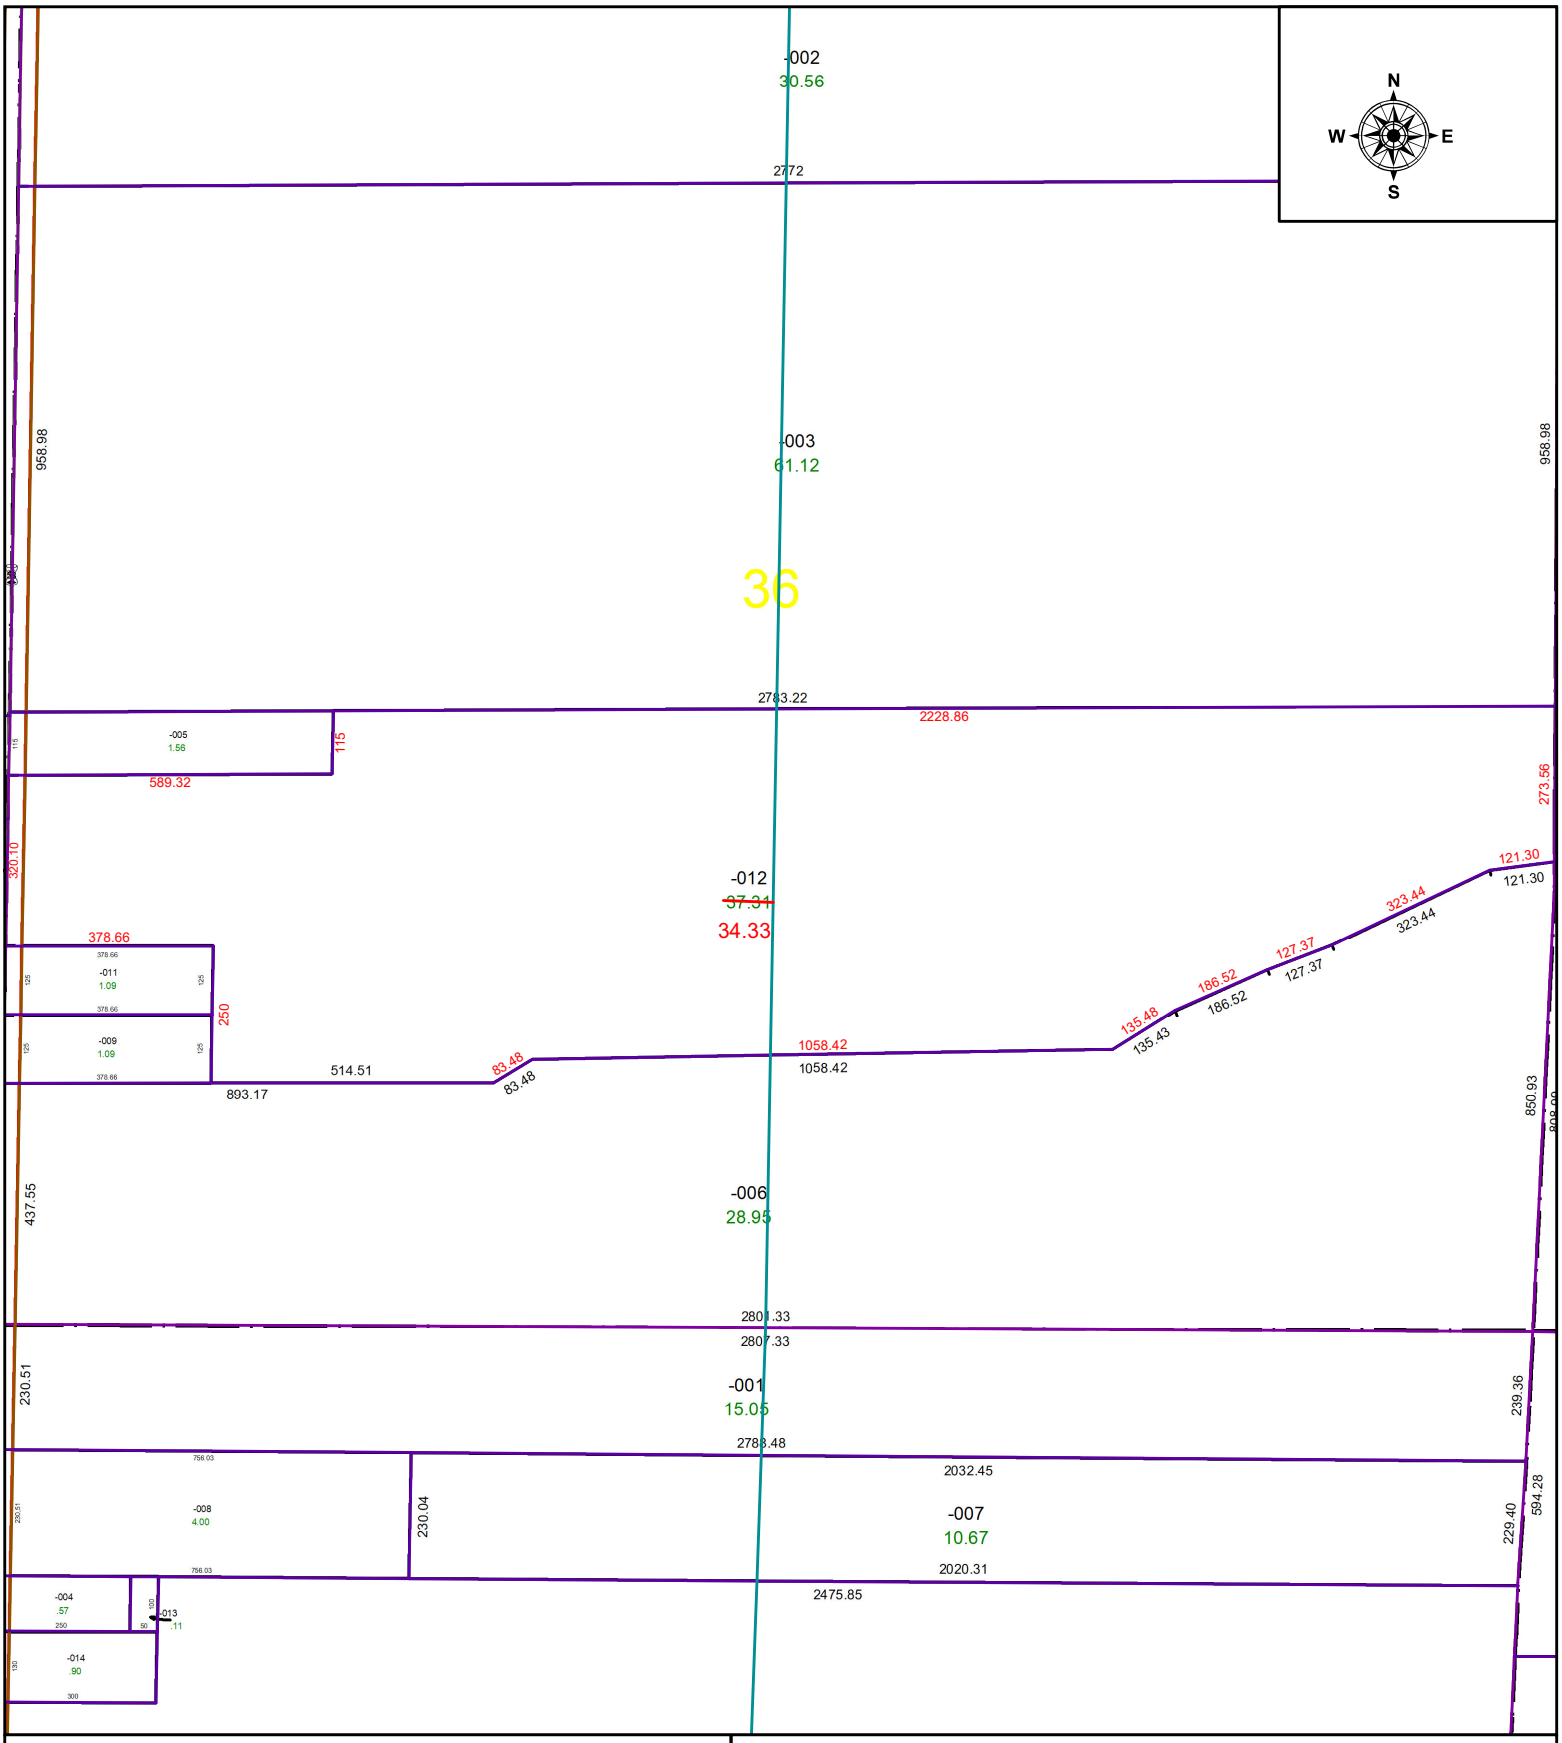

SPLITS/DEEDS PROCESSED

LORAIN COUNTY TAX MAP DEPARTMENT
226 MIDDLE AVE. ELYRIA, OH

SURVEYED BY: THOMAS SIMON
CLOSURE: 1: 791850
MAP PAGE(S): 09-00-036
APPOVED BY: WRZ **DATE:** 11/5/2021
SCALE: 1" = 350 **PRIOR INSTRUMENT:** 2001-0772959