PARENT PARCEL: CERT. OF CORRECTION PV. 109 PG. 62

CHILD PARCEL: XX-XX-XXX-XXX-XXX

STARTING POINT: XXXXXX

21-04713-C

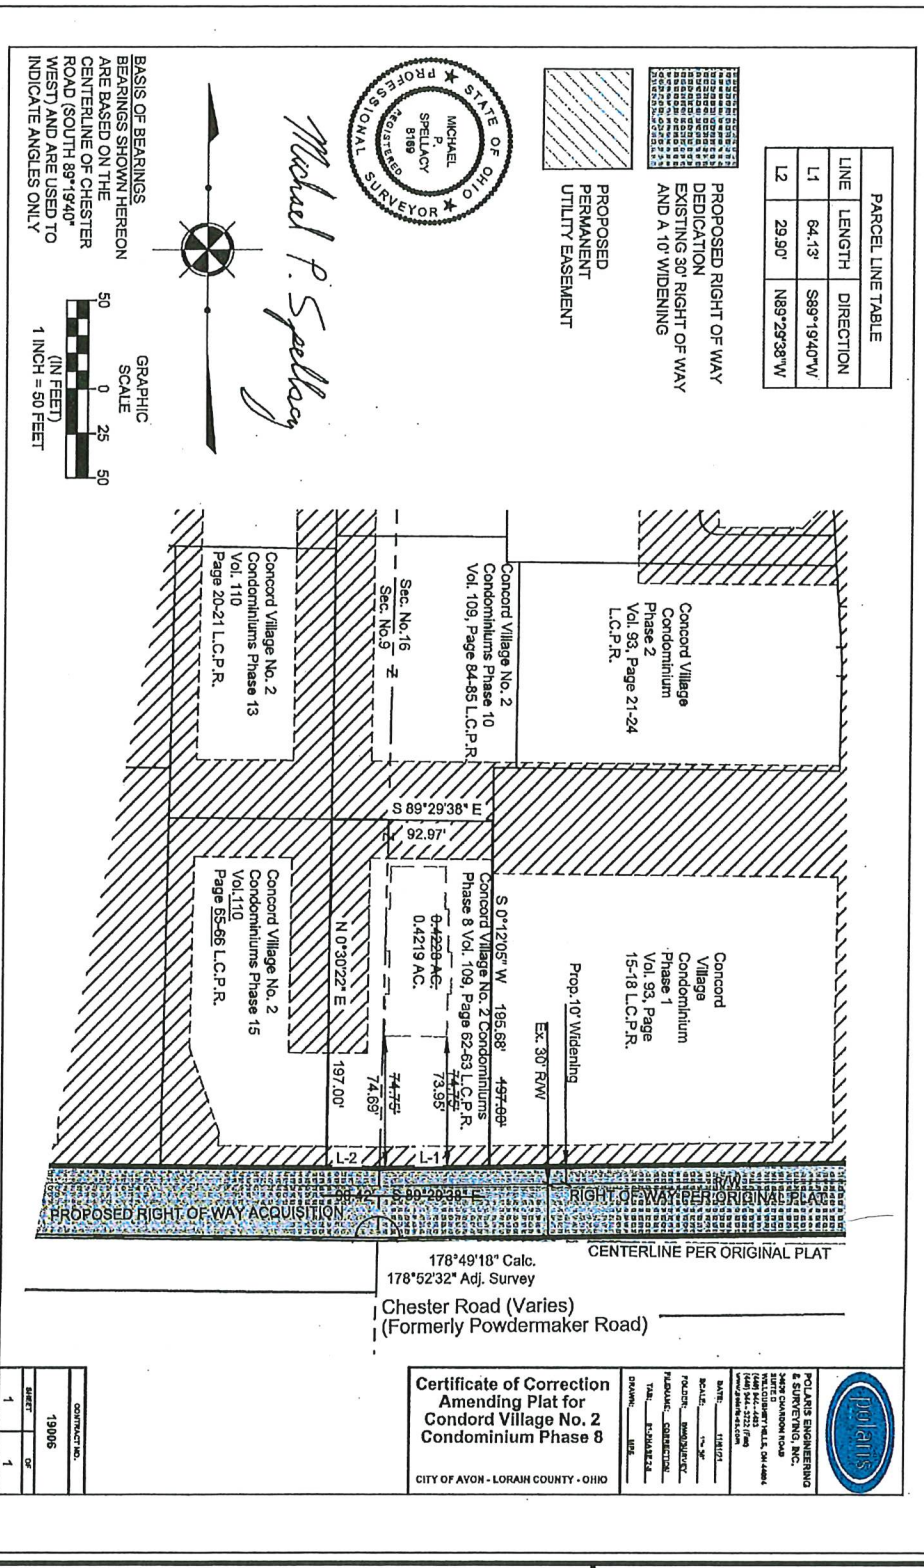

SPLITS/DEEDS PROCESSED

LORAIN COUNTY TAX MAP DEPARTMENT

226 MIDDLE AVE. ELYRIA, OHIO

SURVEYED BY: MICHAEL SPELLACY

CLOSURE: 1' : 10,000

MAP PAGE(S): 04-00-016

APPROVED BY: TJS DATE: 11/5/2021

SCALE: 1"= 100 PRIOR INSTRUMENT: PV.109 PG.62