PARENT PARCEL: 08-15-006-000-018

CHILD PARCEL: 08-15-006-000-022 & -023 ACREAGE CORRECTION PER SURVEYOR TIMOTHY HOZALSKI

STARTING POINT: MONUMENT BOX @ C/L OF BAUMHART RD & SOUTH LINE OF O.L. 6

23-04715

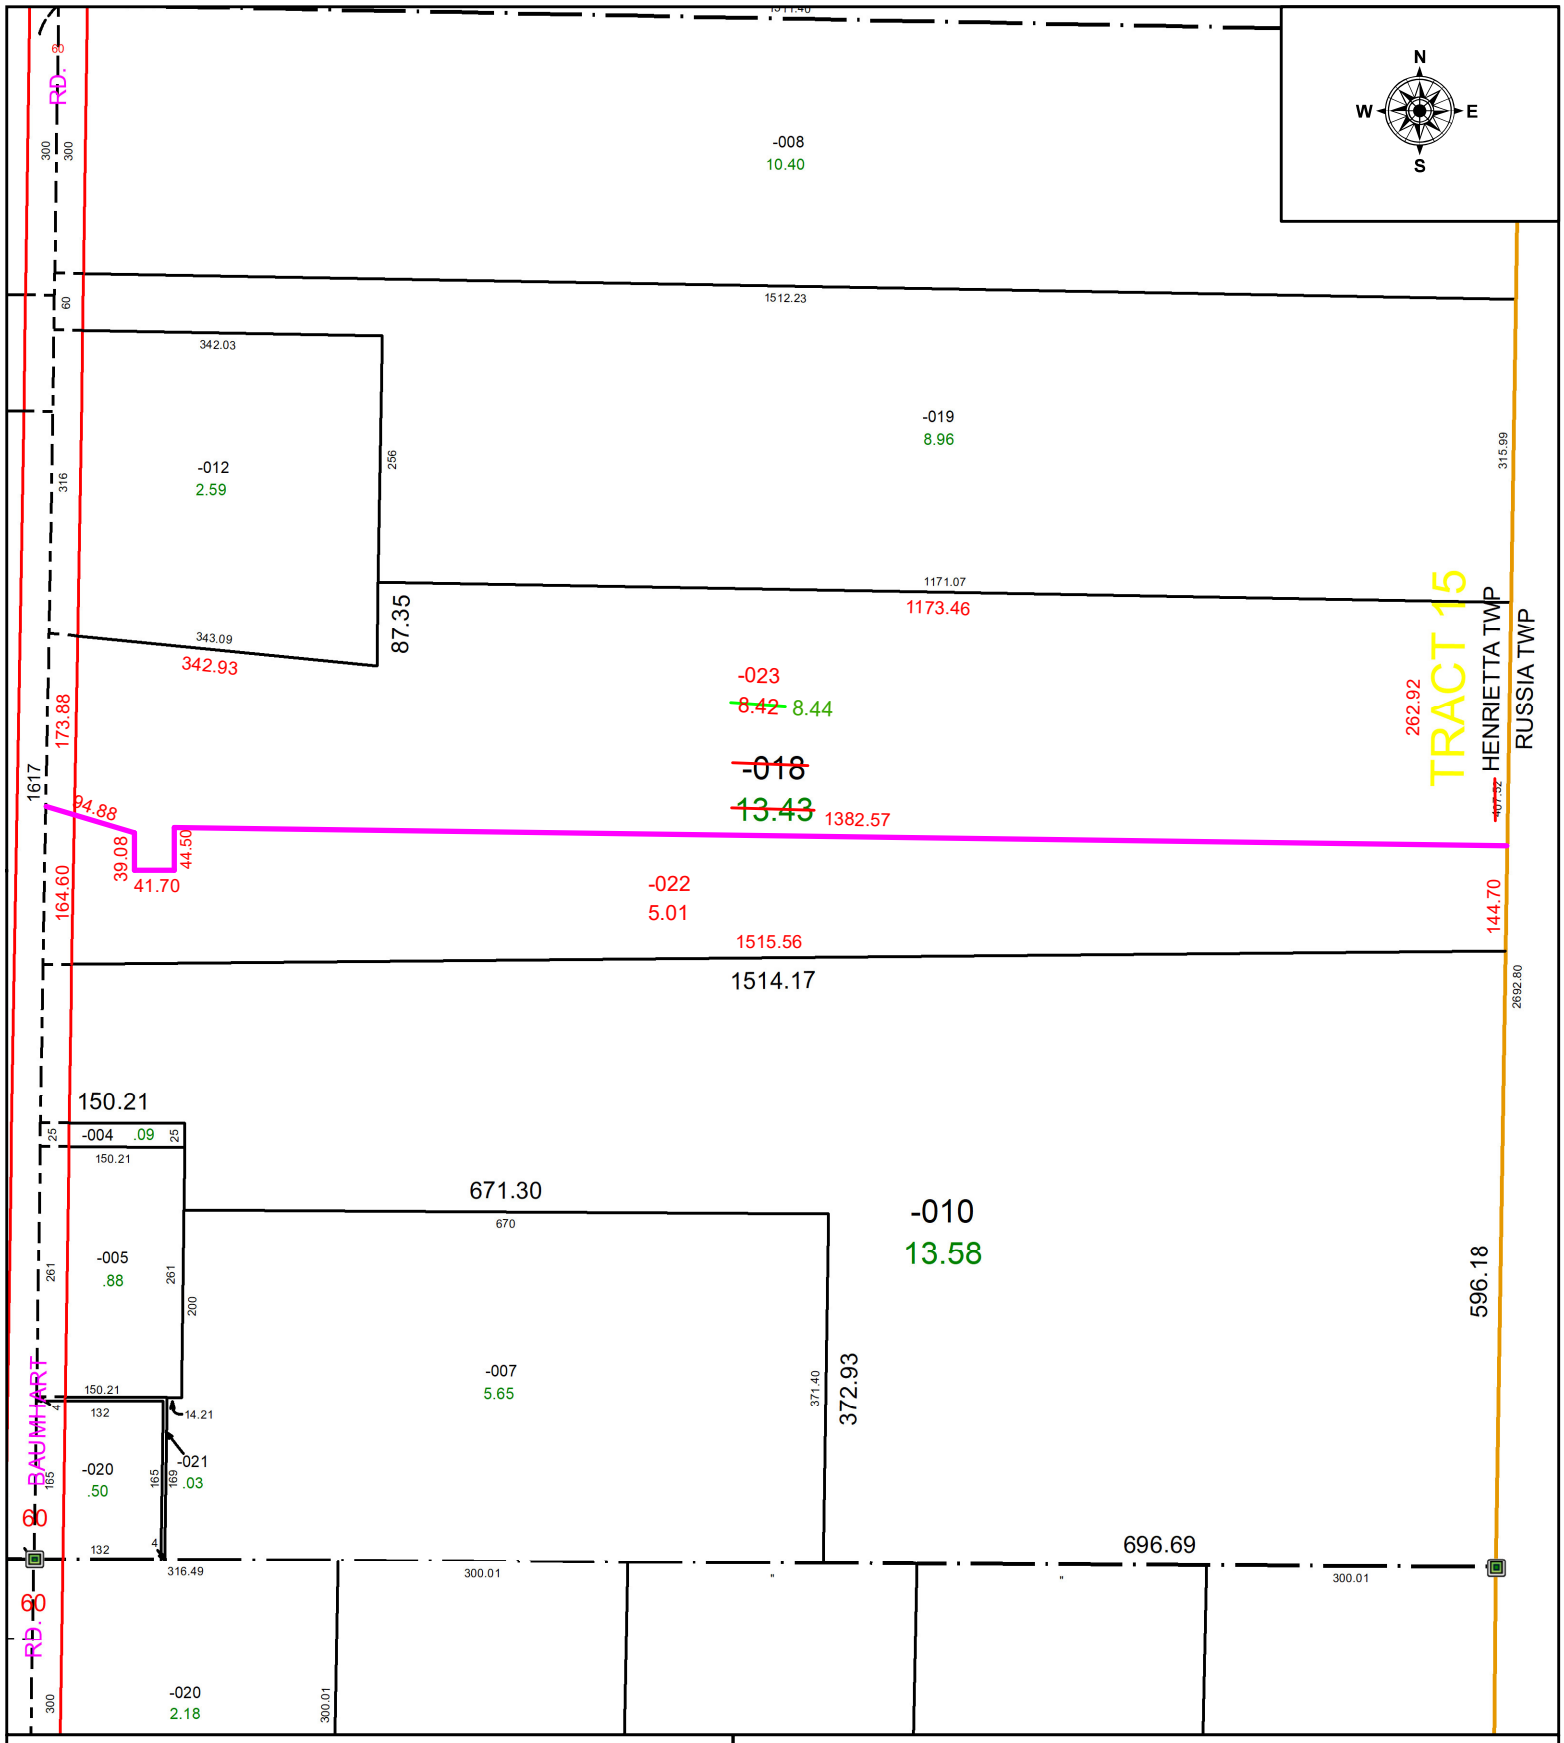

SPLITS/DEEDS PROCESSED

LORAIN COUNTY TAX MAP DEPARTMENT
226 MIDDLE AVE. ELYRIA, OH

SURVEYED BY: TIMOTHY HOZALSKI SURVEY # 50921

CLOSURE: 1: 371156

MAP PAGE(S): 08-15-006

APPOVED BY: WRZ **DATE:** 6/20/2023

SCALE: 1" = 200 **PRIOR INSTRUMENT:** #2006-0183249